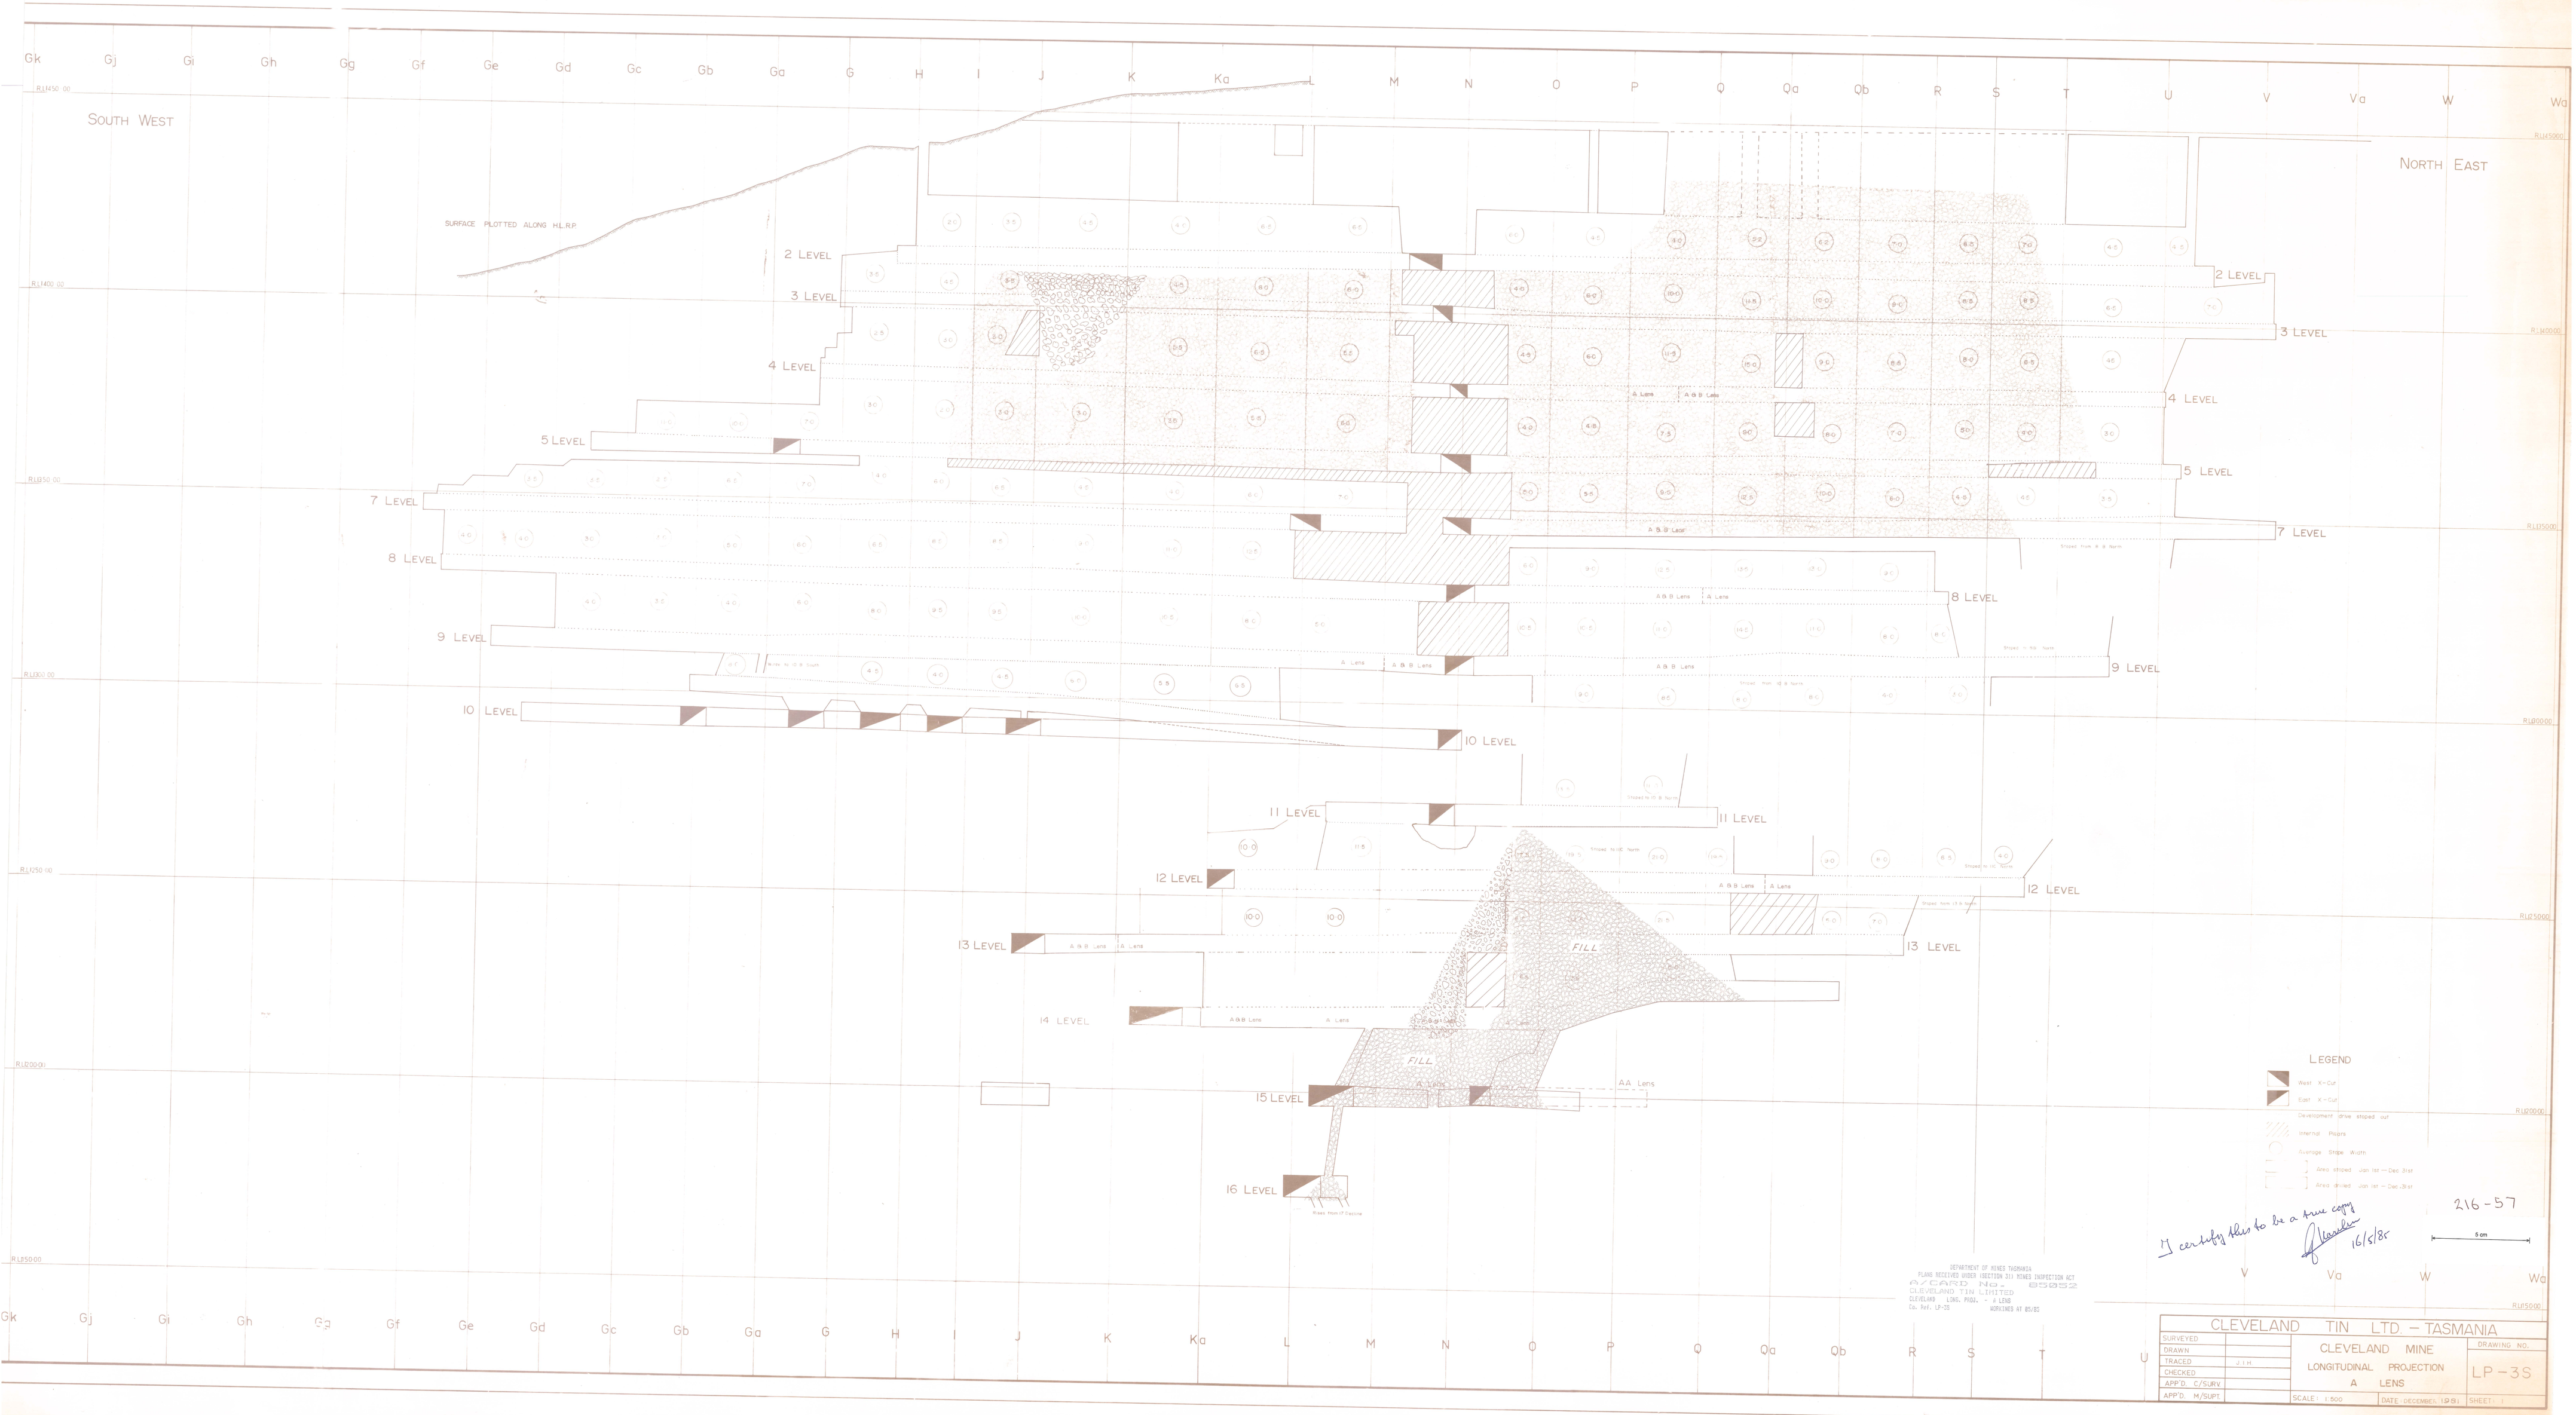
Gk Gj Gi Gh Gg Gf Ge Gd Gc Gb Ga G H I J K Ka L M N O P Q Qa Qb R S T U V Va W Wa
SOUTH WEST
NORTH EAST
SURFACE PLOTTED ALONG H.L.R.P.
2 LEVEL
3 LEVEL
4 LEVEL
5 LEVEL
7 LEVEL
8 LEVEL
9 LEVEL
10 LEVEL
11 LEVEL
12 LEVEL
13 LEVEL
14 LEVEL
15 LEVEL
16 LEVEL
FILL
FILL
A Lens
A & B Lens
AA Lens
LEGEND
West X-Cut
East X-Cut
Development drive stoped out
Internal Pillars
Average Stope Width
Area stoped Jan 1st – Dec 31st
Area drilled Jan 1st – Dec 31st
216-57
I certify this to be a true copy
16/5/85
5 cm
DEPARTMENT OF MINES TASMANIA
PLANS RECEIVED UNDER SECTION 311 MINES INSPECTION ACT
A/CARD No. 859852
CLEVELAND TIN LIMITED
CLEVELAND LONG. PROJ. - A LENS
Co. Ref. LP-3S
WORKINGS AT 85/85
CLEVELAND TIN LTD. – TASMANIA
SURVEYED
DRAWN
TRACED J.I.H.
CHECKED
APP'D. C/SURV.
APP'D. M/SUPT.
CLEVELAND MINE
LONGITUDINAL PROJECTION
A LENS
DRAWING NO.
LP-3S
SCALE: 1:500
DATE: DECEMBER 1981
SHEET: 1