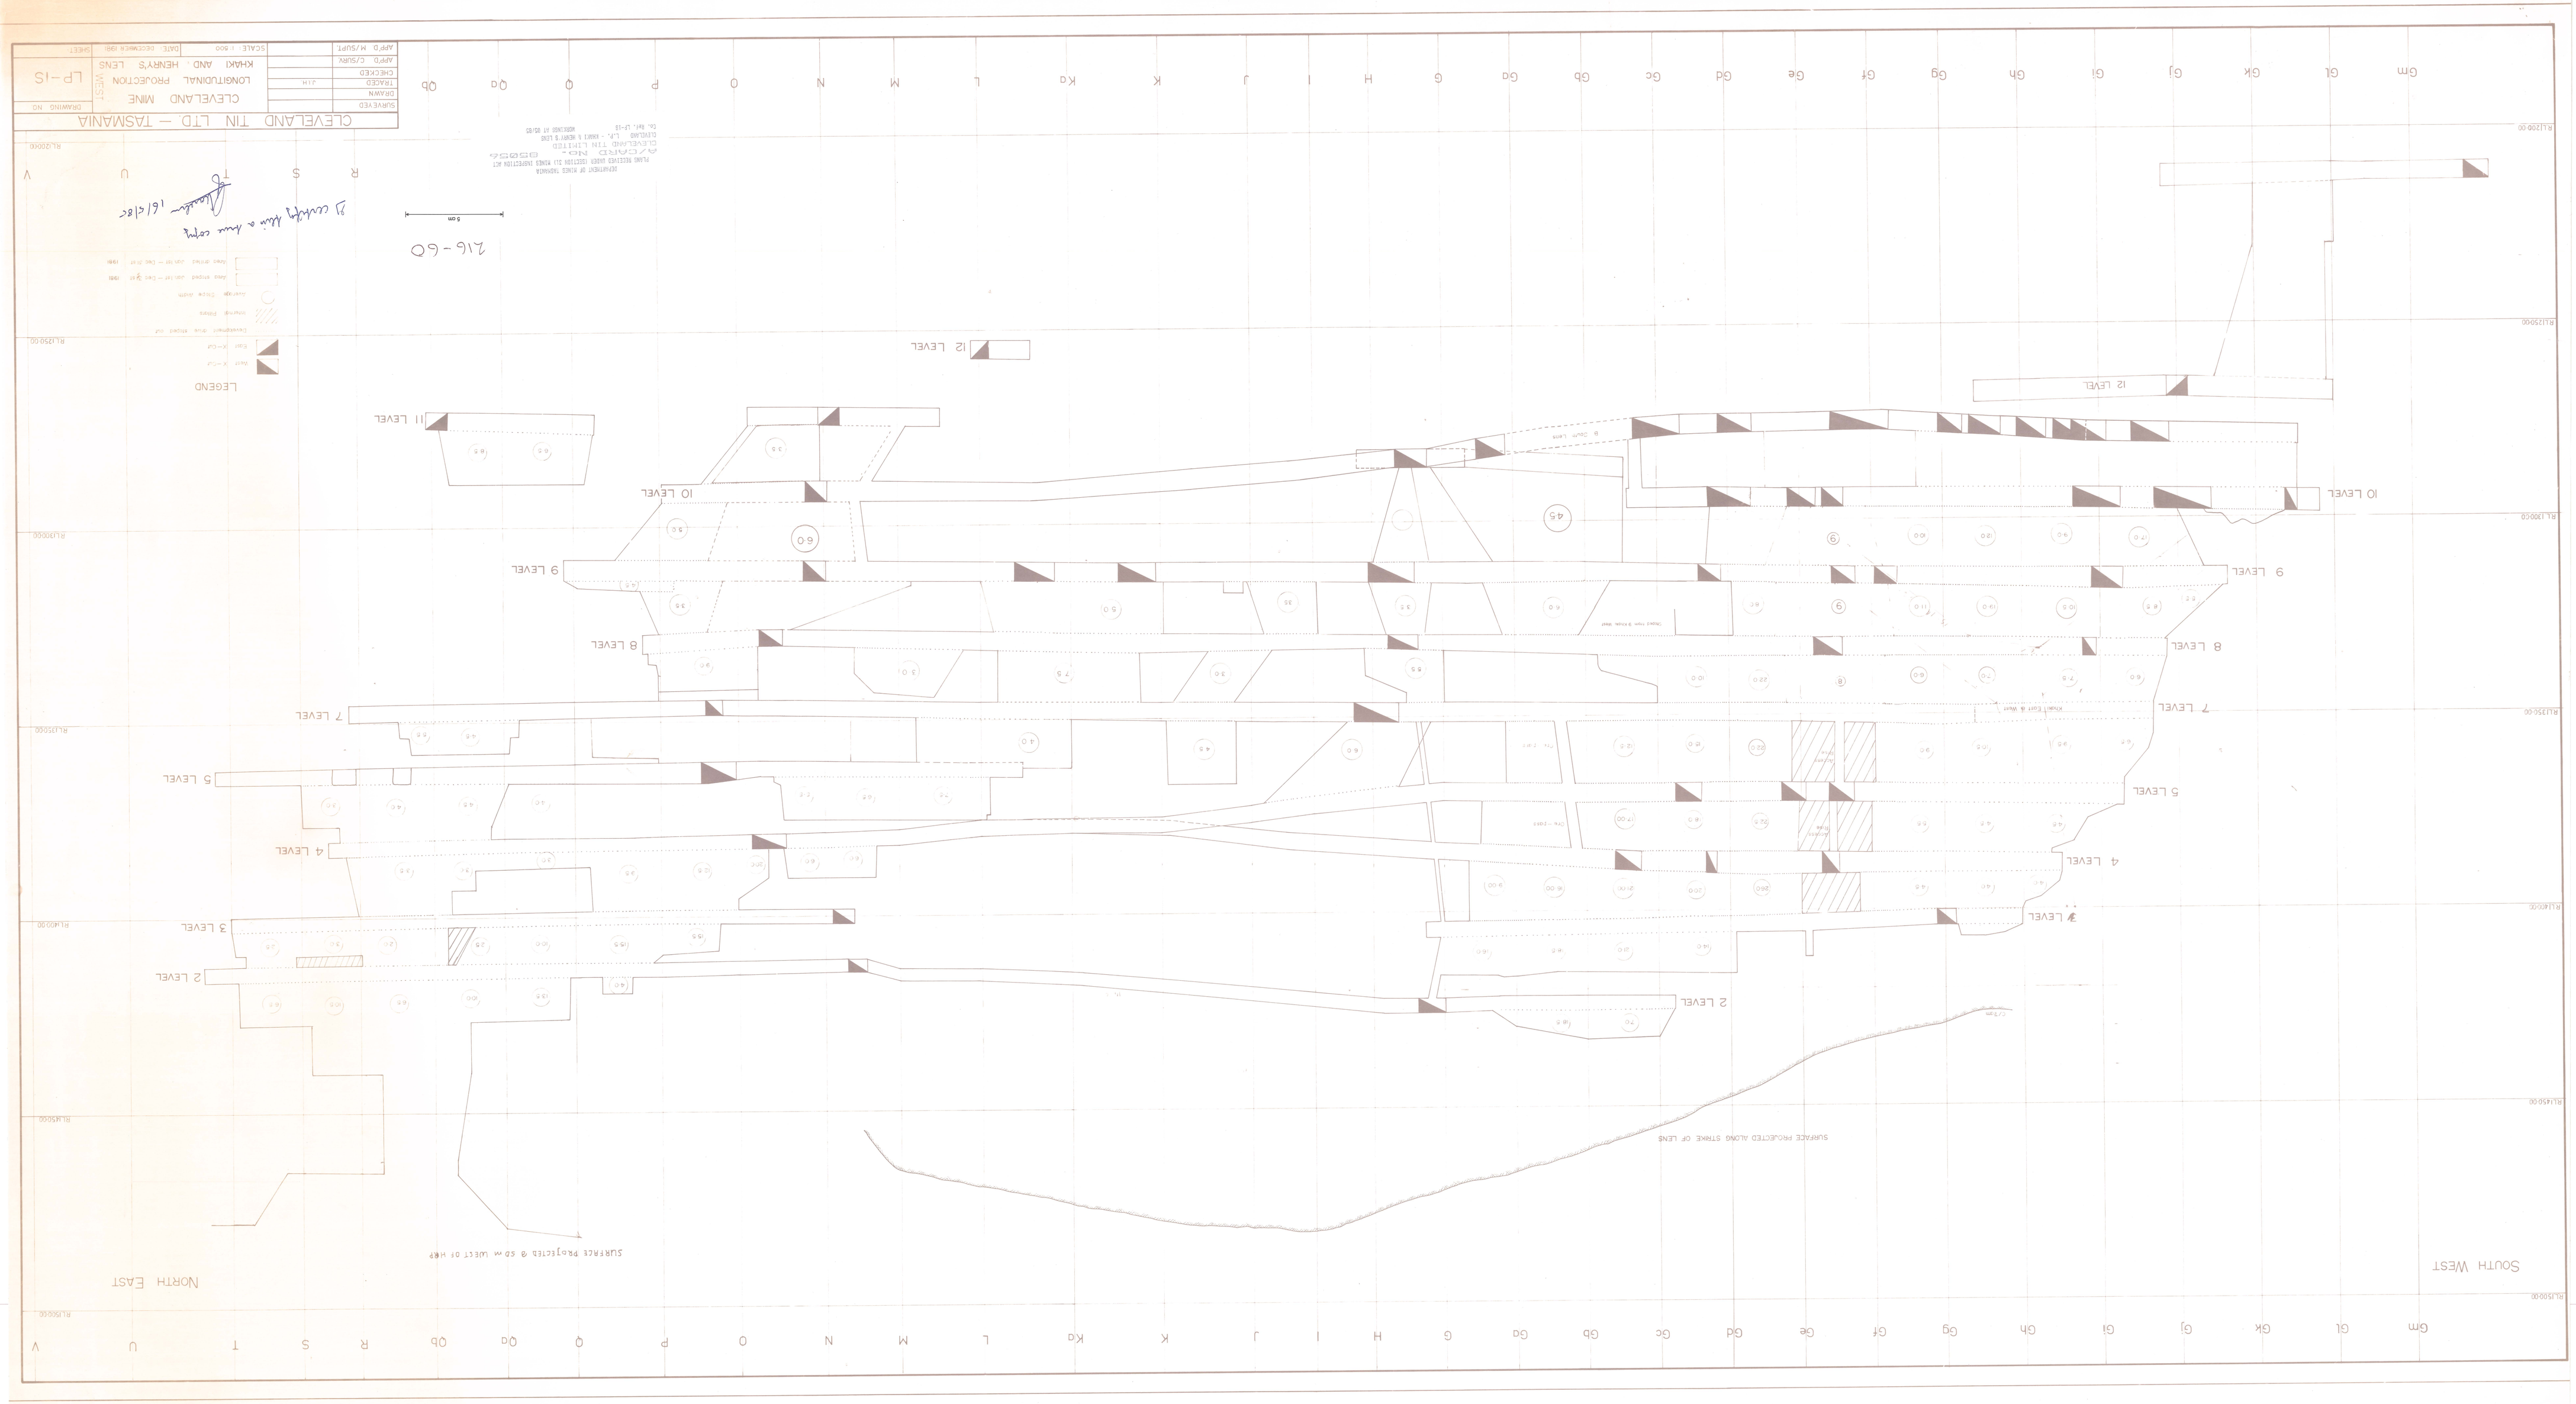
CLEVELAND TIN LTD — TASMANIA
CLEVELAND MINE
LONGITUDINAL PROJECTION
KHAKI AND HENRY'S LENS
LP-1S
SCALE 1:500
DATE DECEMBER 90
APP'D M/SUTT
APP'D C/SUBV
CHECKED
TRACED
DRAWN
SURVEYED
DRAWING NO
SHEET
SOUTH WEST
NORTH EAST
SURFACE PROJECTED ALONG STRIKE OF LENS
SURFACE PROJECTED @ 50m WEST OF HWY
2 LEVEL
3 LEVEL
4 LEVEL
5 LEVEL
7 LEVEL
8 LEVEL
9 LEVEL
10 LEVEL
11 LEVEL
12 LEVEL
LEGEND
216-60
5 0m
DEPARTMENT OF MINES TASMANIA
PLANS REQUIRED UNDER SECTION 32 MINES INSPECTION ACT
A/CONTRD No:- 830526
CLEVELAND TIN LIMITED
CLEVELAND L.P. - KHAKI & HENRY'S LENS
Co. Ref: LP-1S MORTIMER AT 2S/8S
16/6/86