

E10 600

N15 350

E10 650

N15 300


E10 700

HALL'S LONGITUDINAL REFERENCE PLANE BEARING 42° 16' 25"

ZK02

12L Khaki
Scale 1:500

216-61

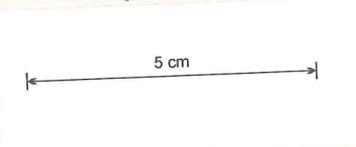

I certify this to be a correct copy -

[Signature]
16/5/85

DEPARTMENT OF MINES TASMANIA
PLANS RECEIVED UNDER (SECTION 31) MINES INSPECTION ACT
A/CARD No. 85048
CLEVELAND TIN LIMITED
CLEVELAND LEVEL 12 - KHAKI
Co. Ref. WORKINGS AT 05/85

12L KH