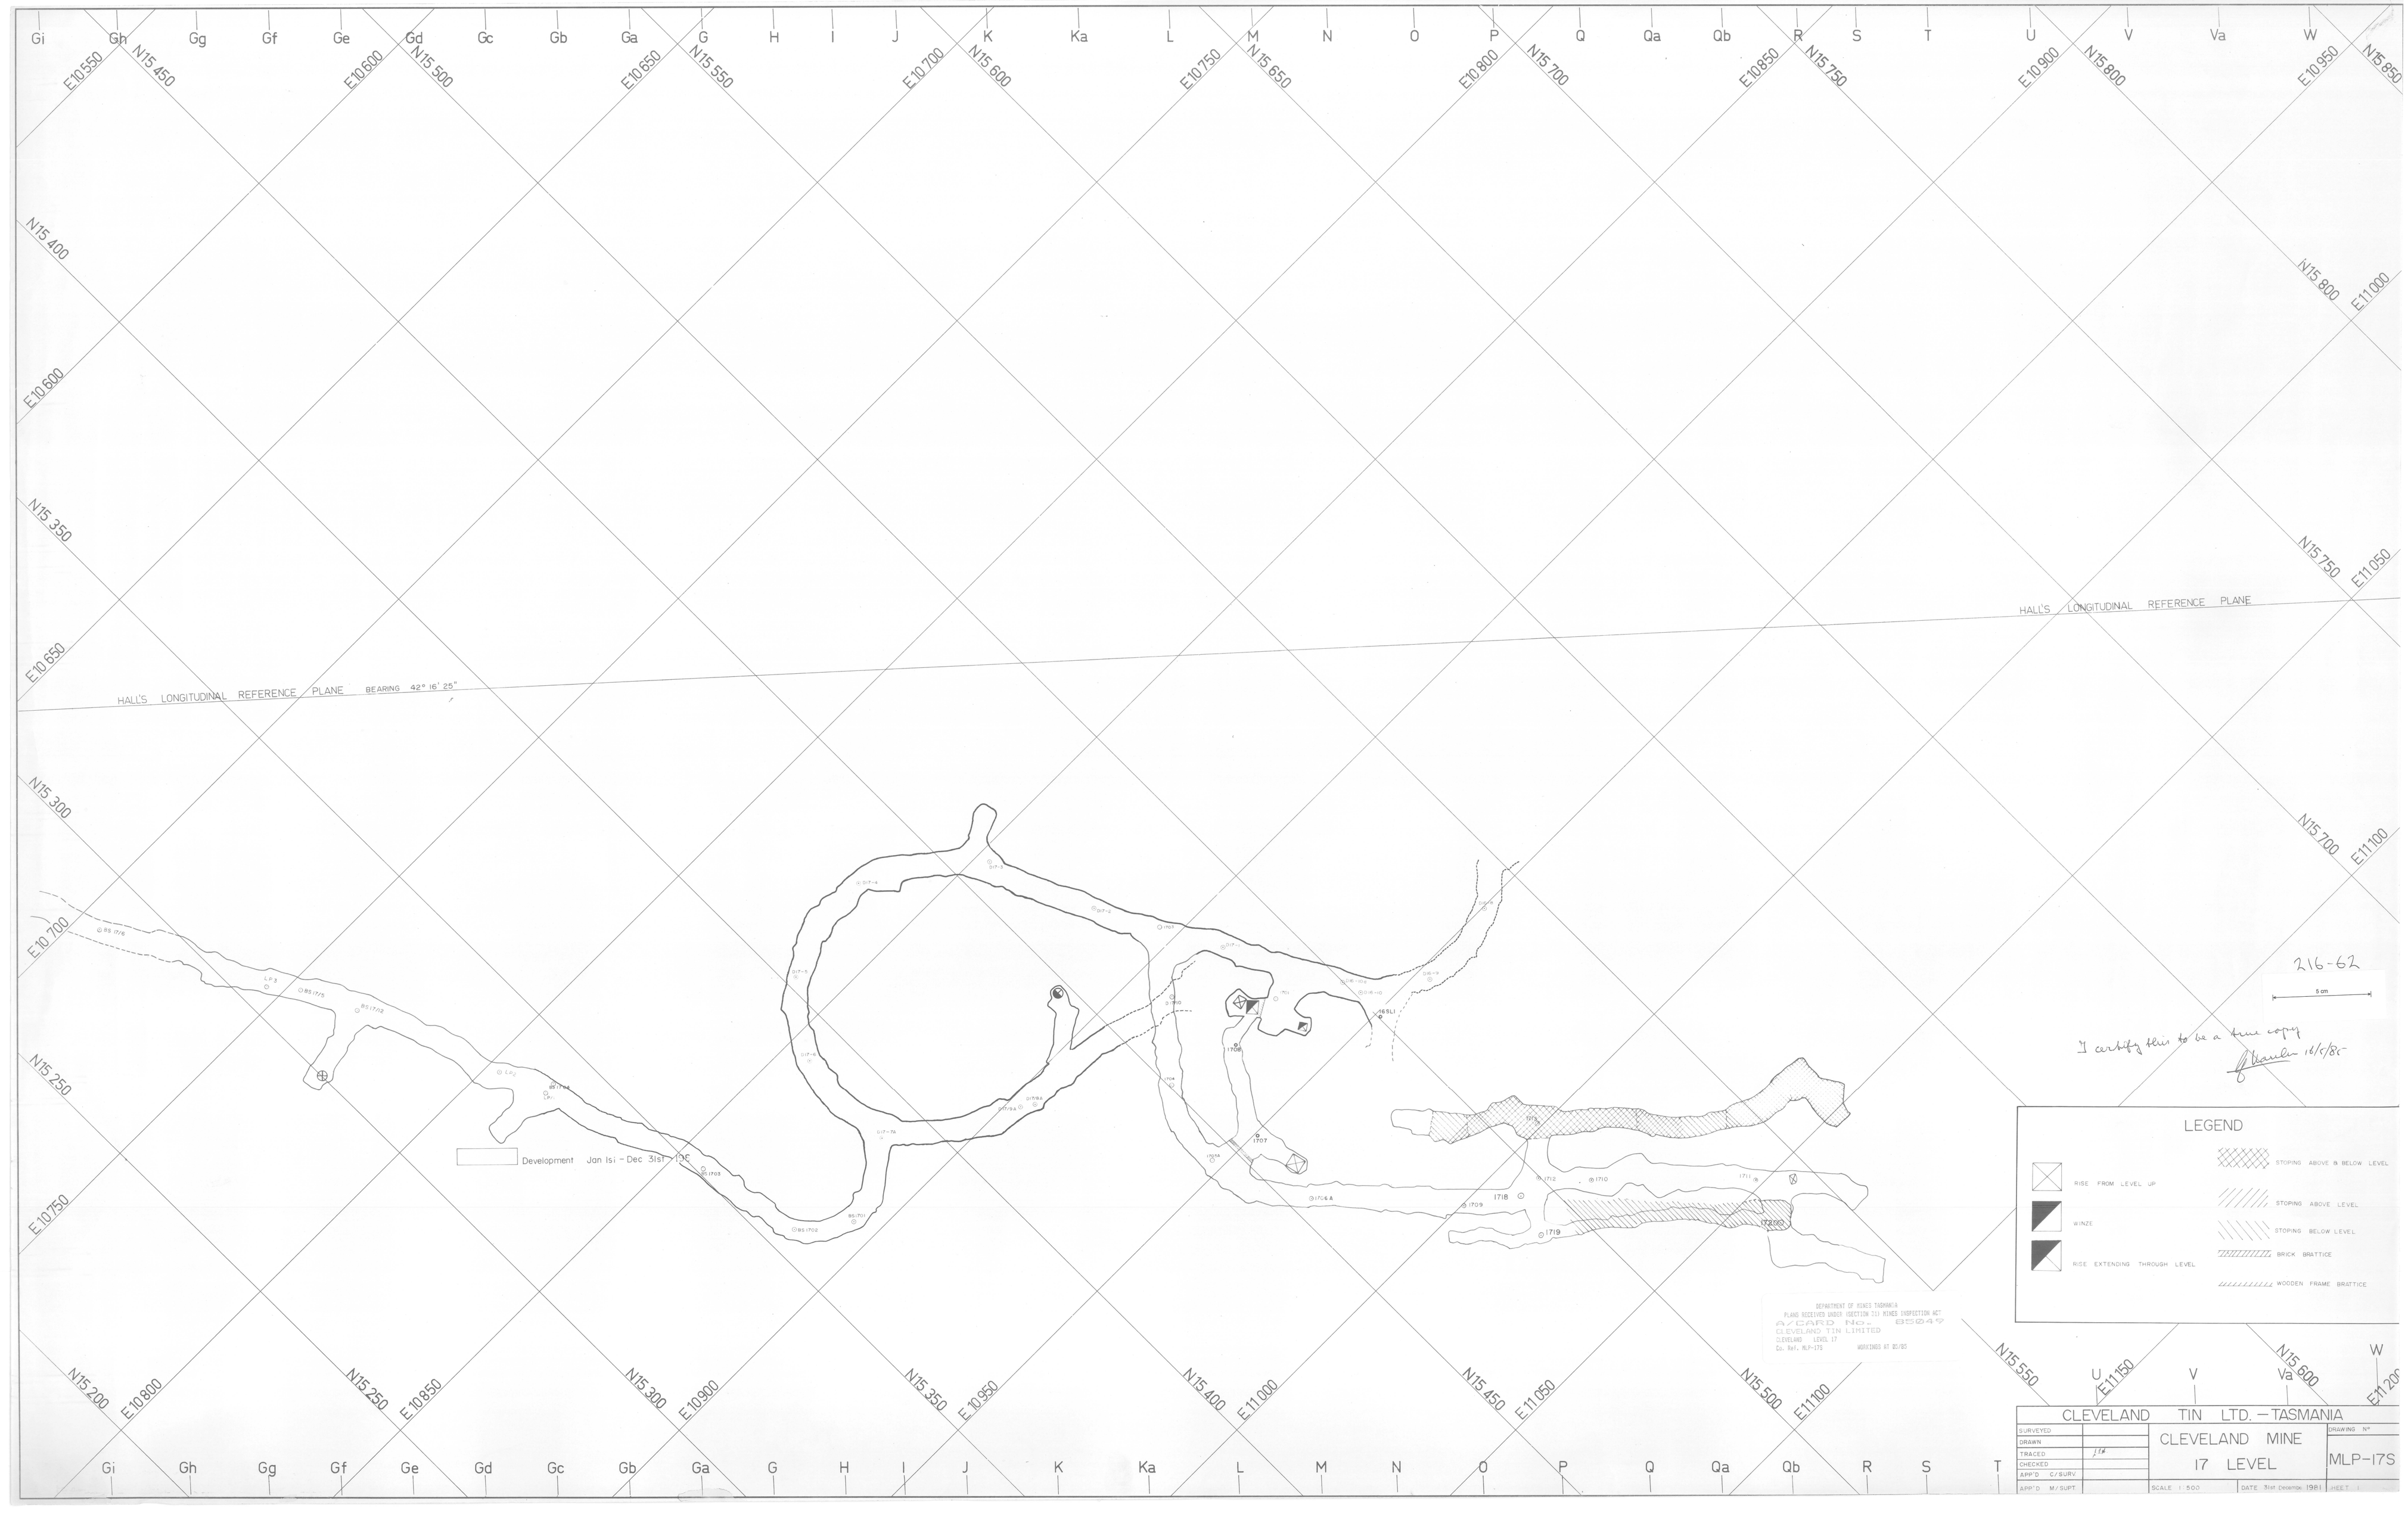
Gi Gh Gg Gf Ge Gd Gc Gb Ga G H I J K Ka L M N O P Q Qa Qb R S T U V Va W
E10 550 N15 450 E10 600 N15 500 E10 650 N15 550 E10 700 N15 600 E10 750 N15 650 E10 800 N15 700 E10 850 N15 750 E10 900 N15 800 E10 950 N15 850
N15 400 E10 600 N15 350 E10 650
N15 800 E11 000
N15 750 E11 050
HALL'S LONGITUDINAL REFERENCE PLANE
HALL'S LONGITUDINAL REFERENCE PLANE BEARING 42° 16' 25"
N15 300 E10 700 N15 250 E10 750
N15 700 E11 100
Development Jan 1st - Dec 31st 19
1703
1707
1708
1709
1710
1711
1712
1718
1719
1720
216-62
5 cm
I certify this to be a true copy
16/1/85
LEGEND
RISE FROM LEVEL UP
WINZE
RISE EXTENDING THROUGH LEVEL
STOPING ABOVE & BELOW LEVEL
STOPING ABOVE LEVEL
STOPING BELOW LEVEL
BRICK BRATTICE
WOODEN FRAME BRATTICE
DEPARTMENT OF MINES TASMANIA
PLANS RECEIVED UNDER (SECTION 21) MINES INSPECTION ACT.
A/CARD No. 8564
CLEVELAND TIN LIMITED
CLEVELAND LEVEL 17
Co. Ref. MLP-17S
WORKINGS AT 85/85
N15 200 E10 800 N15 250 E10 850 N15 300 E10 900 N15 350 E10 950 N15 400 E11 000 N15 450 E11 050 N15 500 E11 100 N15 550 E11 150 N15 600 E11 200
U V Va W
Gi Gh Gg Gf Ge Gd Gc Gb Ga G H I J K Ka L M N O P Q Qa Qb R S T
CLEVELAND TIN LTD. — TASMANIA
SURVEYED
DRAWN
TRACED
CHECKED
APP'D C/SURV.
APP'D M/SUPT.
CLEVELAND MINE
17 LEVEL
DRAWING Nº
MLP-17S
SCALE 1:500
DATE 31st Decemb. 1981
SHEET 1