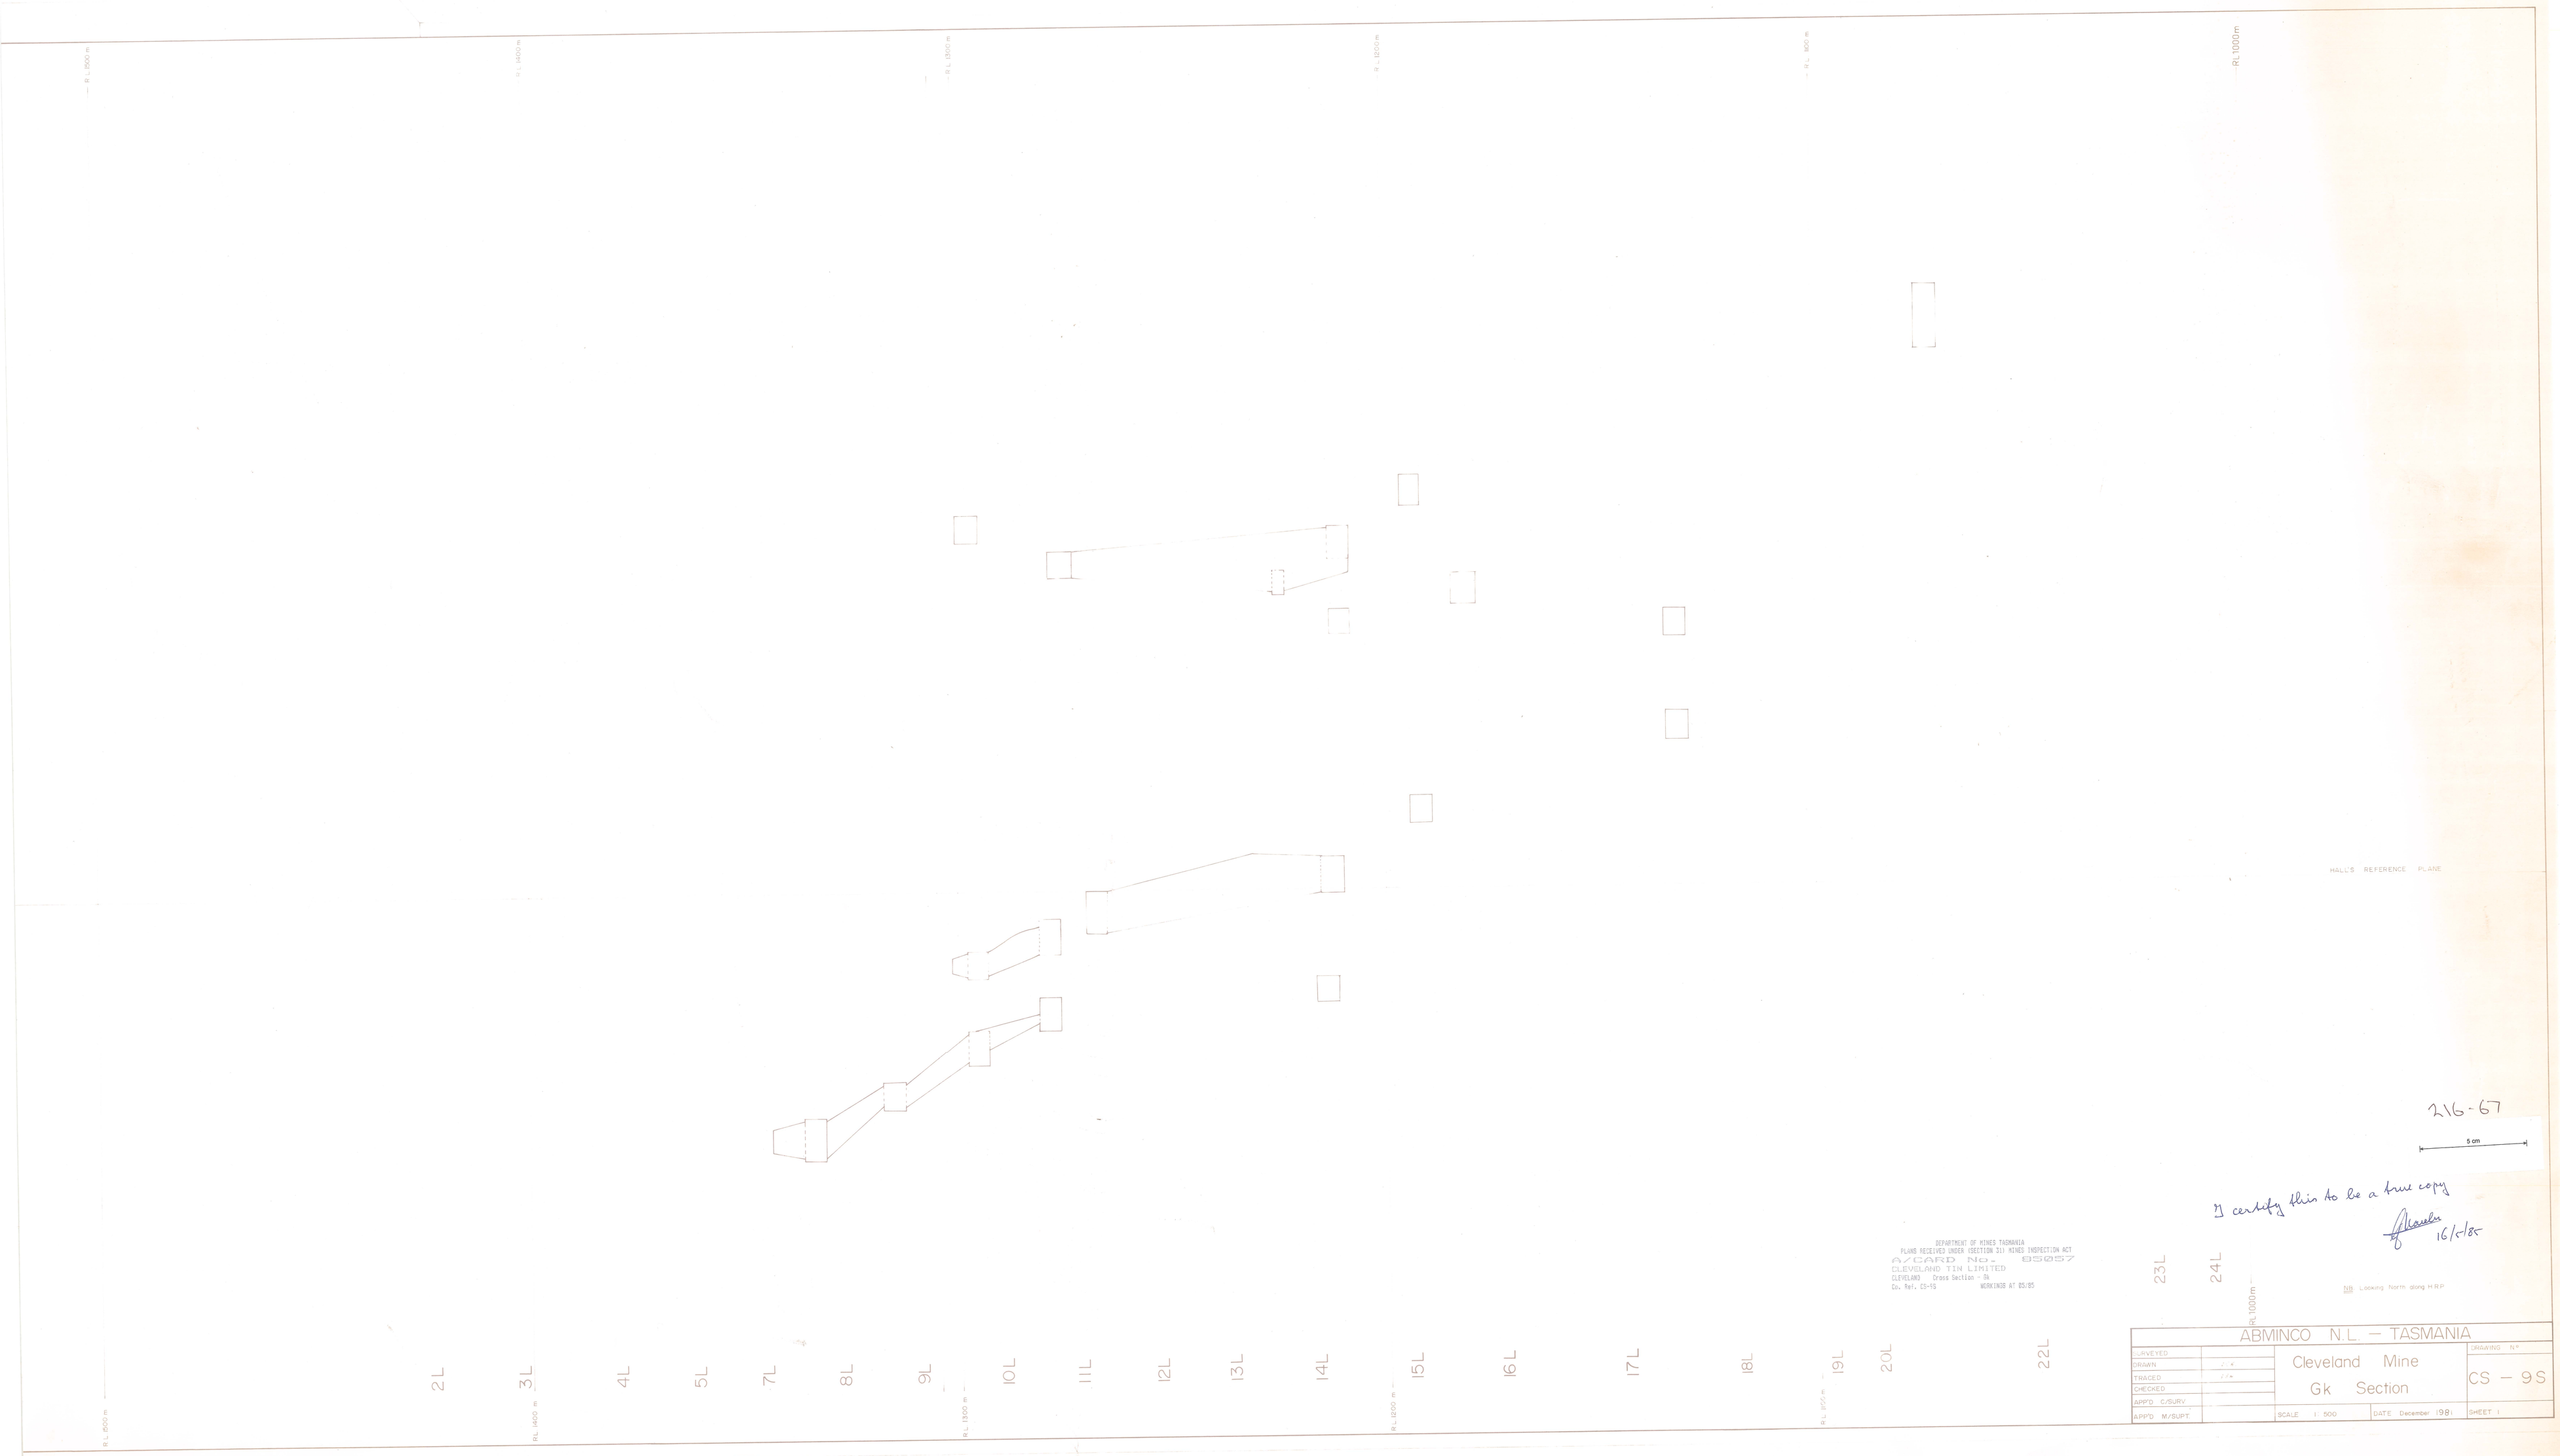
R.L. 1500 m
R.L. 1400 m
R.L. 1350 m
R.L. 1300 m
R.L. 1200 m
R.L. 1100 m
R.L. 1000 m
2L
3L
4L
5L
7L
8L
9L
10L
11L
12L
13L
14L
15L
16L
17L
18L
19L
20L
22L
23L
24L
HALL'S REFERENCE PLANE
DEPARTMENT OF MINES TASMANIA
PLANS RECEIVED UNDER (SECTION 31) MINES INSPECTION ACT
ON CARD No. 8597
CLEVELAND TIN LIMITED
CLEVELAND Cross Section - Gk
Co. Ref. CS-19 WORKING AT 85/85
216-67
5 cm
I certify this to be a true copy
16/1/85
NB: Looking North along H.R.P.
ABMINCO N.L. — TASMANIA
SURVEYED
DRAWN
TRACED
CHECKED
APP'D C/SURV.
APP'D M/SUPT.
Cleveland Mine
Gk Section
DRAWING No.
CS — 9S
SCALE 1:500
DATE December 1981
SHEET 1