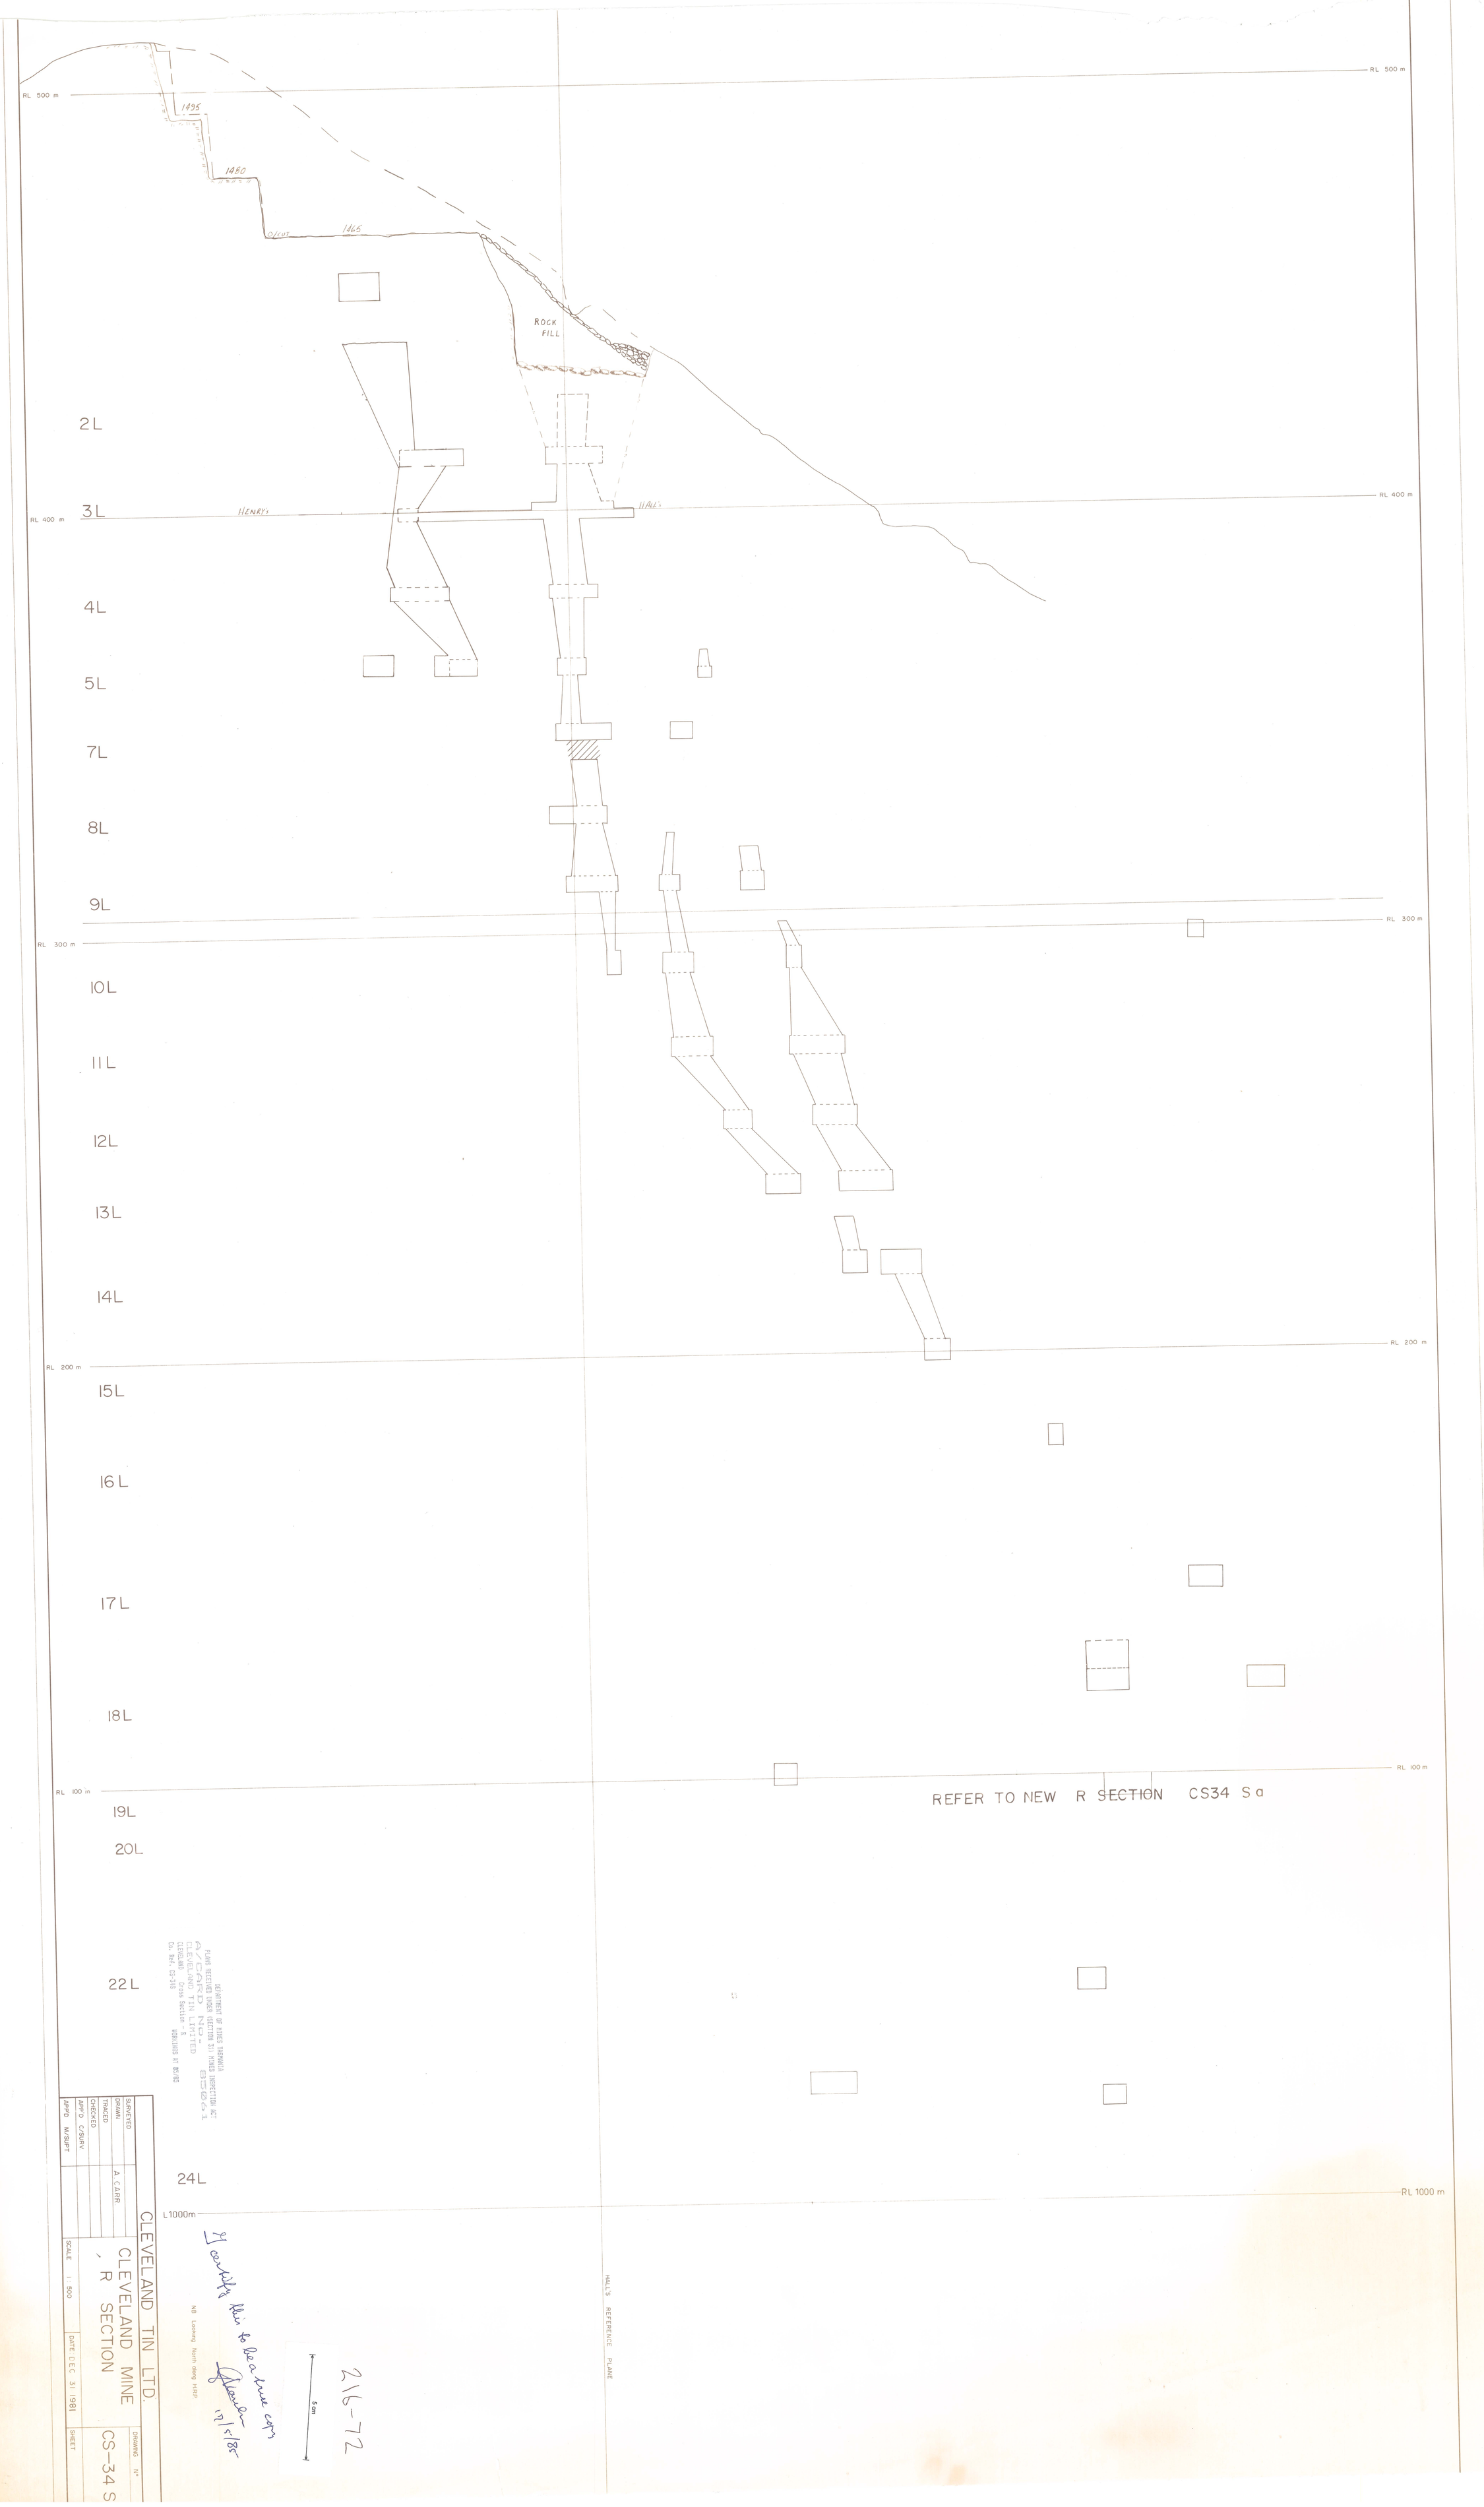
RL 500 m
1495
1480
O/CUT
1465
ROCK FILL
2L
3L
HENRY'S
HALL'S
RL 400 m
4L
5L
7L
8L
9L
RL 300 m
10L
11L
12L
13L
14L
RL 200 m
15L
16L
17L
18L
RL 100 m
REFER TO NEW R SECTION CS34 Sa
19L
20L
22L
24L
L1000m
RL 1000 m
HALL'S REFERENCE PLANE
5 cm
216-72
I certify this to be a true copy
17/5/82
NB Looking North along H.R.P.
PLANS RECEIVED UNDER (SECTION 31) MINES INSPECTION ACT
AYCARD NO. 8504
CLEVELAND TIN LIMITED
CLEVELAND "Cross Section" R
Co. Ref. CS-34S WORKINGS AT 8M/8S
DEPARTMENT OF MINES TASMANIA
CLEVELAND TIN LTD.
CLEVELAND MINE
R SECTION
SURVEYED
DRAWN A. CARR.
TRACED
CHECKED
APP'D C/SURV.
APP'D M/SUPT
SCALE 1:500
DATE DEC 31 1981
DRAWING N° CS-34 S
SHEET