


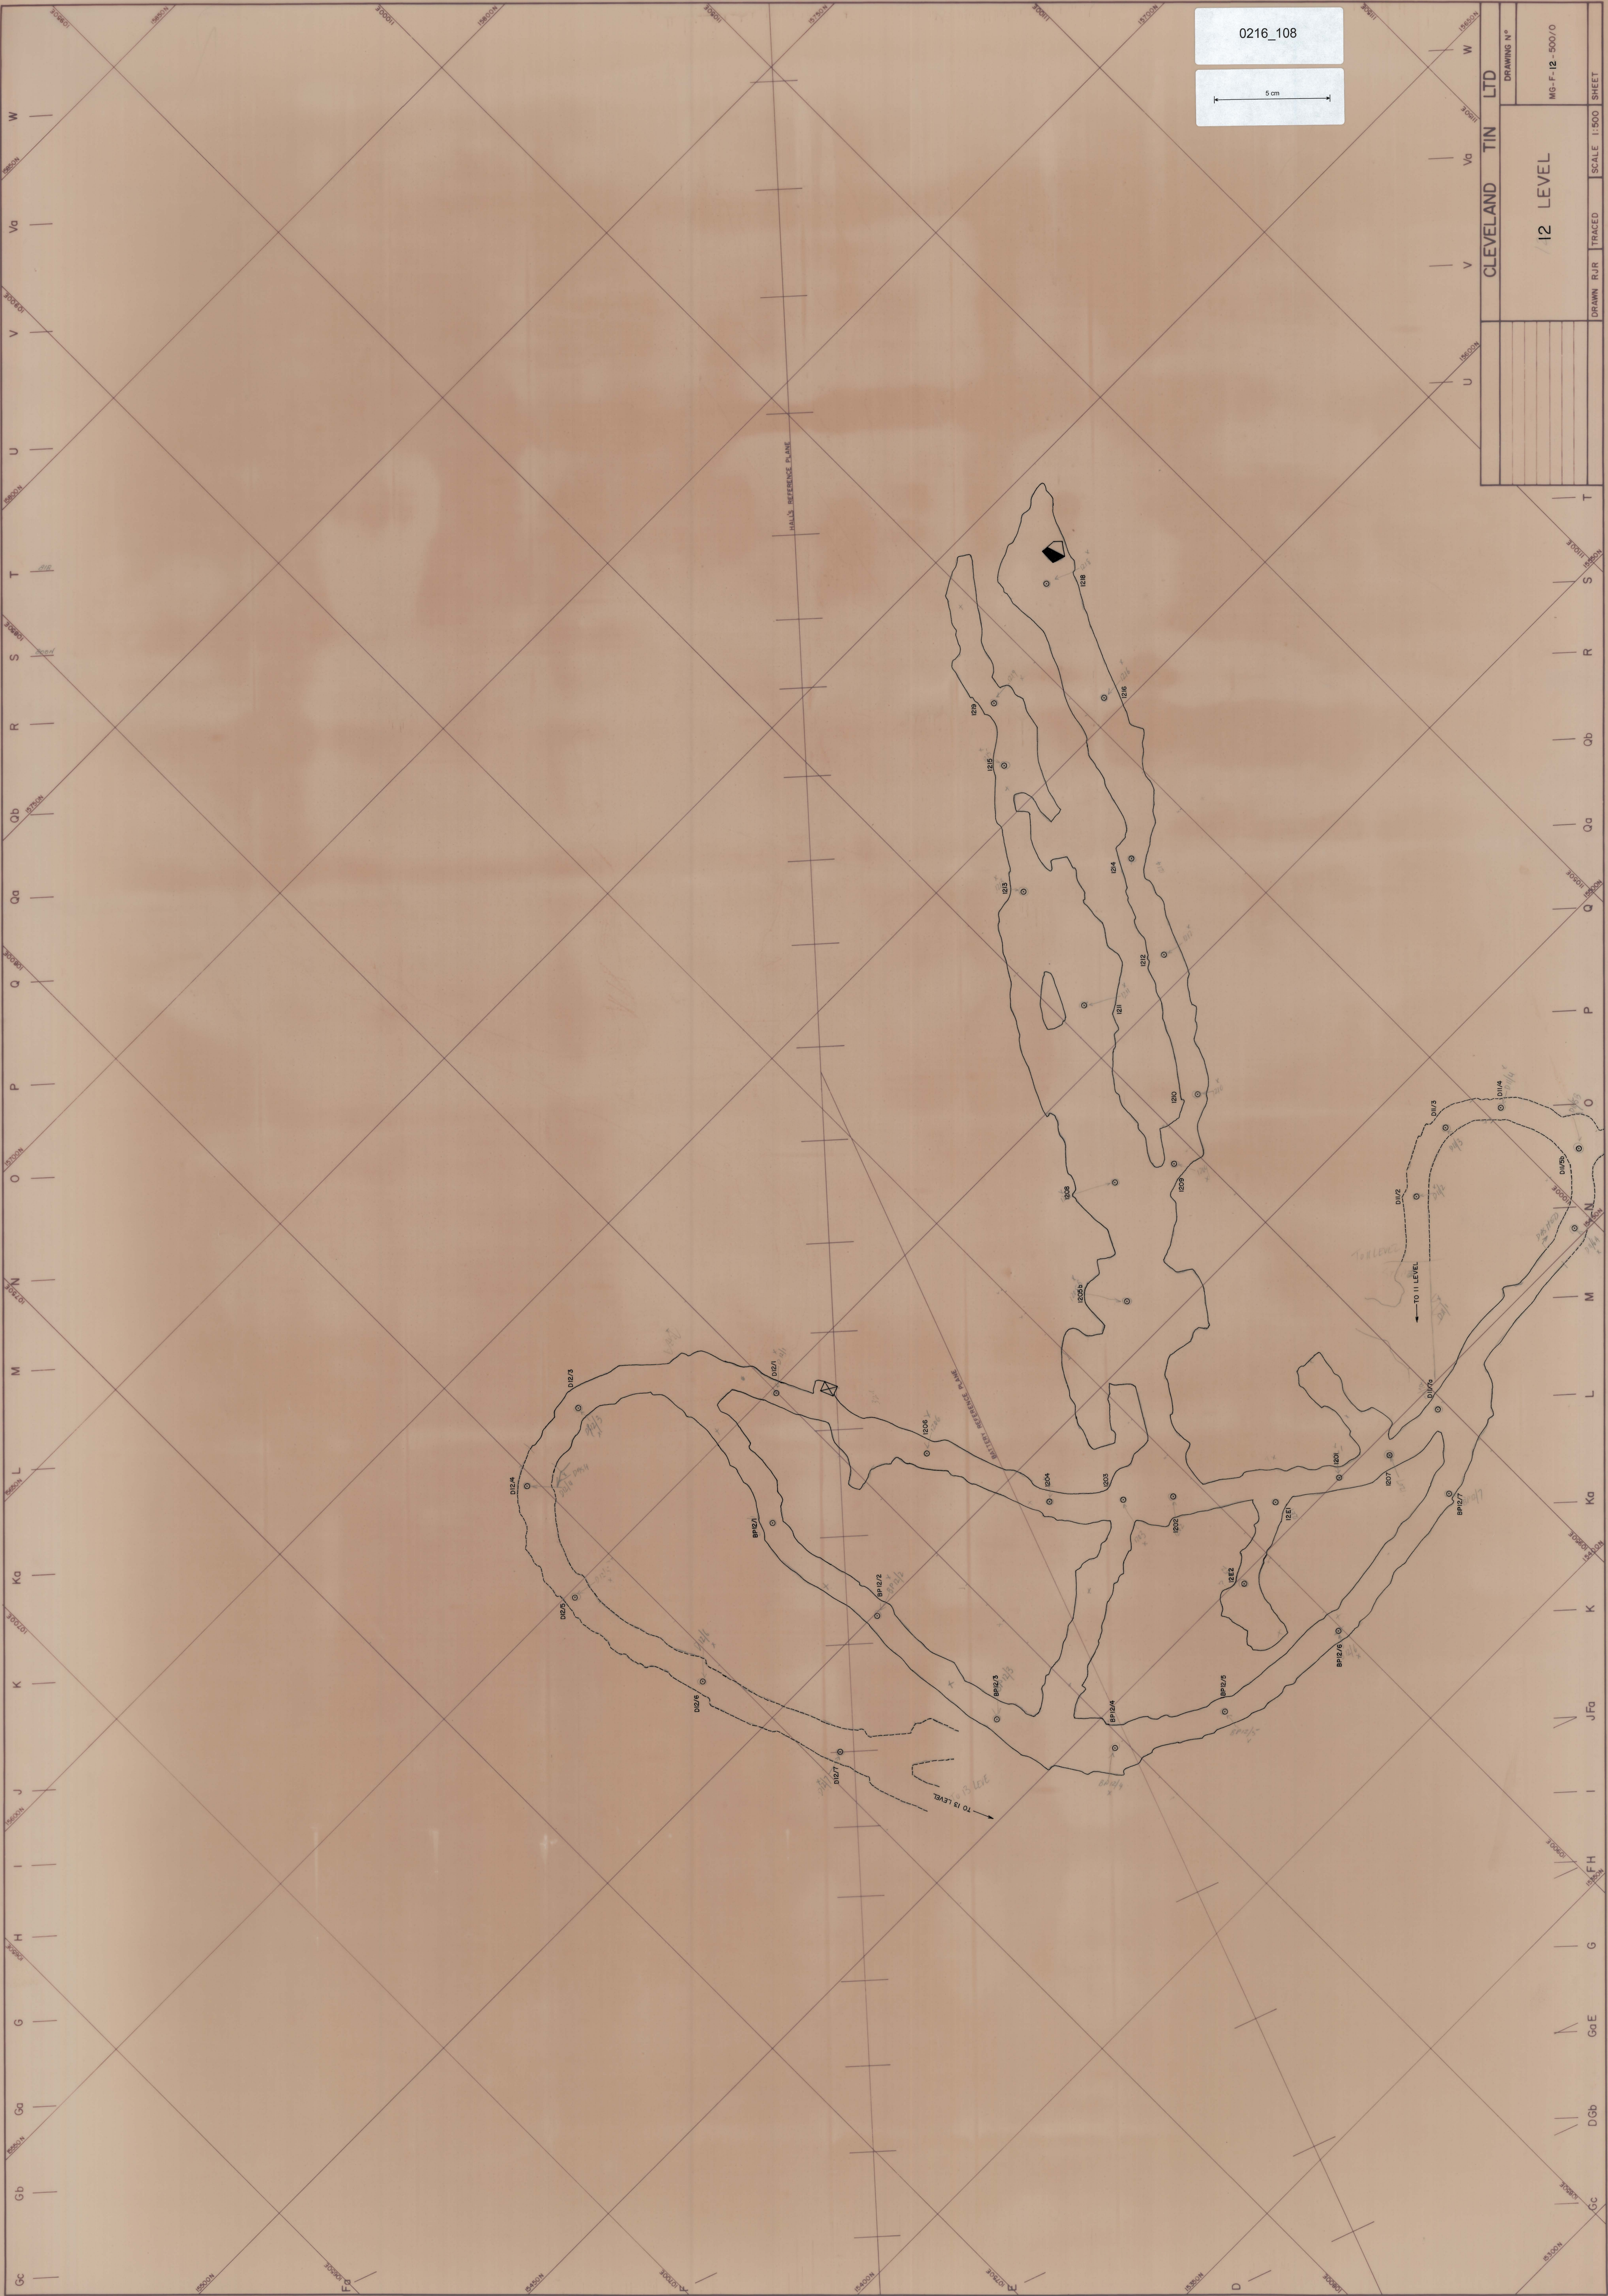

0216_108

5 cm

CLEVELAND TIN LTD	
DRAWING N°	
MG-F-12-500/O	
12 LEVEL	
DRAWN RJR	
TRACED	
SCALE 1:500	
SHEET	