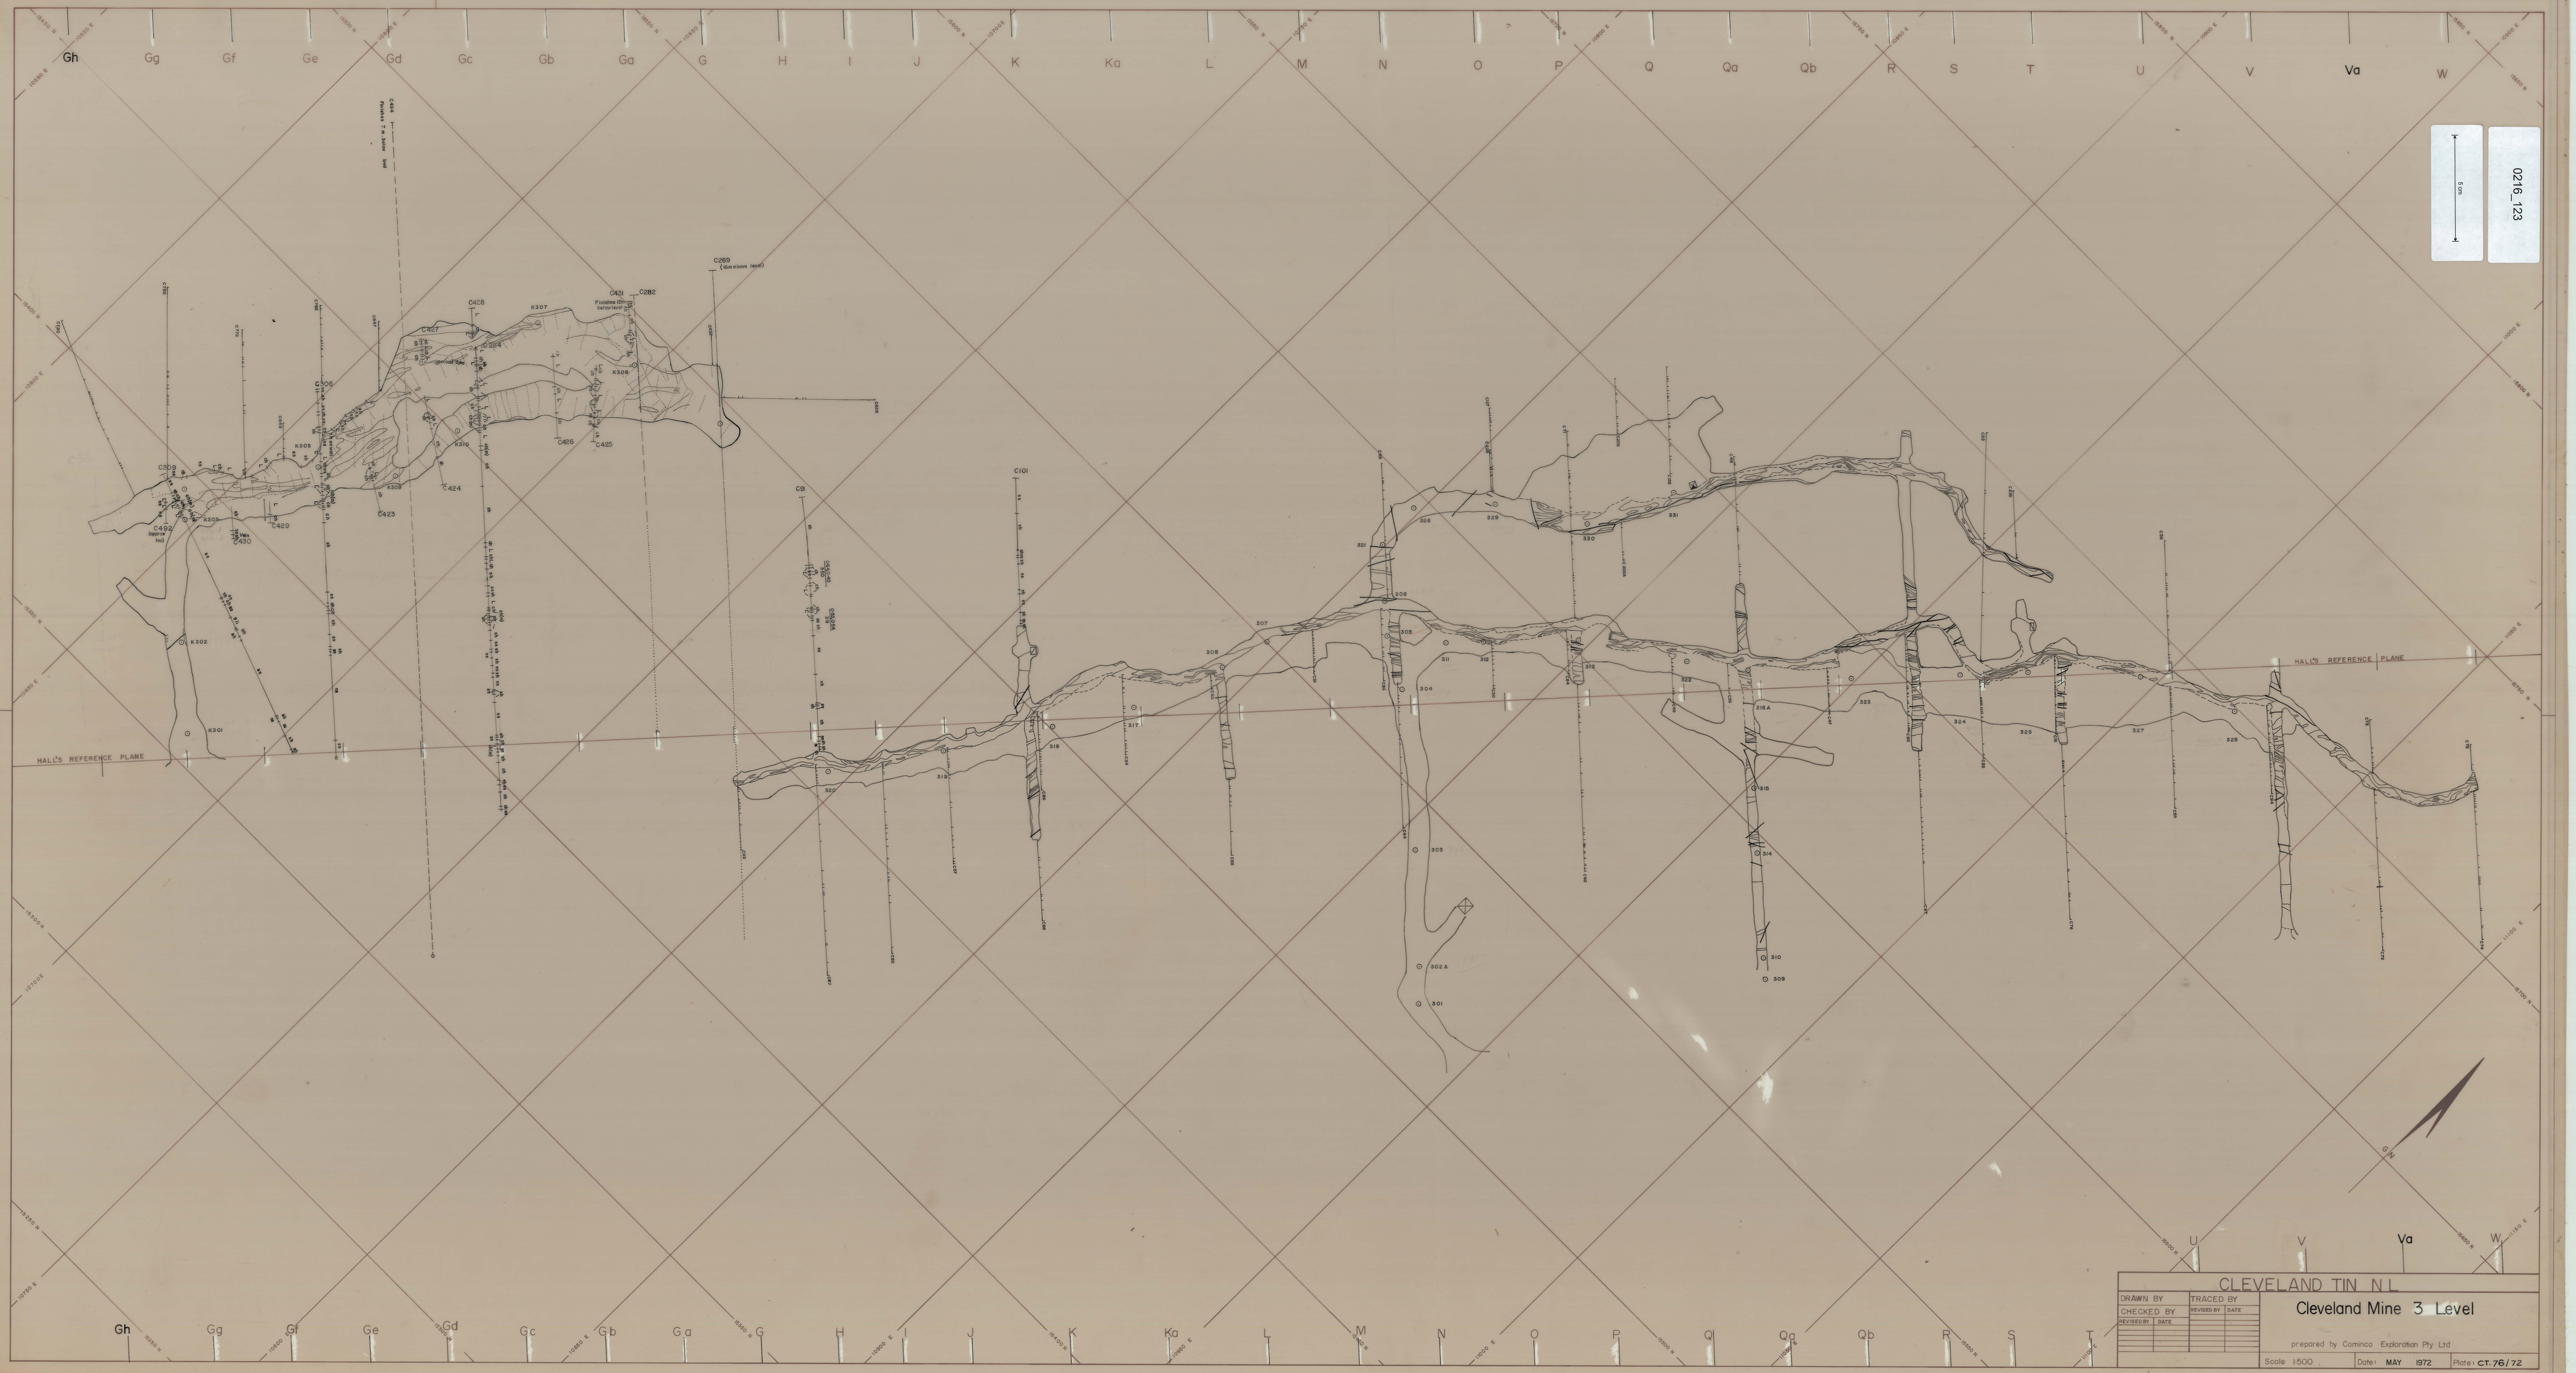
Gh Gg Gf Ge Gd Gc Gb Ga G H I J K Ka L M N O P Q Qa Qb R S T U V Va W
HALL'S REFERENCE PLANE
C269 (Blackbone level)
C428 Fossilised tree
C431 Fossilised tree below level
C444 Fossilised Tree below level
C101
C101A
K302
K301
K307
K306
K305
K310
K308
C424
C423
C425
C426
C429
C430
C408
C407
C409
C409A
C409B
C409C
