



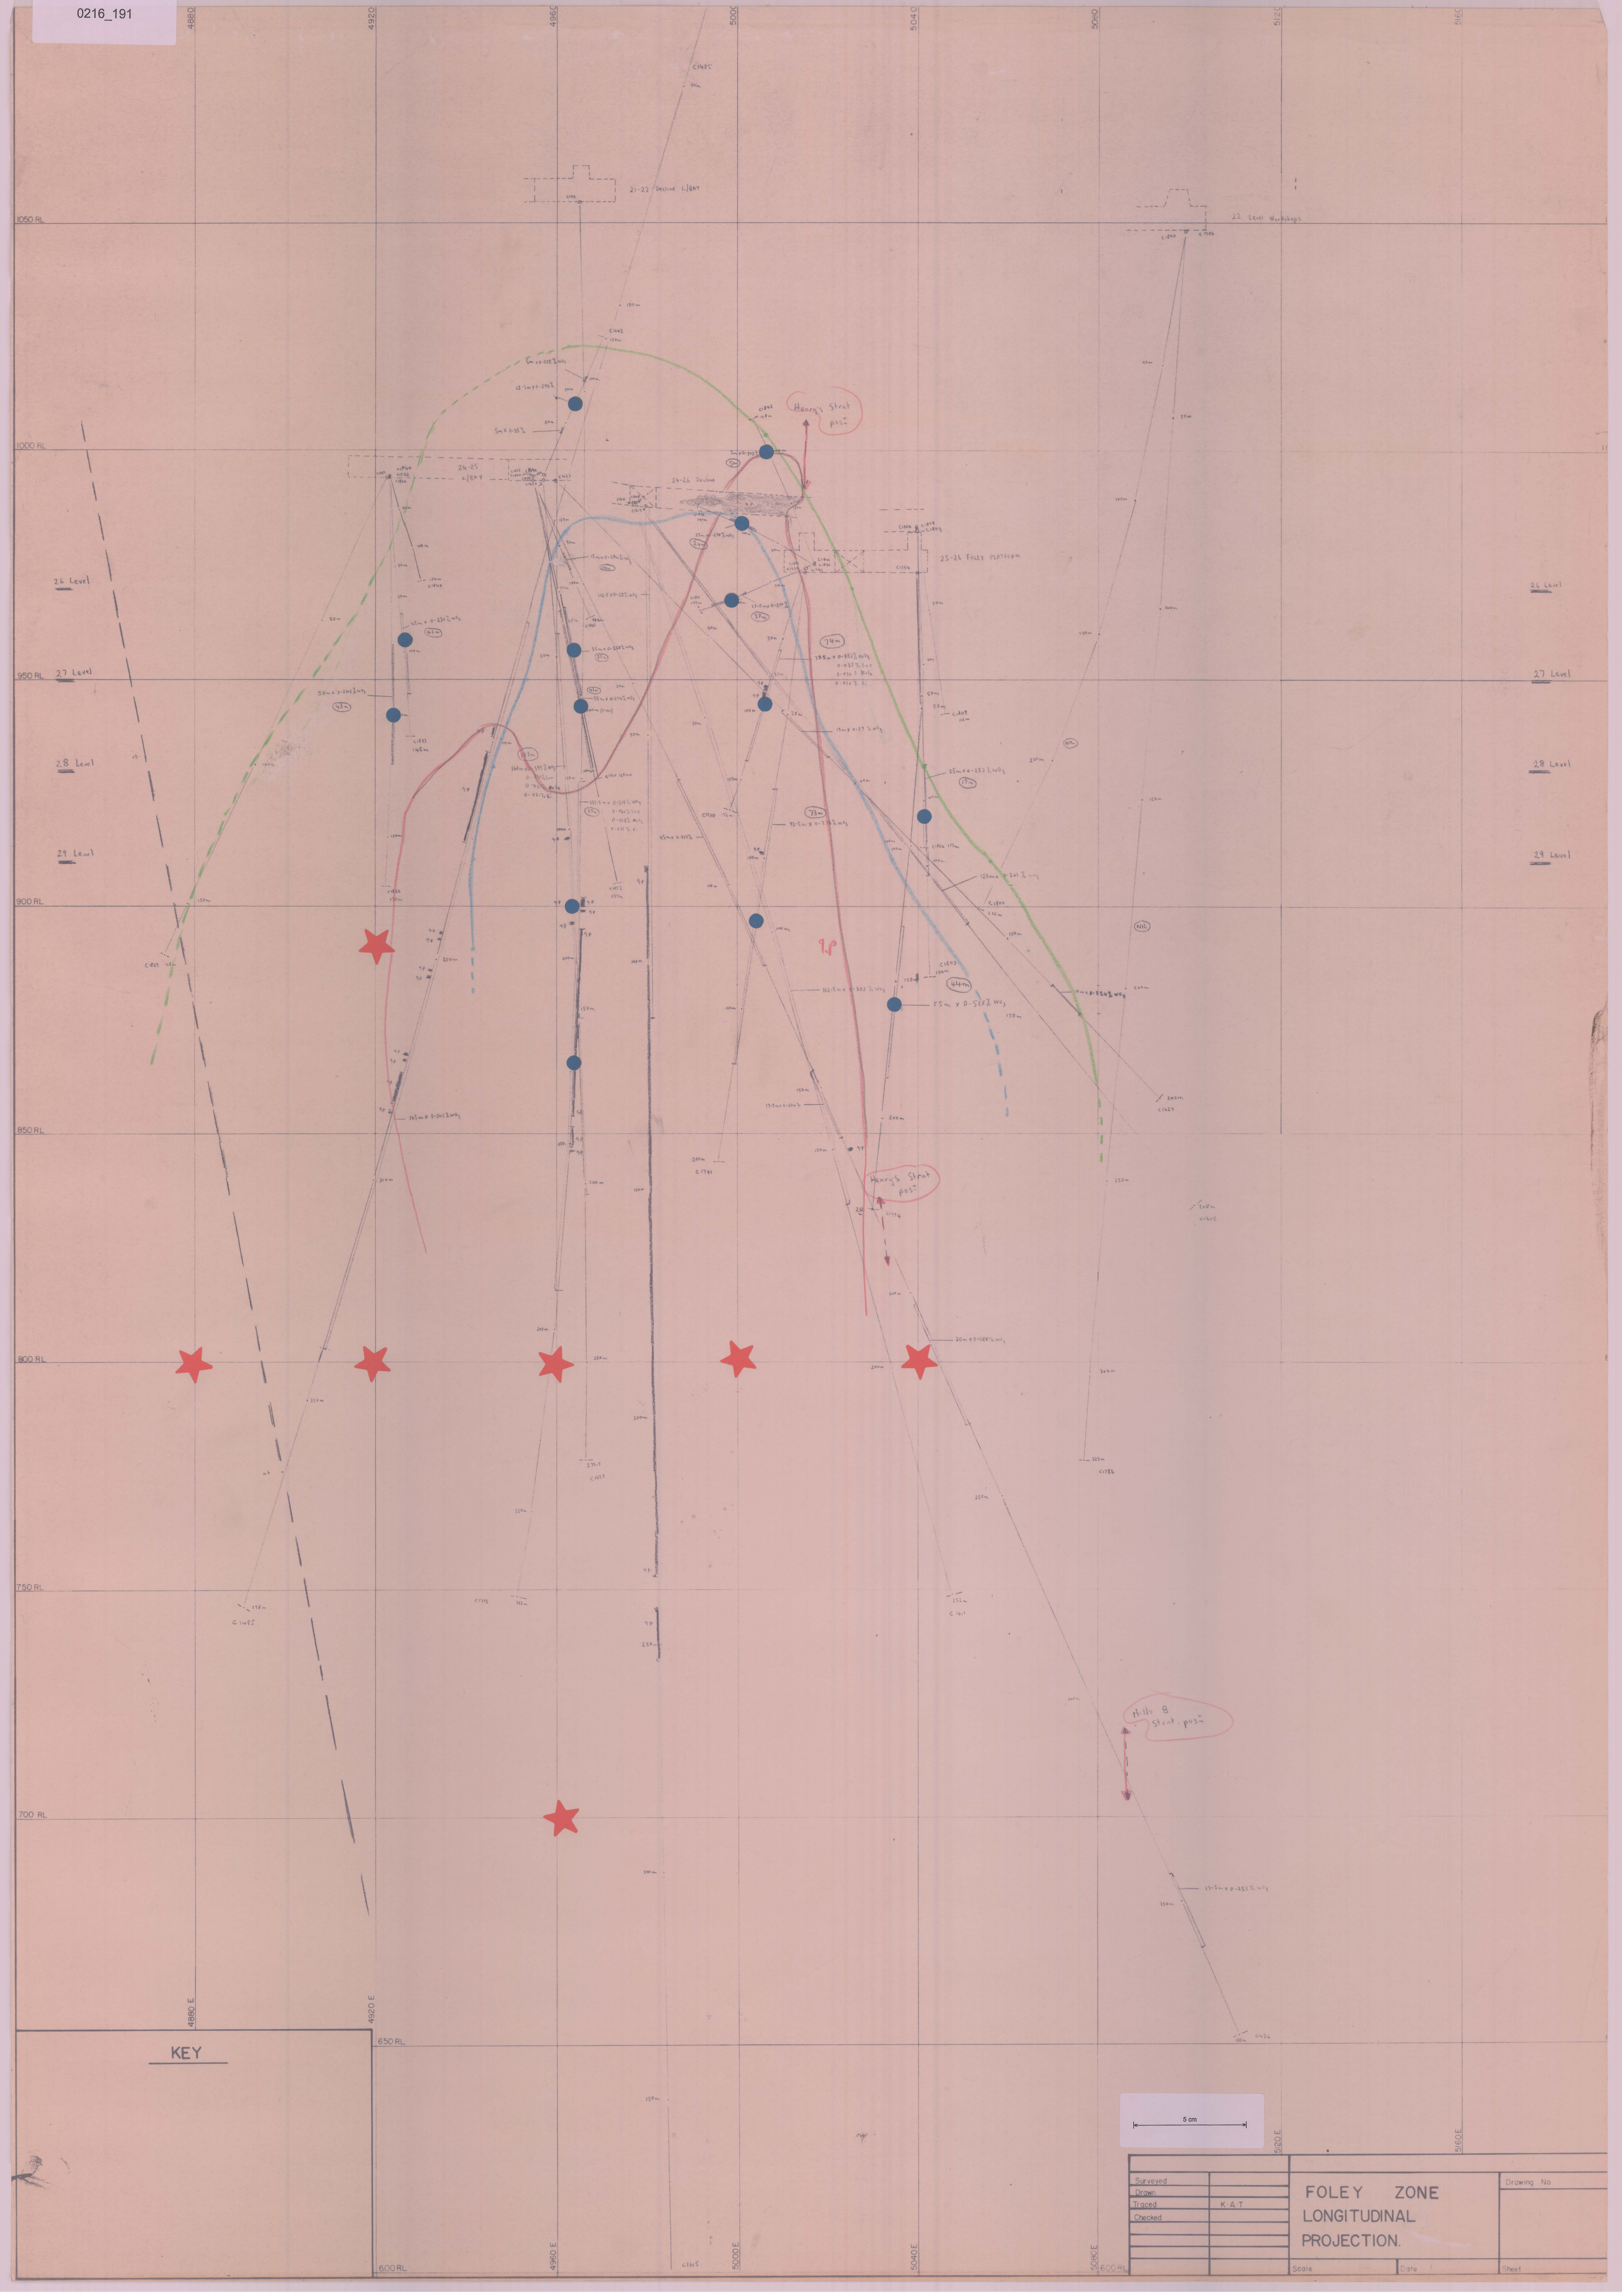

KEY

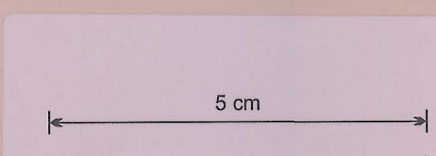

Surveyed		FOLEY ZONE LONGITUDINAL PROJECTION.		Drawing No.	
Drawn					
Traced	K A T				
Checked					
L		Scale	Date	Sheet	