0216_274

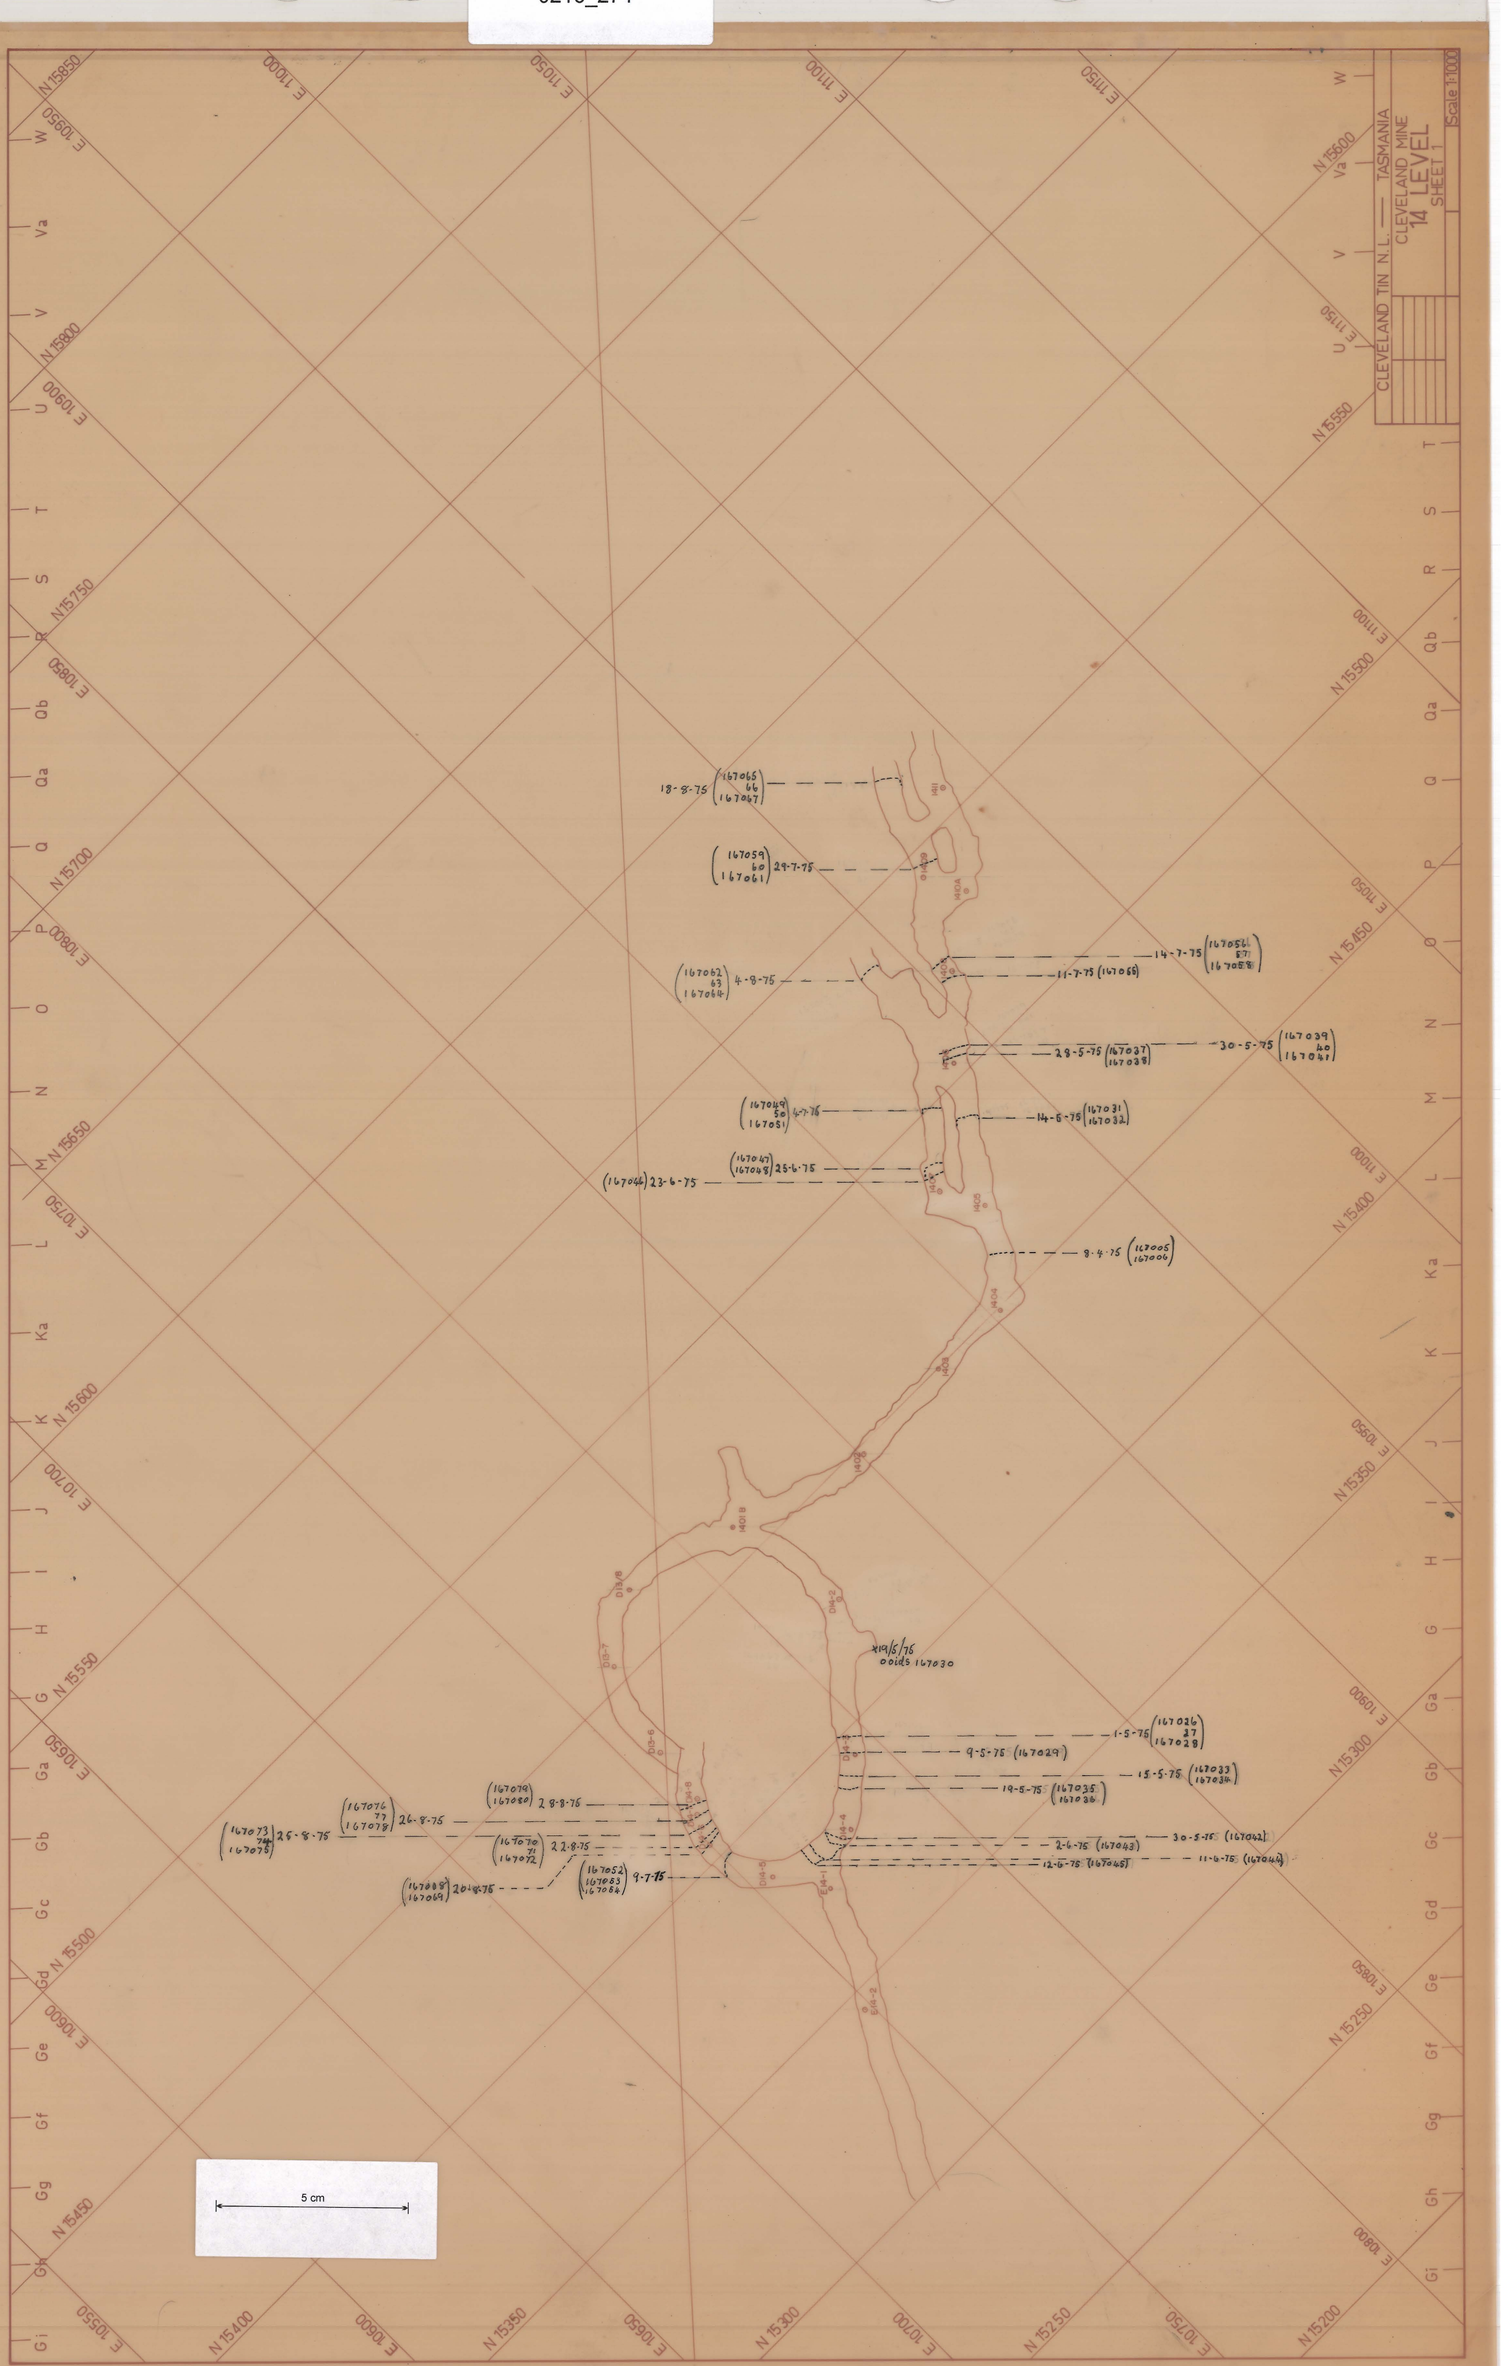
CLEVELAND TIN N.L. — TASMANIA
CLEVELAND MINE
14 LEVEL
SHEET 1
Scale 1:1000
18-8-75 (167065 66 167067)
(167059 60 167061) 29-7-75
(167062 63 167064) 4-8-75
14-7-75 (167056 57 167058)
11-7-75 (167055)
28-5-75 (167037 167038)
30-5-75 (167039 40 167041)
(167049 50 167051) 4-7-75
14-6-75 (167031 167032)
(167047 167048) 25-6-75
(167044) 23-6-75
8-4-75 (167005 167004)
*19/5/76 00ids 167030
1-5-75 (167026 27 167028)
9-5-75 (167029)
15-5-75 (167033 167034)
19-5-75 (167035 167036)
(167079 167080) 2-8-75
(167076 77 167078) 26-8-75
(167073 74 167075) 25-8-75
(167070 71 167072) 22-8-75
(167052 167053 167054) 9-7-75
(167068 167069) 20-8-75
2-6-75 (167043)
30-5-75 (167042)
12-6-75 (167045)
11-6-75 (167046)
5 cm