

November 1973

R.L. 400 M

1m North

HALL'S REFERENCE PLANE

GH SECTION

Looking North

3 L

4 L

5 L

7 L

8 L

9 L

10 L

October 1974

R.L. 400 M

1m North

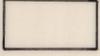
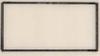
 
HALL'S REFERENCE PLANE

R.L. 1,000 FT

R.L. 300 M

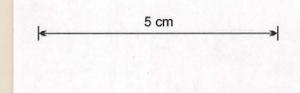
R.L. 1,000 FT

R.L. 300 M

-  LODE
-  Interpreted waste
-  Mined prior to Nov. 1973
-  Mined Nov. 1973 to Oct. 1974
-  Lode outline

NOTE

Illustrated method of calculating the
 Depletion of Geological Reserves
 by mining from November 1st 1973
 to September 30th 1974.



CLEVELAND TIN MINE

ORE RESERVE RECONCILIATION

Plate: 1

Date: Oct. 1974

Scale: 1:500

0216_275