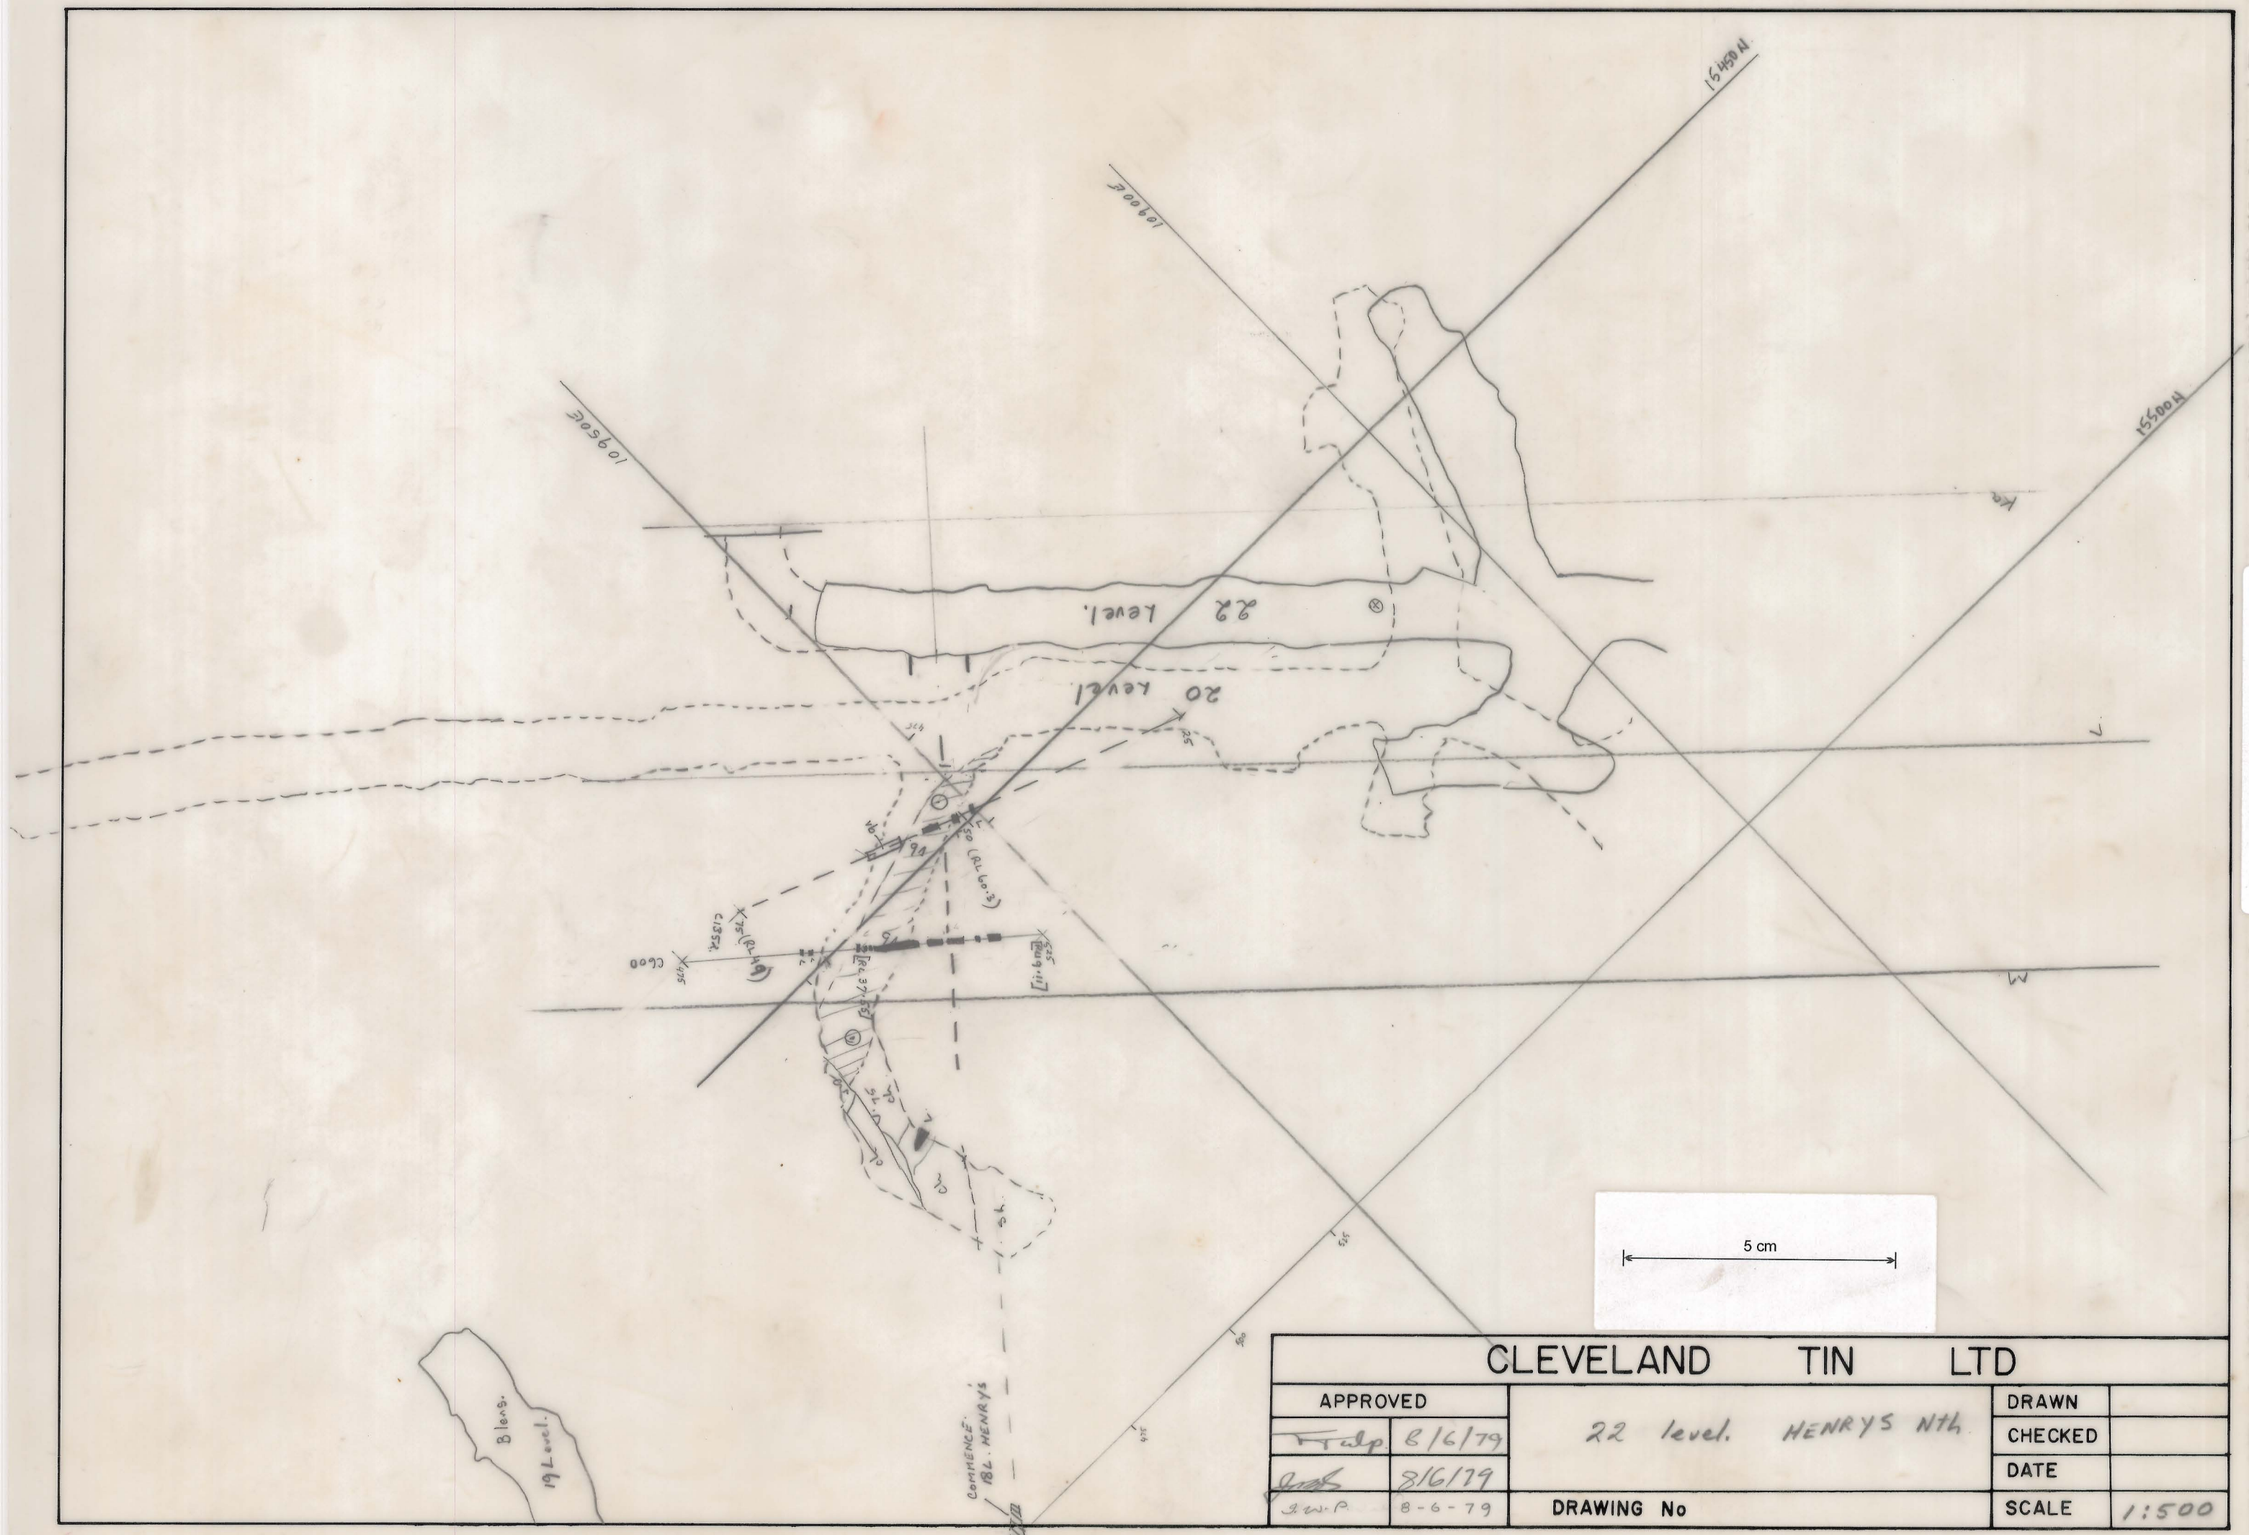
15450N
10900E
10950E
15500N
22 level.
20 level
19 Level.
B lens.
COMMENCE 18L. HENRYS
5 cm
CLEVELAND TIN LTD
APPROVED
8/6/79
8/6/79
8-6-79
22 level. HENRYS Nth
DRAWING No
DRAWN
CHECKED
DATE
SCALE
1:500

0216_278