


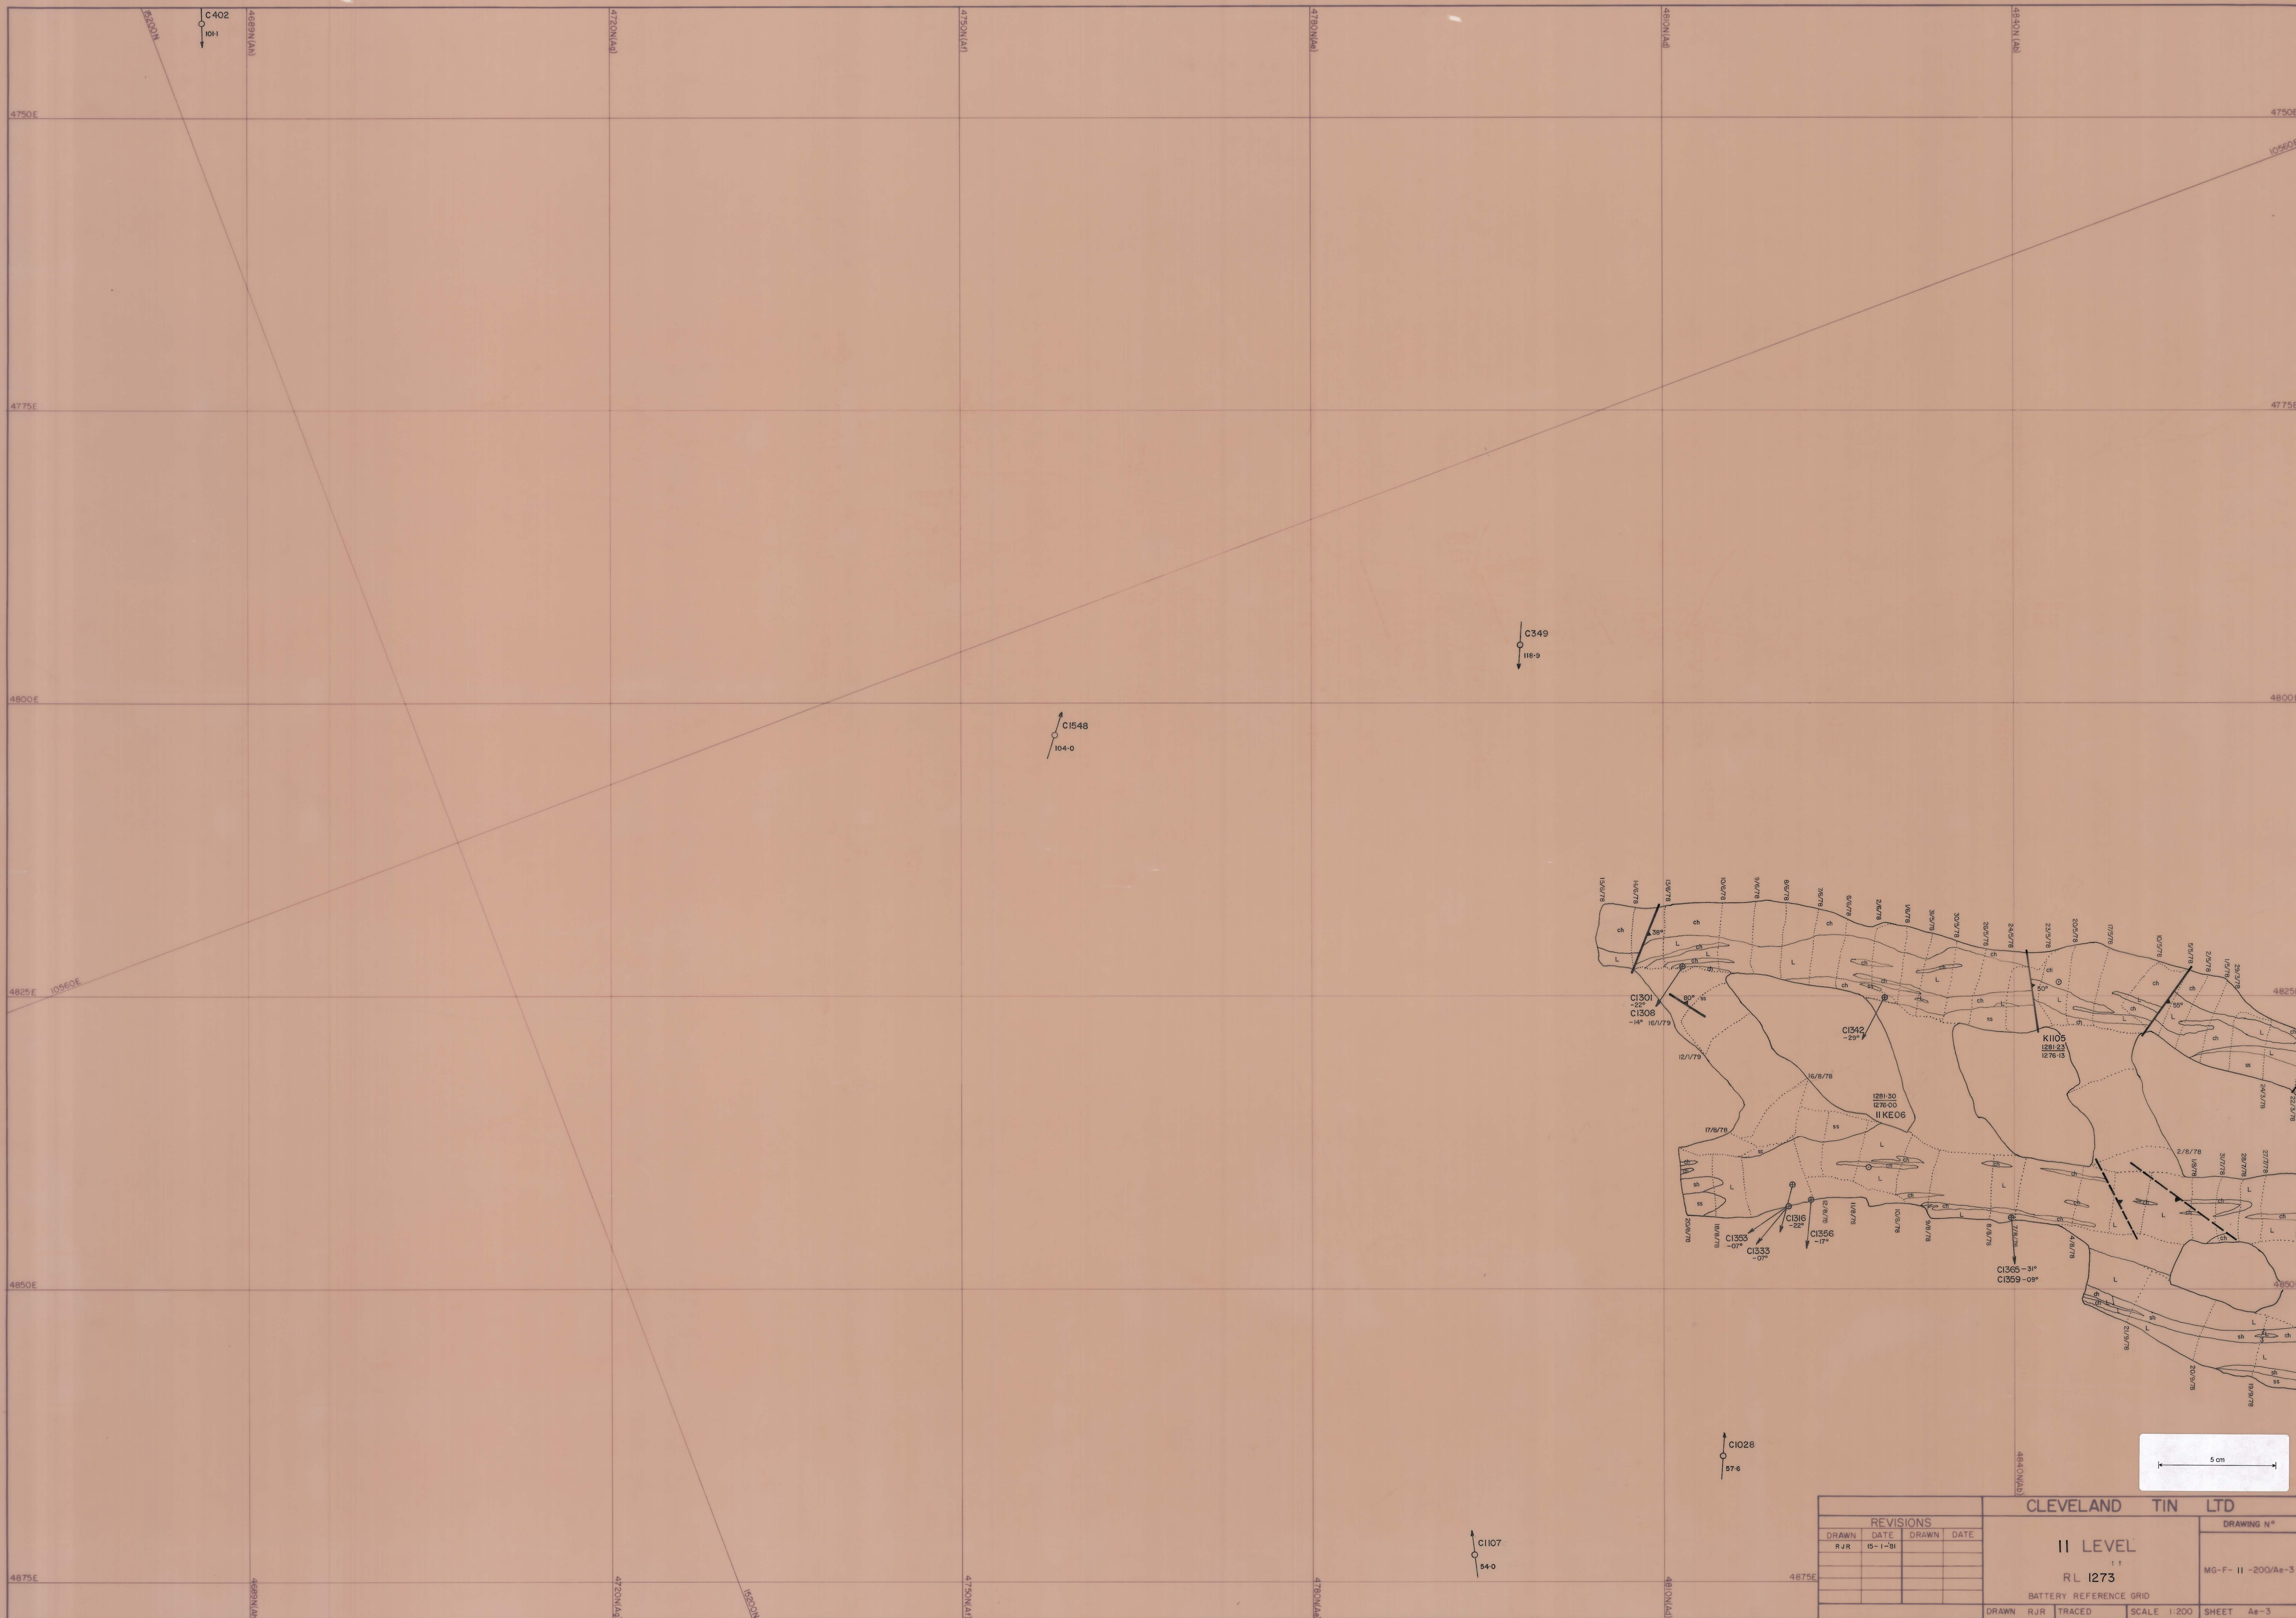

REVISIONS			
DRAWN	DATE	DRAWN	DATE
RJR	15-1-91		

CLEVELAND TIN LTD		DRAWING N°
II LEVEL		MG-F- II -200/Ae-3
RL 1273		
BATTERY REFERENCE GRID		
DRAWN RJR	TRACED	SHEET Ae-3