


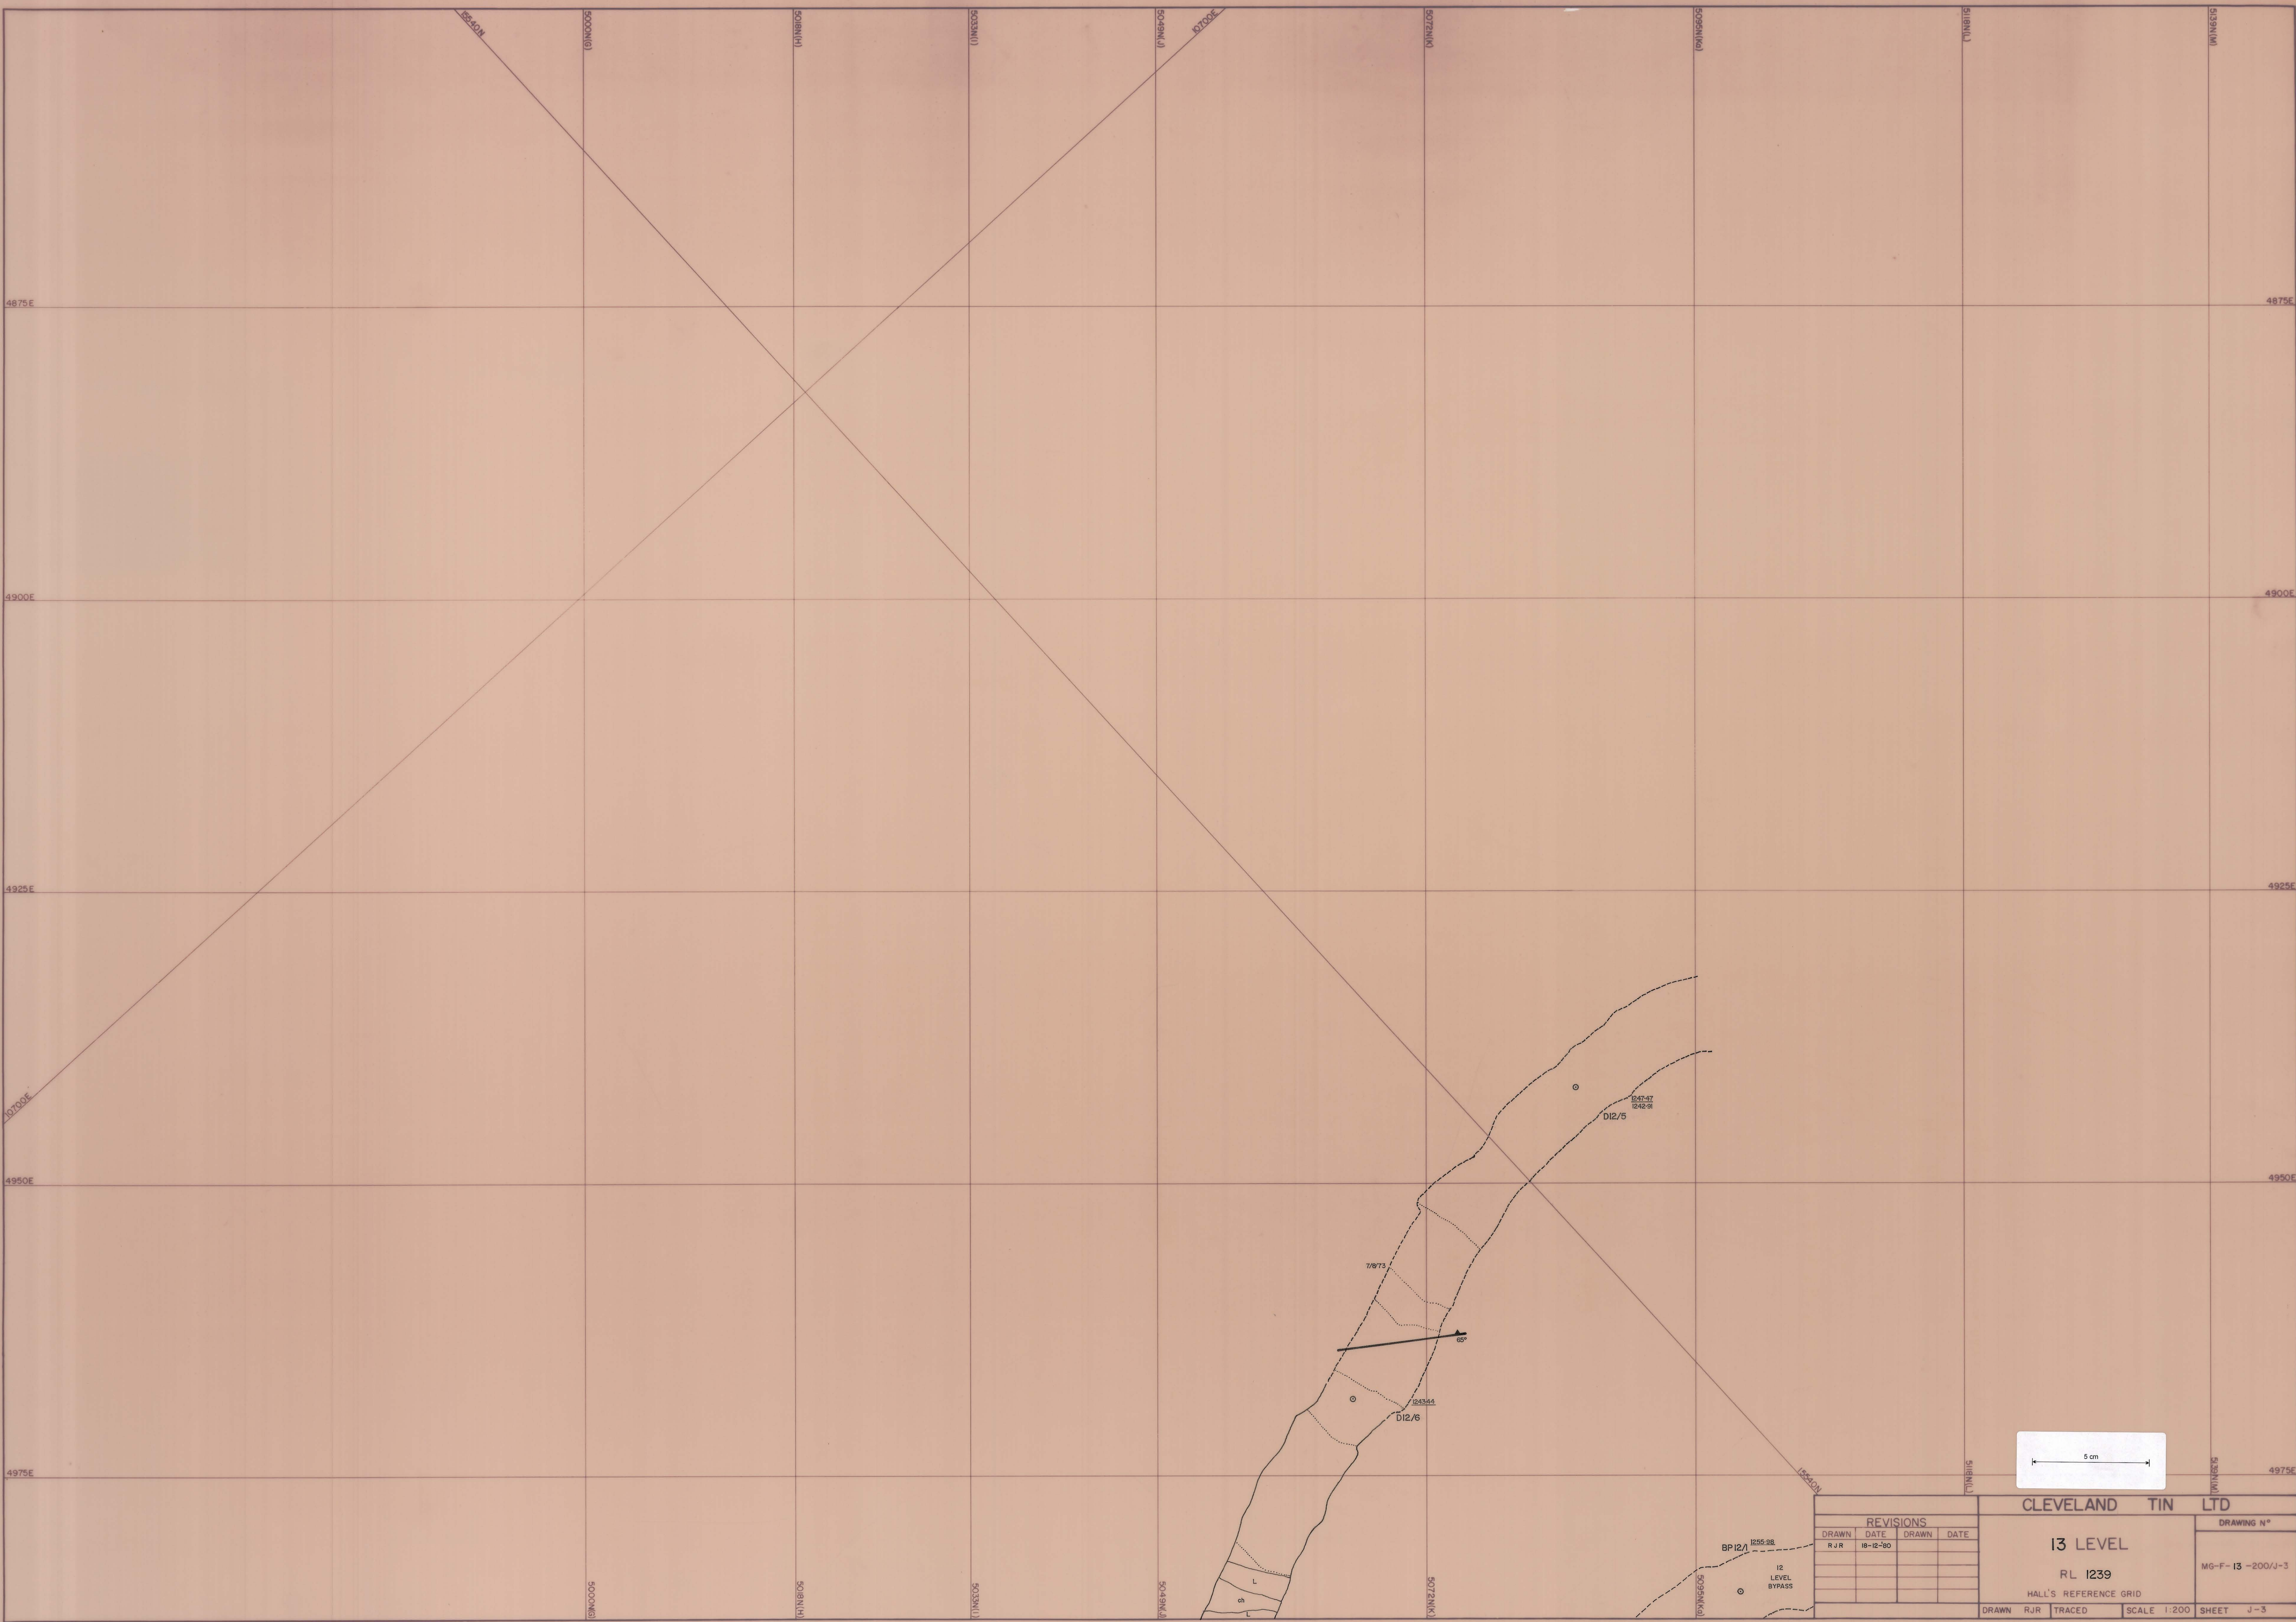

REVISIONS			
DRAWN	DATE	DRAWN	DATE
RJR	18-12-90		

CLEVELAND TIN LTD

DRAWING N°

13 LEVEL

RL 1239

HALL'S REFERENCE GRID

DRAWN RJR TRACED

SCALE 1:200

SHEET J-3

M6-F-13 -200/J-3