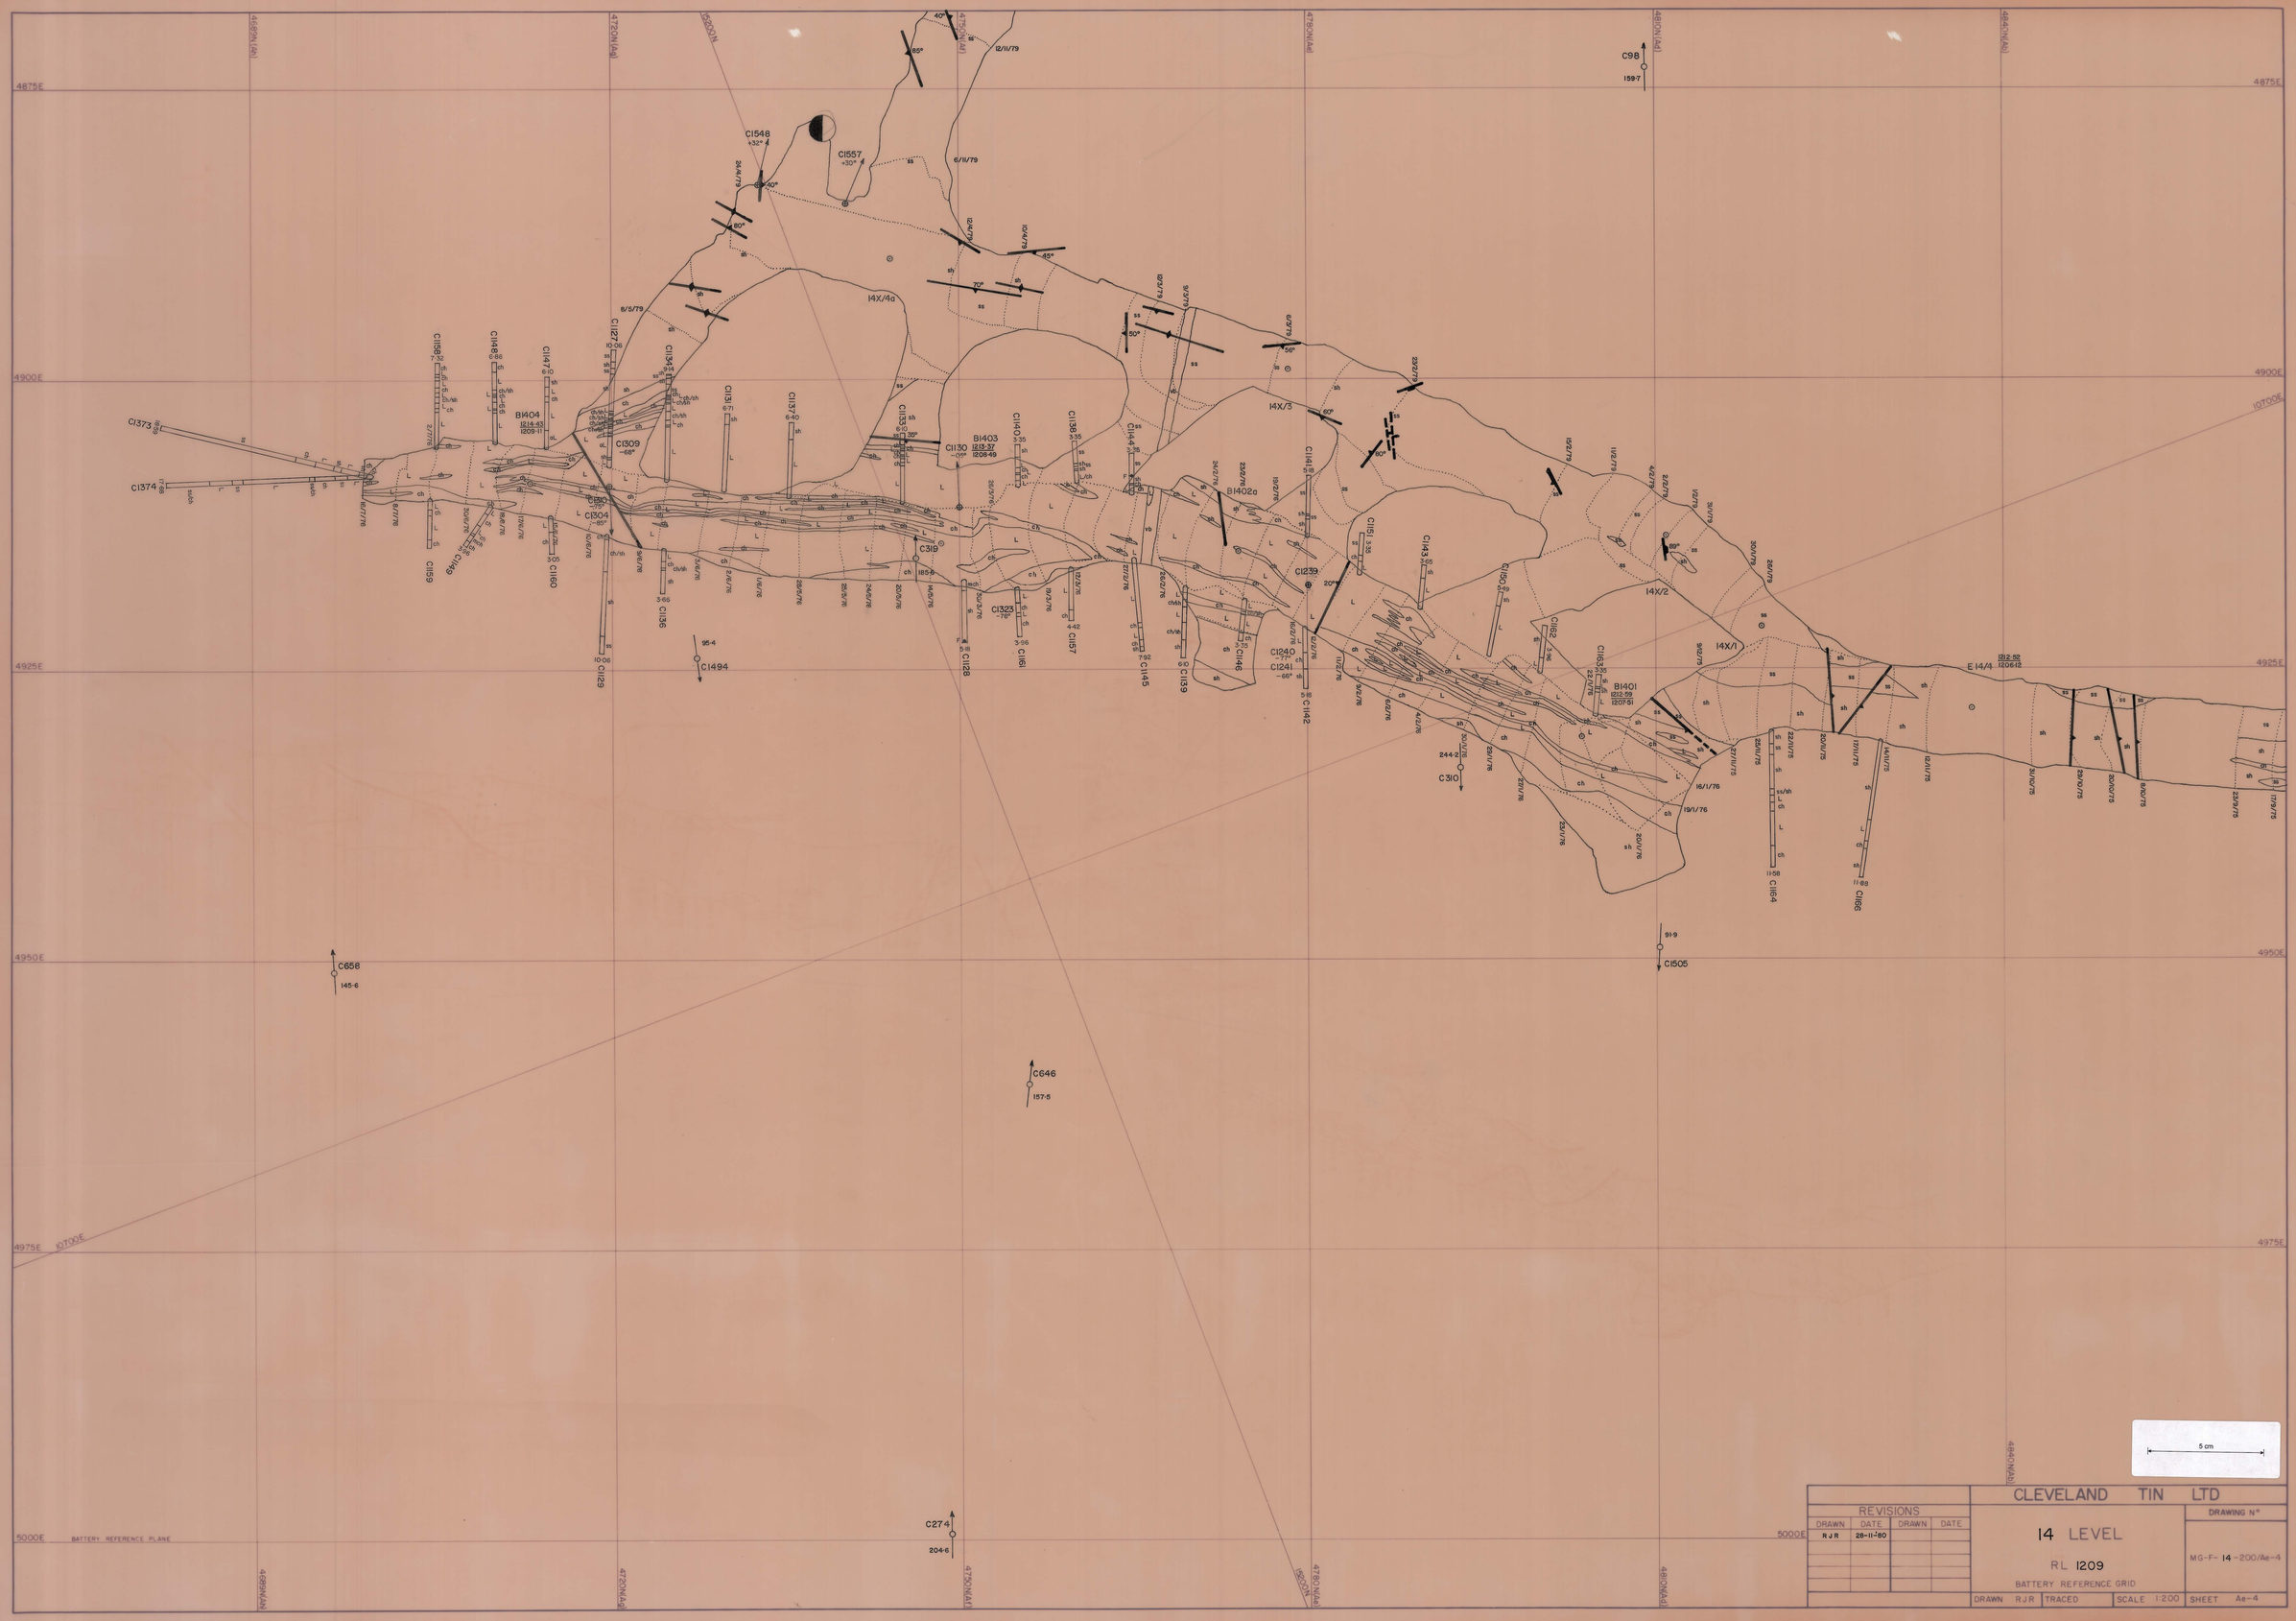

REVISIONS			
DRAWN	DATE	DRAWN	DATE
RJR	28-11-80		

CLEVELAND TIN LTD

14 LEVEL

RL 1209

BATTERY REFERENCE GRID

DRAWING N° MG-F-14-200/Ae-4

DRAWN RJR | TRACED | SCALE 1:200 | SHEET Ae-4

0216_329