


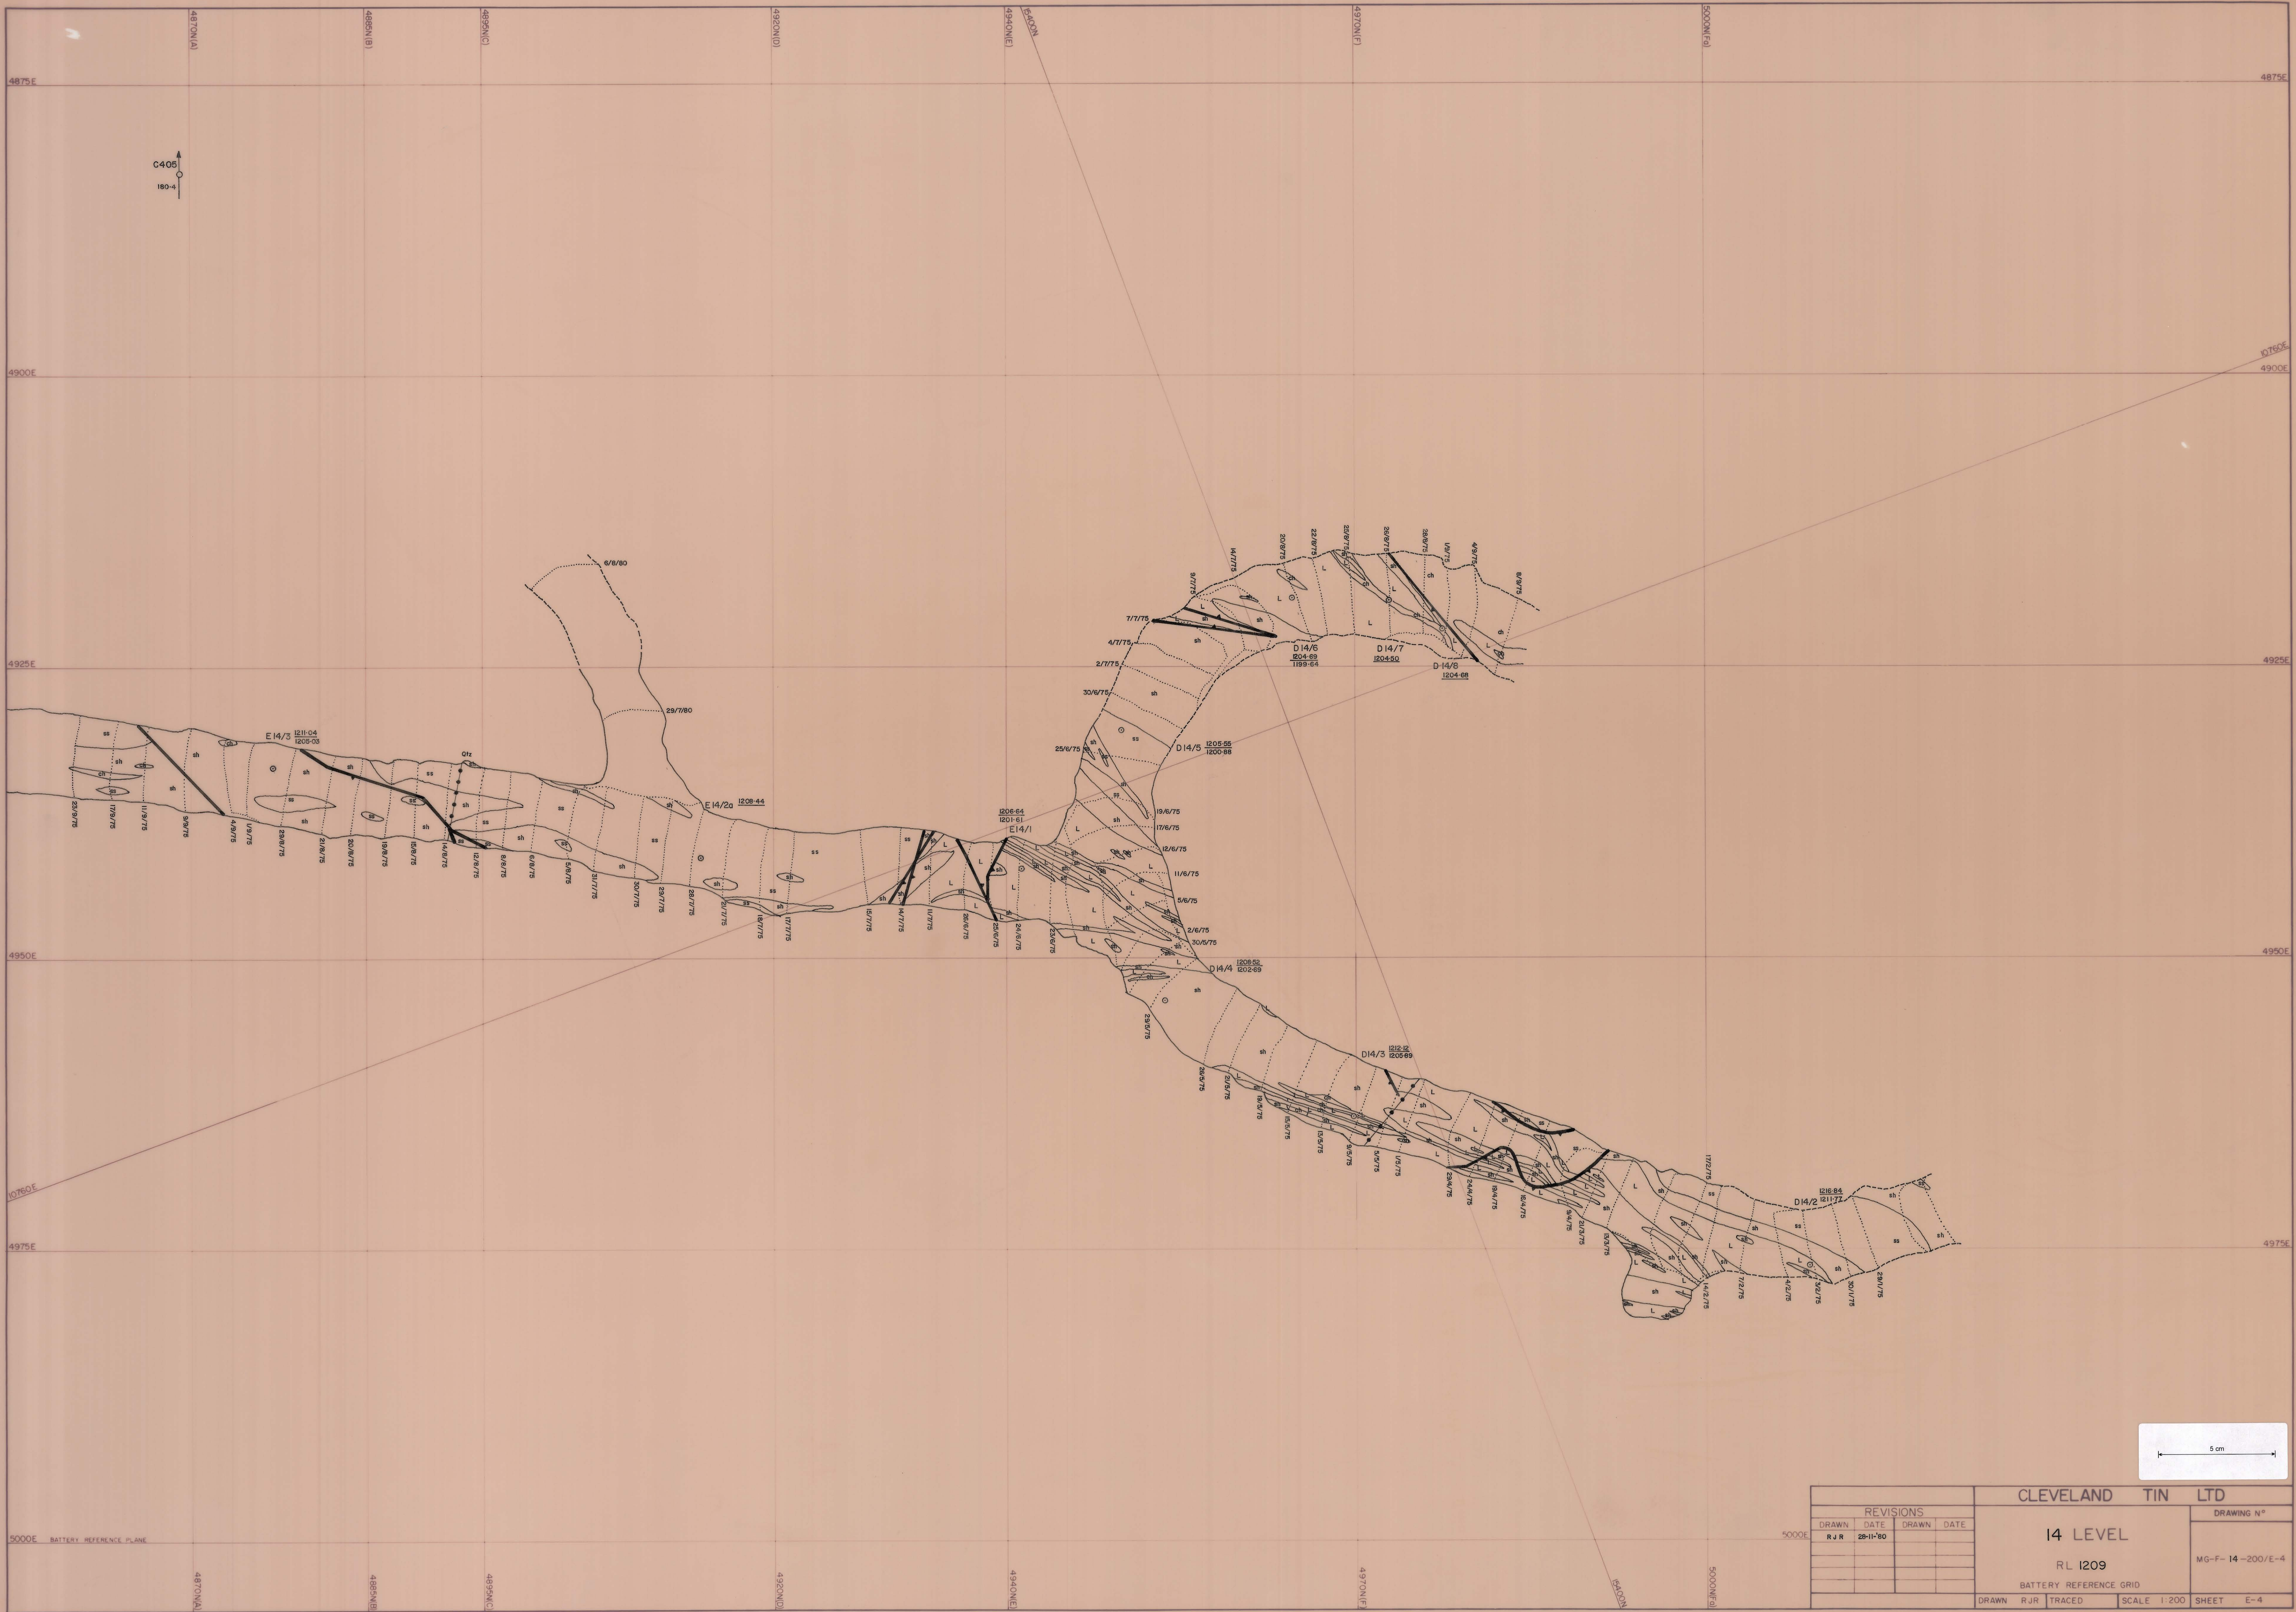

REVISIONS				CLEVELAND TIN LTD			
DRAWN	DATE	DRAWN	DATE	DRAWING N°		DRAWING N°	
RJR	28-11-90			14 LEVEL		MG-F-14-200/E-4	
				RL 1209		BATTERY REFERENCE GRID	
				DRAWN		SCALE 1:200	
				RJR		SHEET E-4	
				TRACED			