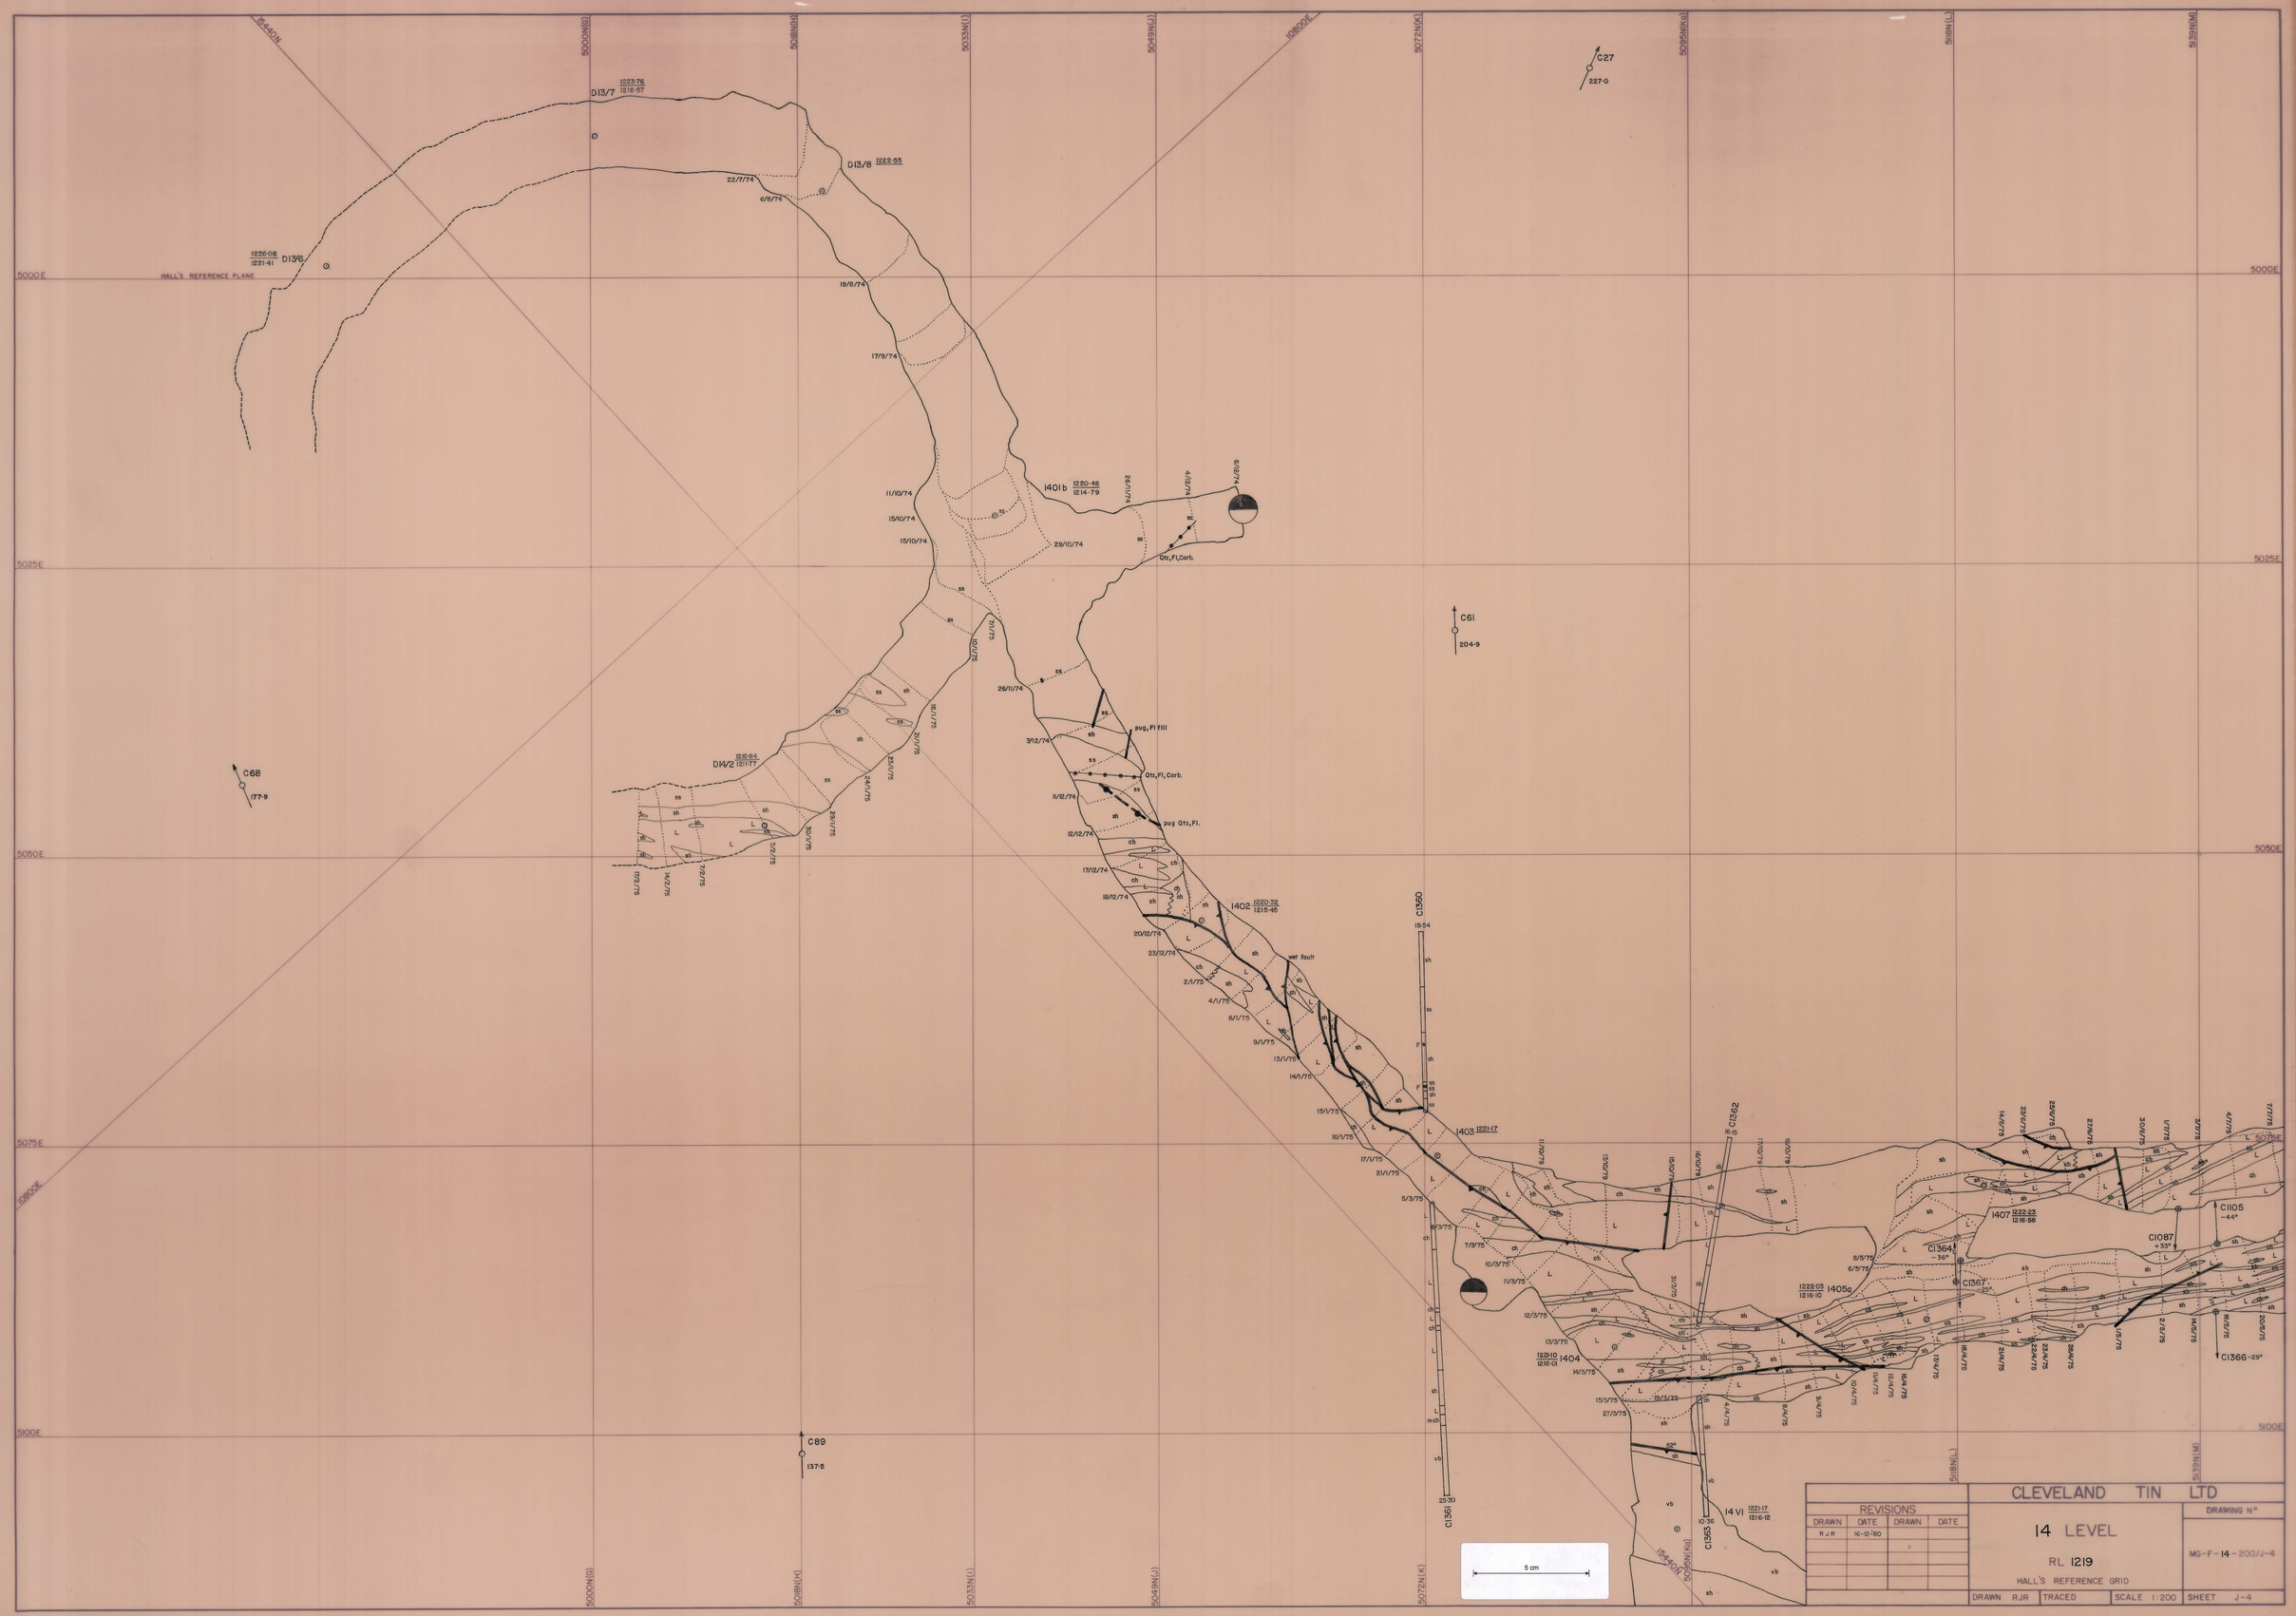
CLEVELAND TIN LTD
14 LEVEL
RL 1219
HALL'S REFERENCE GRID
REVISIONS
DRAWN
DATE
R J R
16-12-80
DRAWING N°
MG-F-14-200/J-4
DRAWN R.J.R
TRACED
SCALE 1:200
SHEET J-4
HALL'S REFERENCE PLANE
5000E
5025E
5050E
5075E
5100E
5000N(G)
5018N(H)
5033N(I)
5049N(J)
5072N(K)
5095N(Ka)
5118N(L)
5139N(M)
D13/7 1222·76 1216·67
D13/8 1222·55
D13/6 1222·08 1221·41
D14/2 1220·84 1221·77
1401b 1220·48 1214·79
1402 1220·32 1215·48
1403 1221·17
1404 1222·10 1216·03
1405a 1222·03 1216·10
1407 1222·23 1216·58
14 VI 1221·17 1216·12
C27 227·0
C61 204·9
C68 177·9
C89 137·5
C1350 15·54
C1361 25·30
C1362 16·08
C1353 10·36
C1364 -36°
C1367 -25°
C1087 +35°
C1105 -44°
C1366 -29°
wet fault
Qtz, Fl, Carb.
pug, Fl fill
pug Qtz, Fl.
5 cm

0216_331