


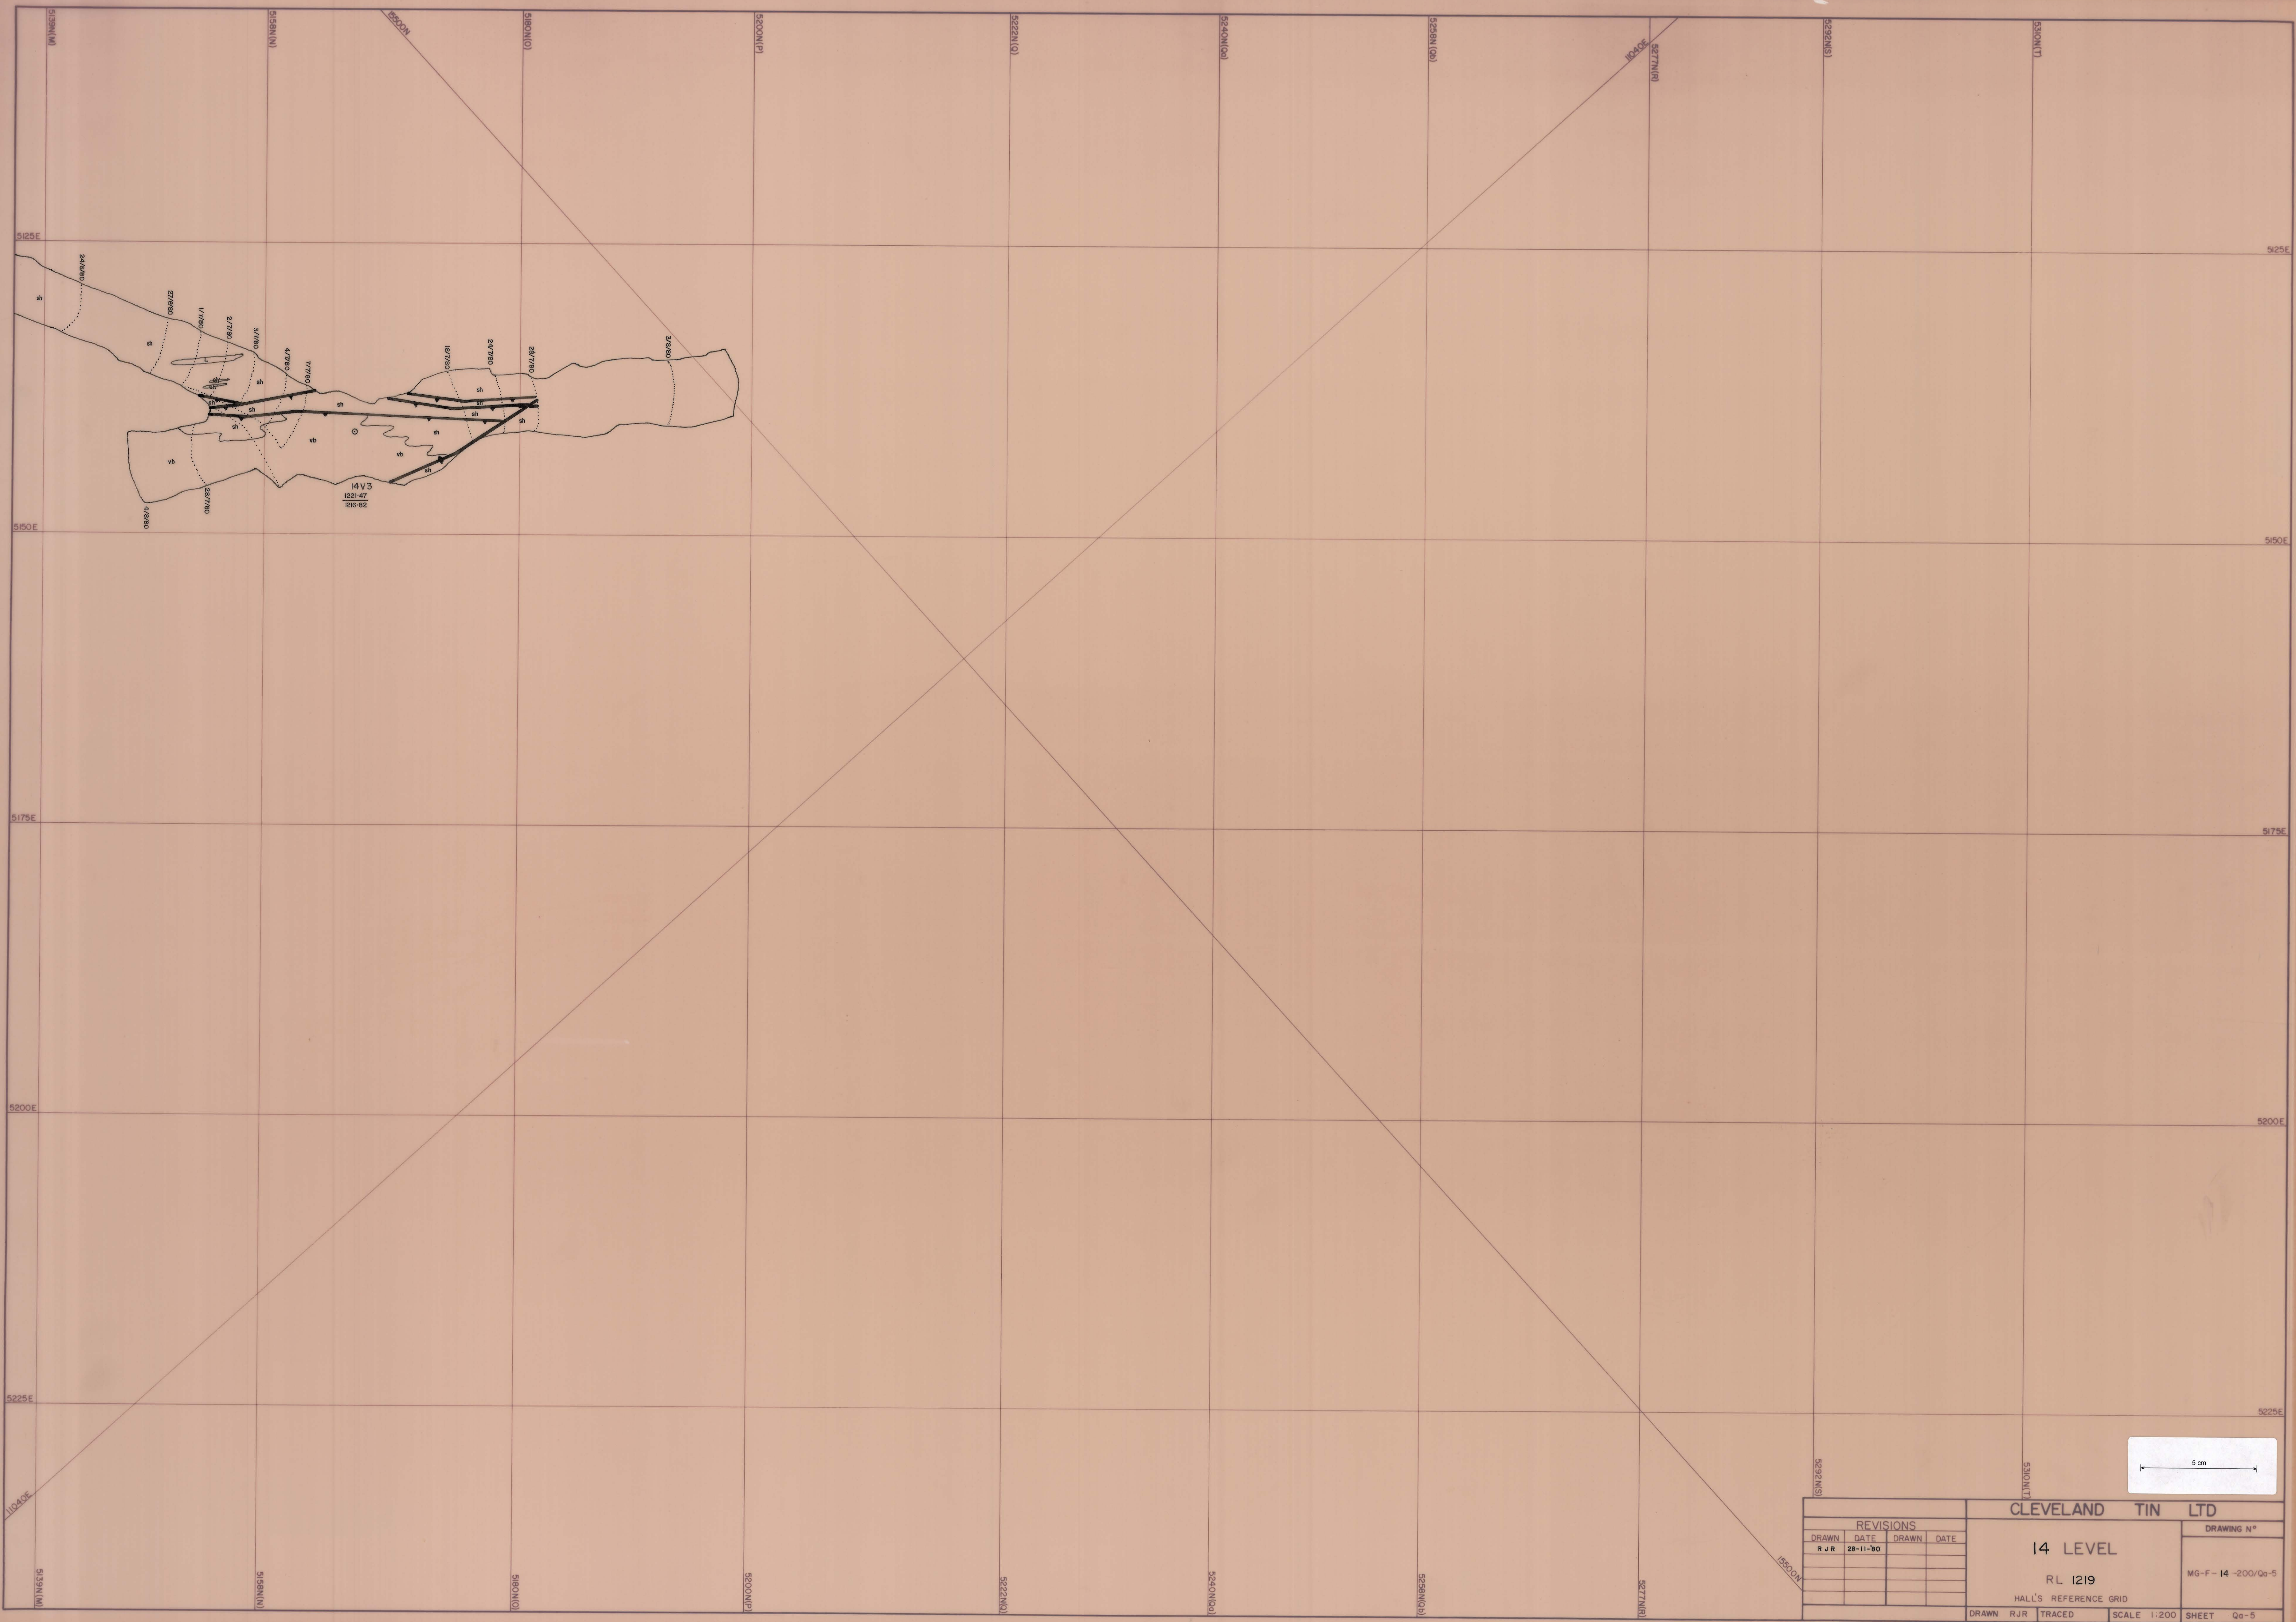

REVISIONS				CLEVELAND TIN LTD		DRAWING N°	
DRAWN	DATE	DRAWN	DATE	14 LEVEL		MG-F-14 -200/Qa-5	
RJR	28-11-80			RL 1219			
				HALL'S REFERENCE GRID			
				DRAWN RJR	TRACED	SCALE 1:200	SHEET Qa-5