


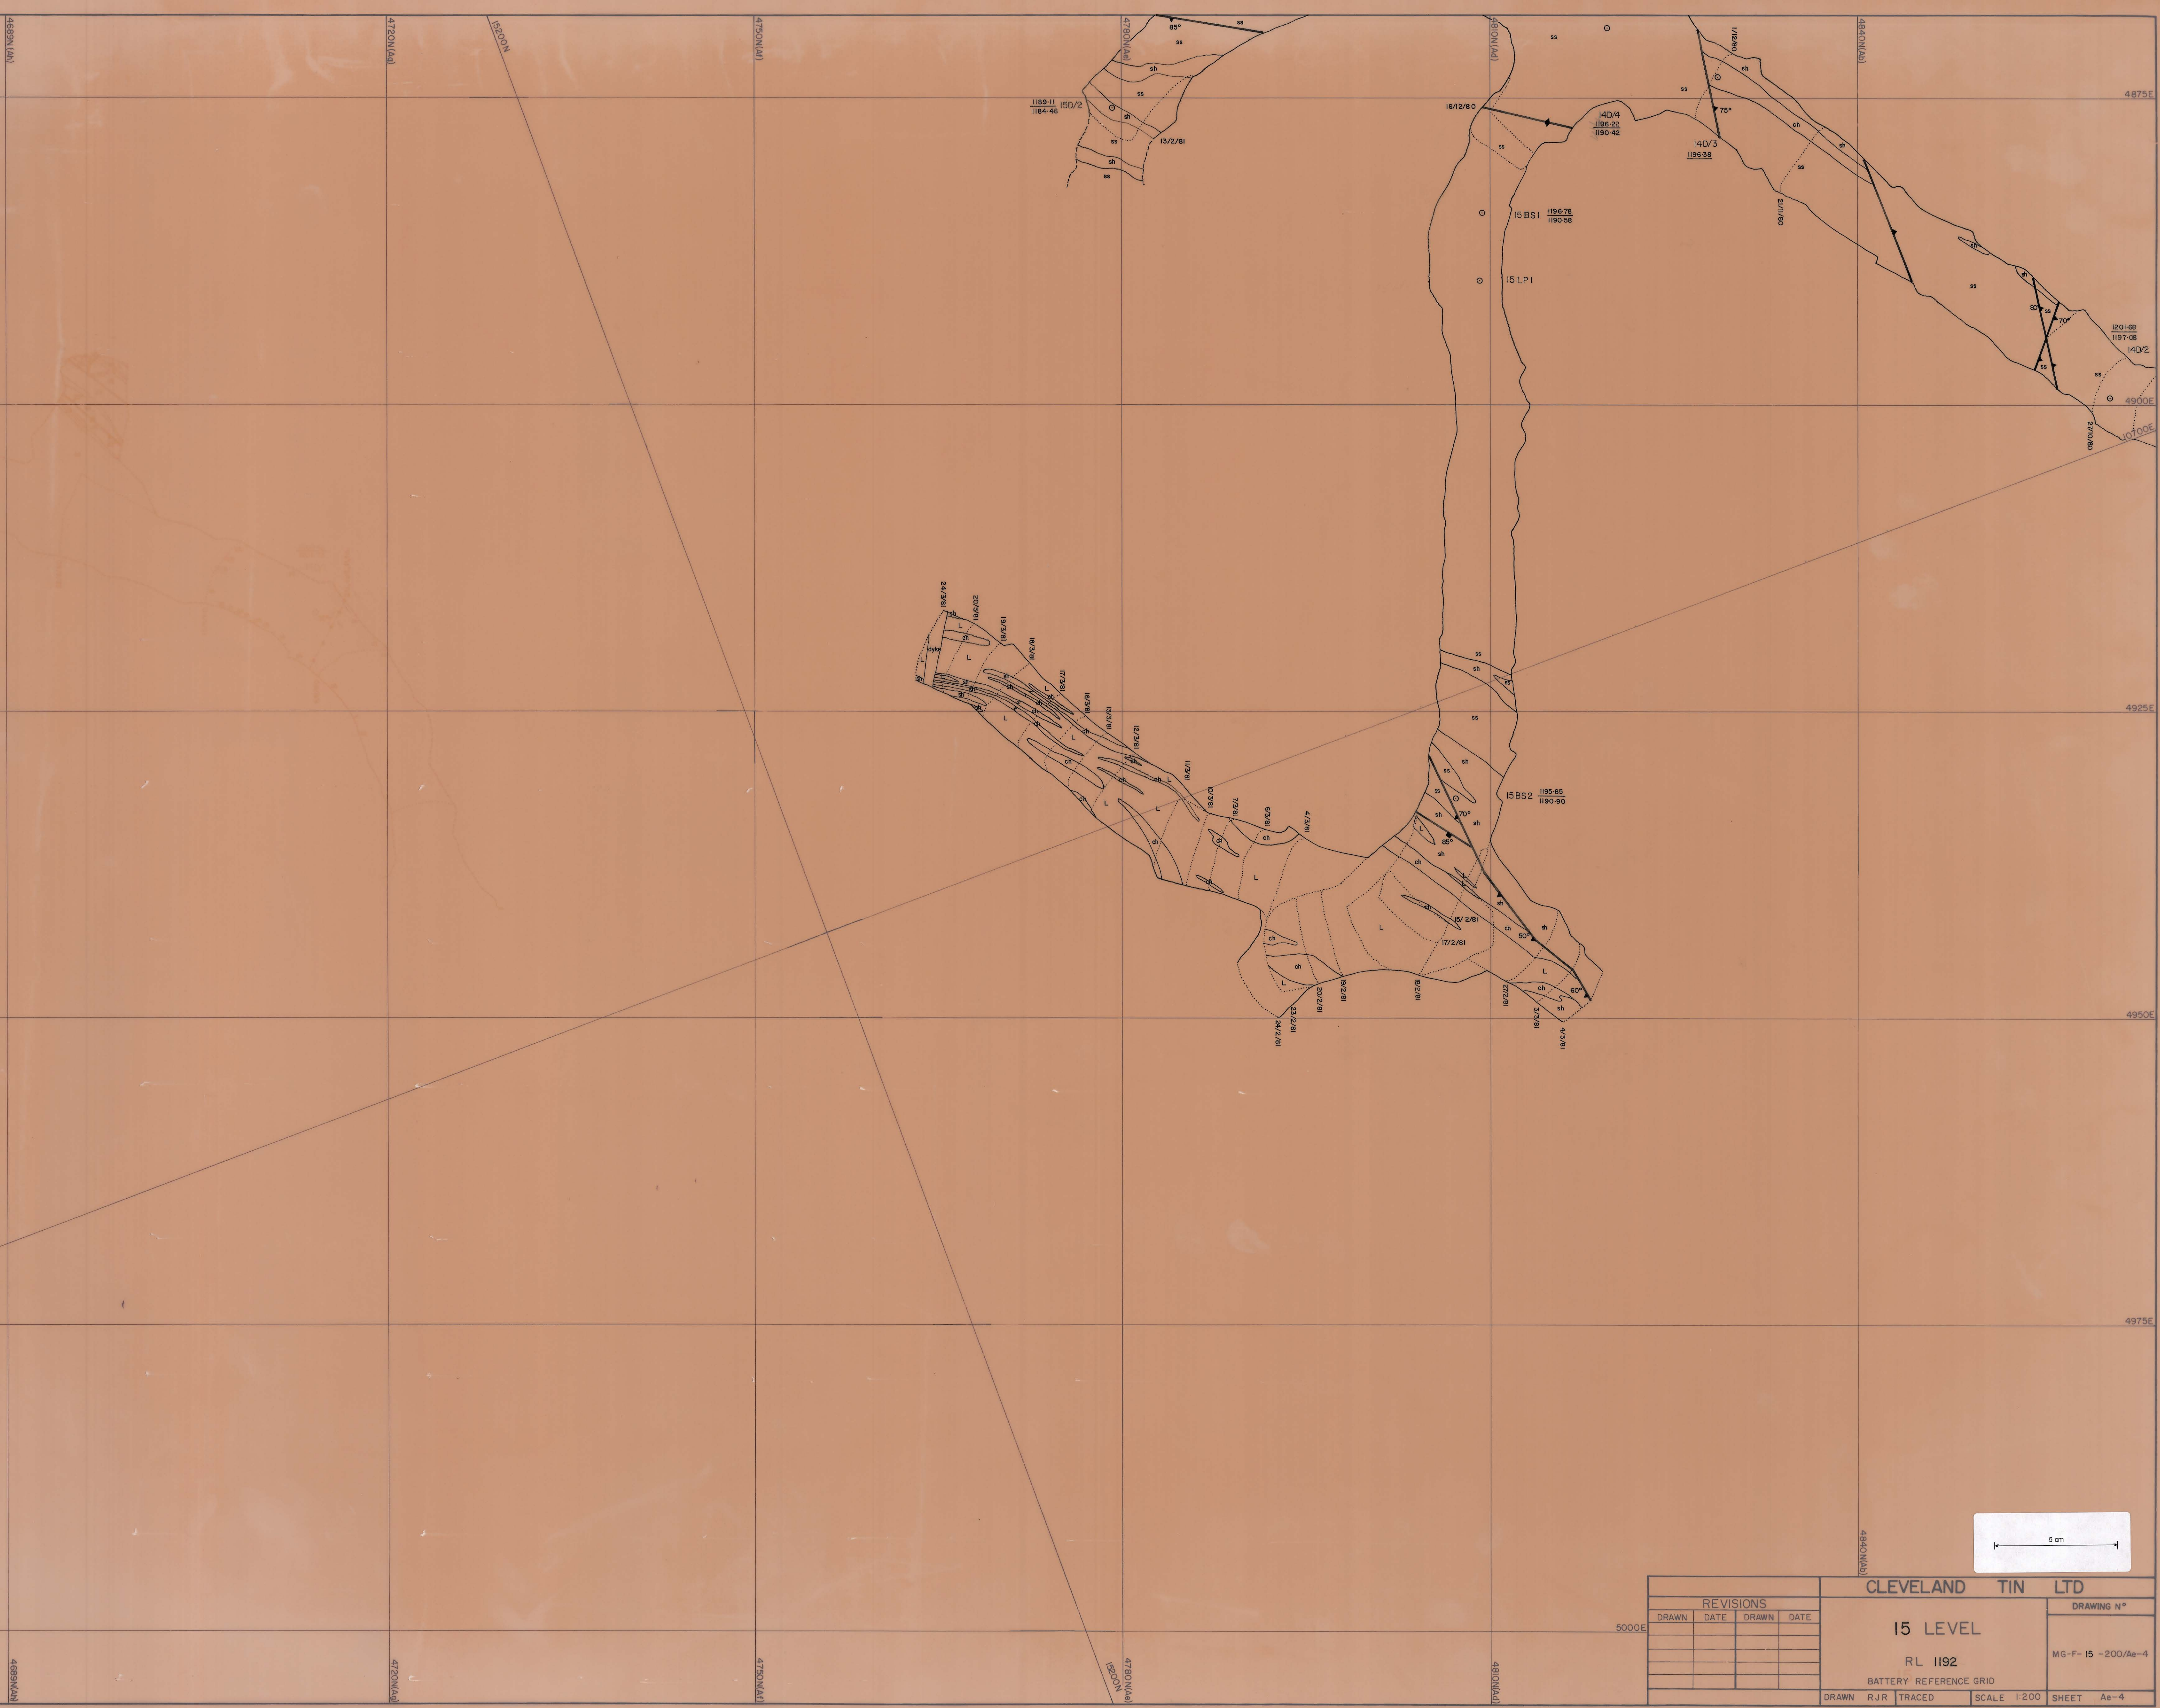

REVISIONS				CLEVELAND TIN LTD		DRAWING N°	
DRAWN	DATE	DRAWN	DATE	15 LEVEL		MG-F- 15 -200/Ae-4	
				RL 1192			
				BATTERY REFERENCE GRID			
				DRAWN	RJR	TRACED	SHEET Ae-4