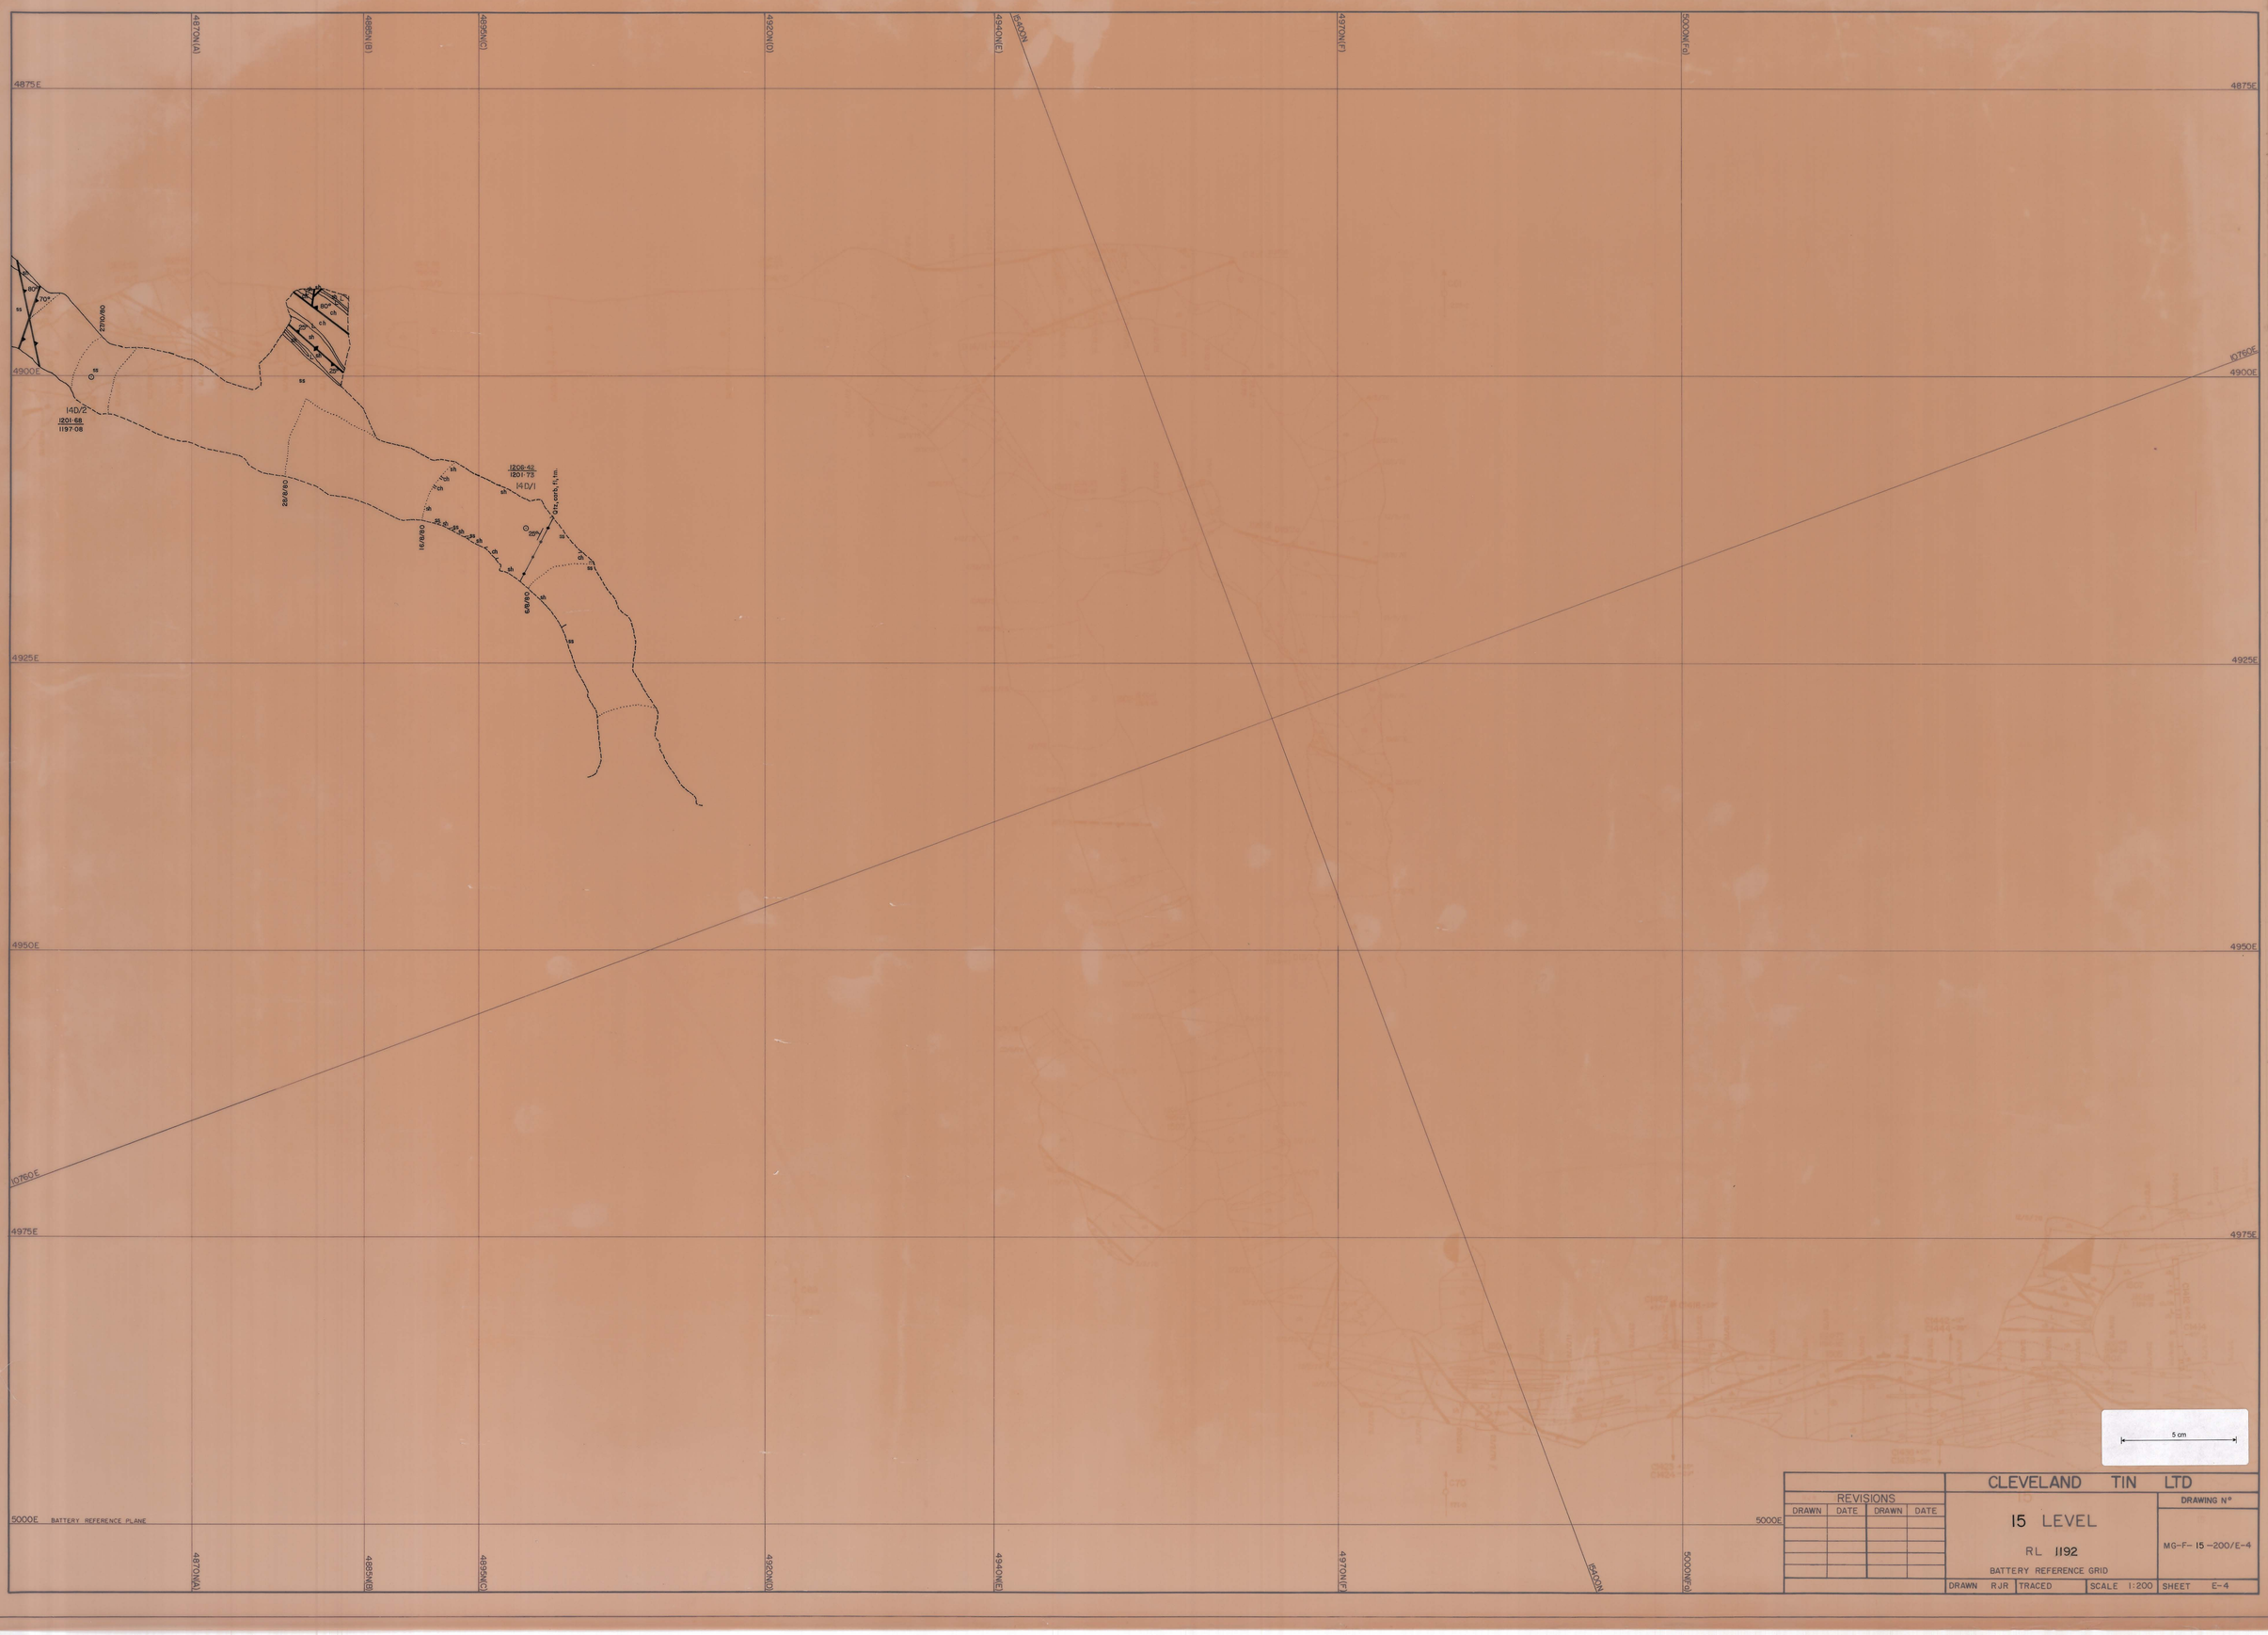
4875E
4900E
4925E
4950E
4975E
5000E
BATTERY REFERENCE PLANE
4870N(A)
4885N(B)
4895N(C)
4920N(D)
4940N(E)
4970N(F)
5000N(Fa)
5400N
10760E
140/2
1201-68
1197-08
140/1
1206-42
1201-73
Qtz, carb, fl, tm.
230/80
25/8/80
16/8/80
68/80
80°
70°
ss
sh
ch
5 cm
CLEVELAND TIN LTD
15 LEVEL
RL 1192
BATTERY REFERENCE GRID
DRAWING N°
MG-F-15-200/E-4
REVISIONS
DRAWN
DATE
DRAWN
DATE
DRAWN RJR
TRACED
SCALE 1:200
SHEET E-4

0216_338