


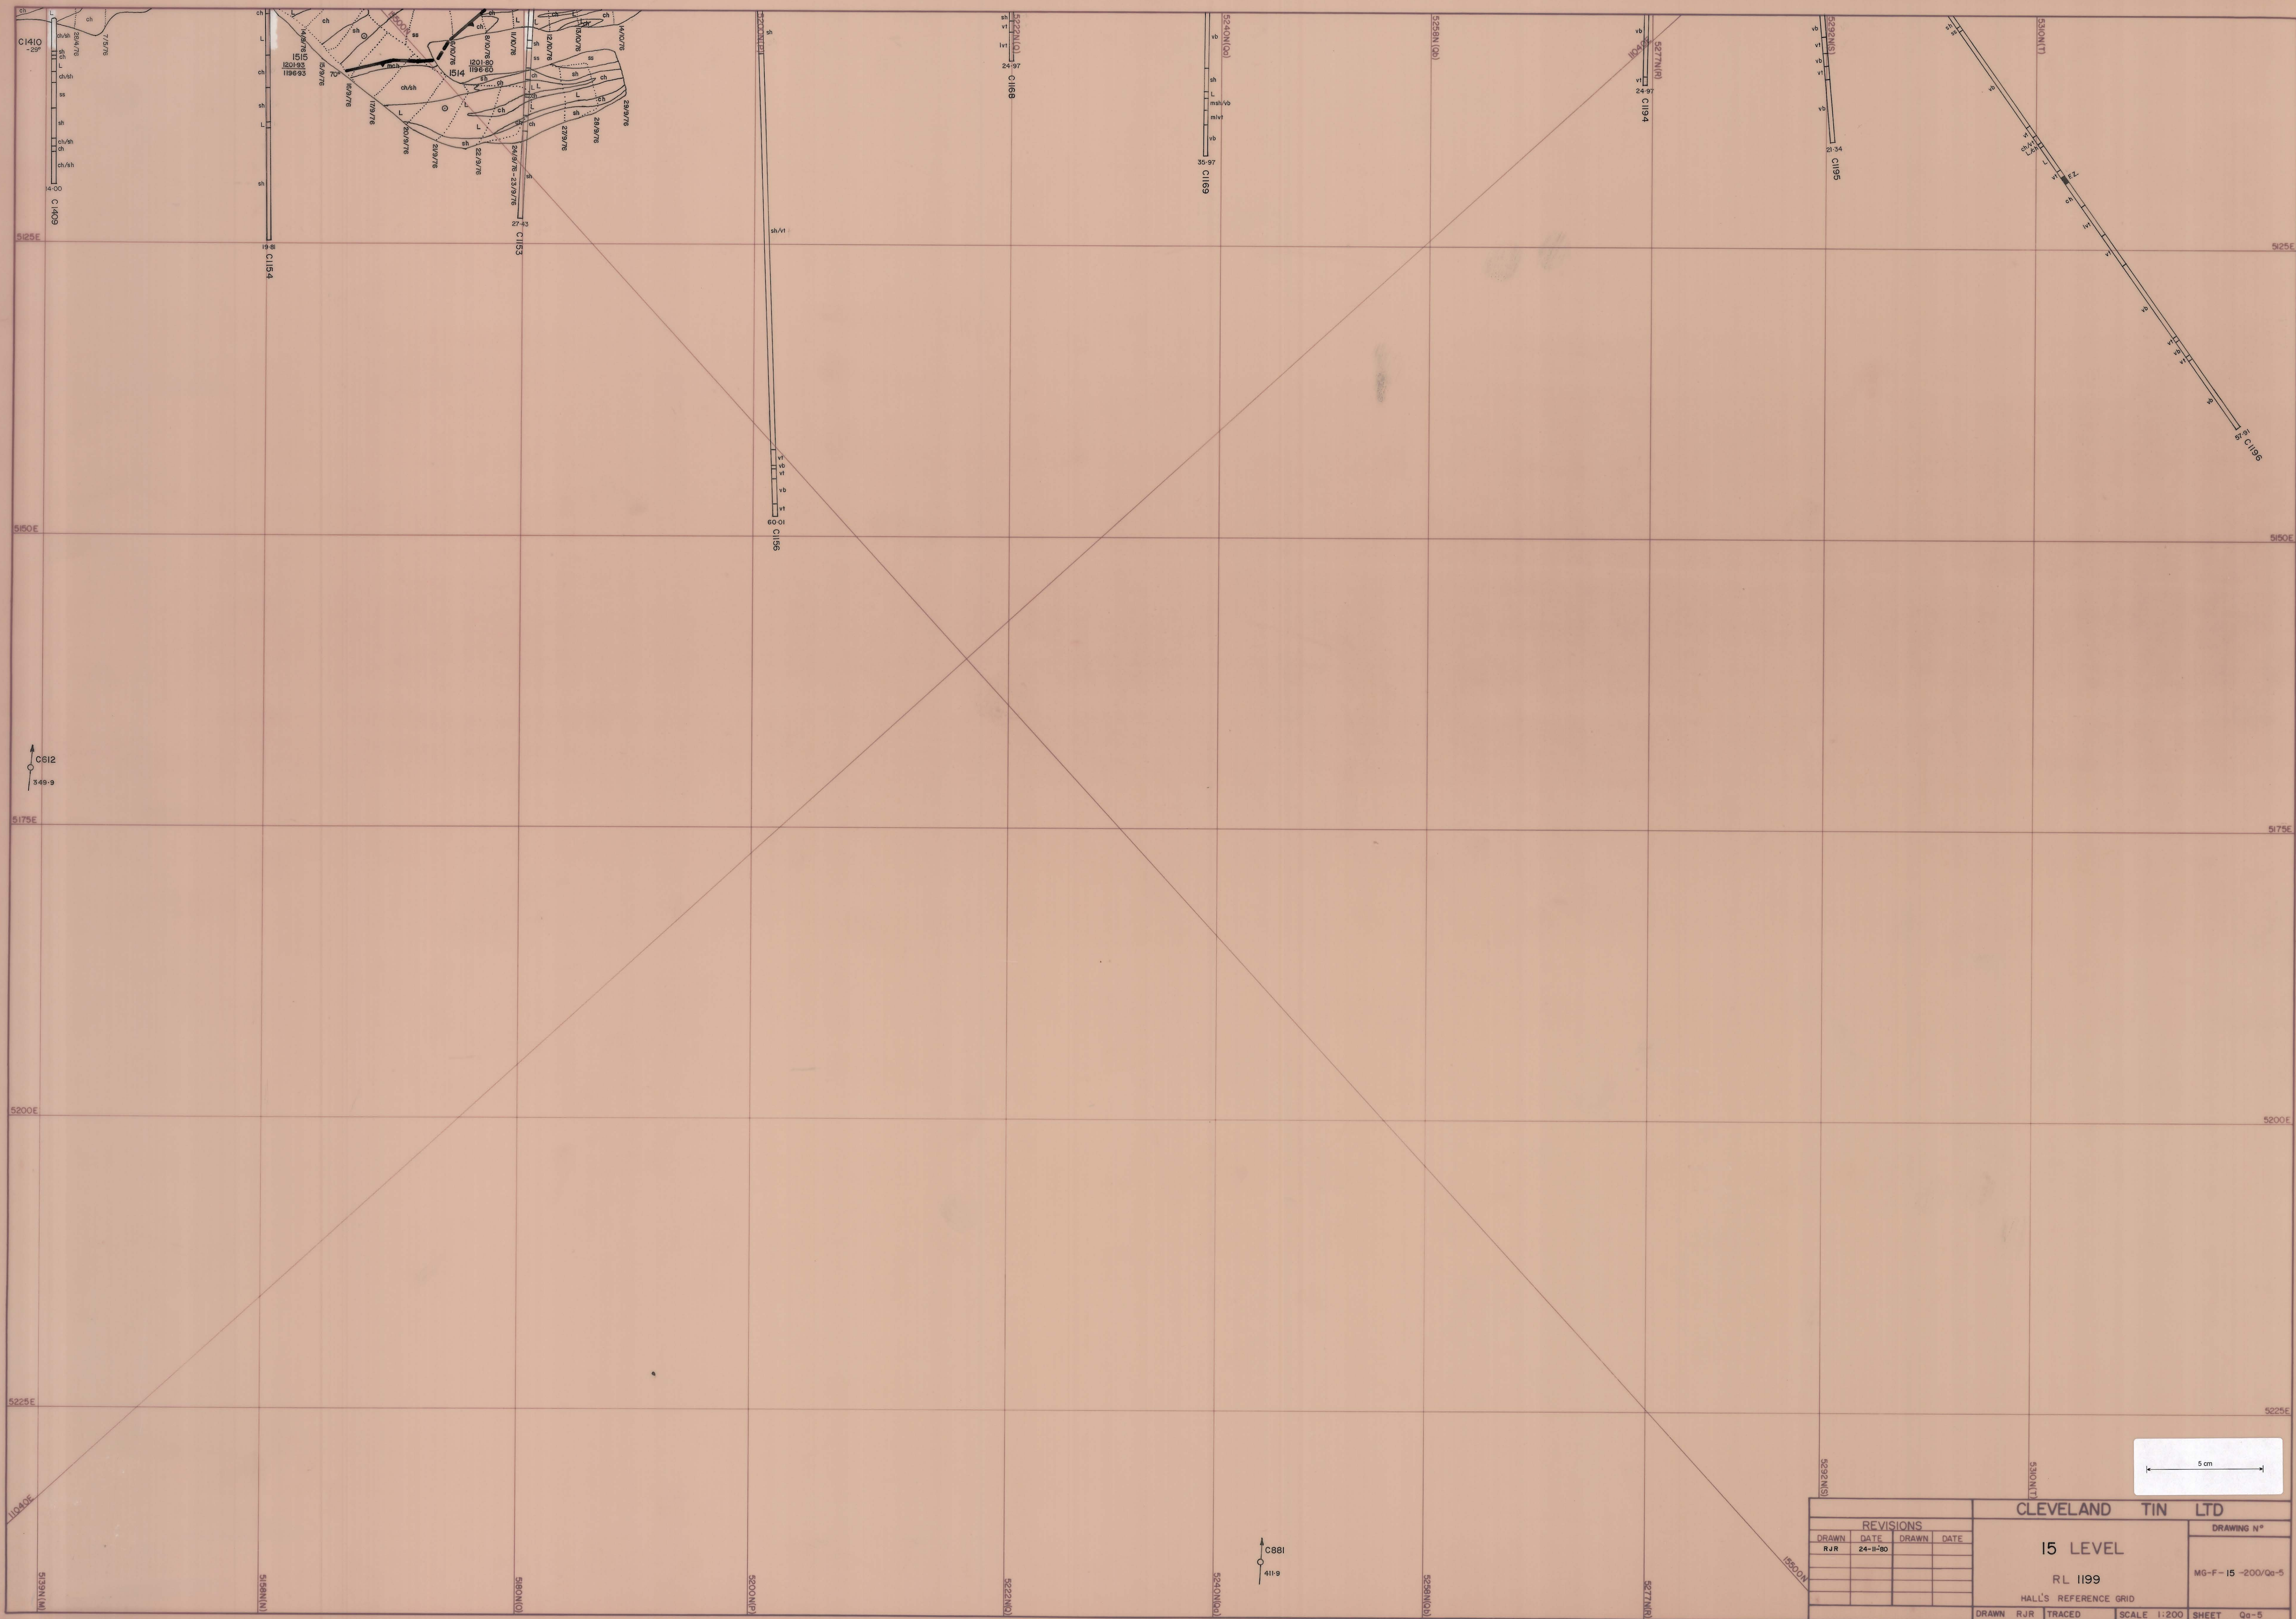

REVISIONS				CLEVELAND TIN LTD			
DRAWN	DATE	DRAWN	DATE	DRAWING N°		DRAWING N°	
RJR	24-11-80			15 LEVEL		M6-F-15-200/Qa-5	
				RL 1199			
				HALL'S REFERENCE GRID			
				DRAWN	RJR	TRACED	SCALE 1:200
							SHEET Qa-5