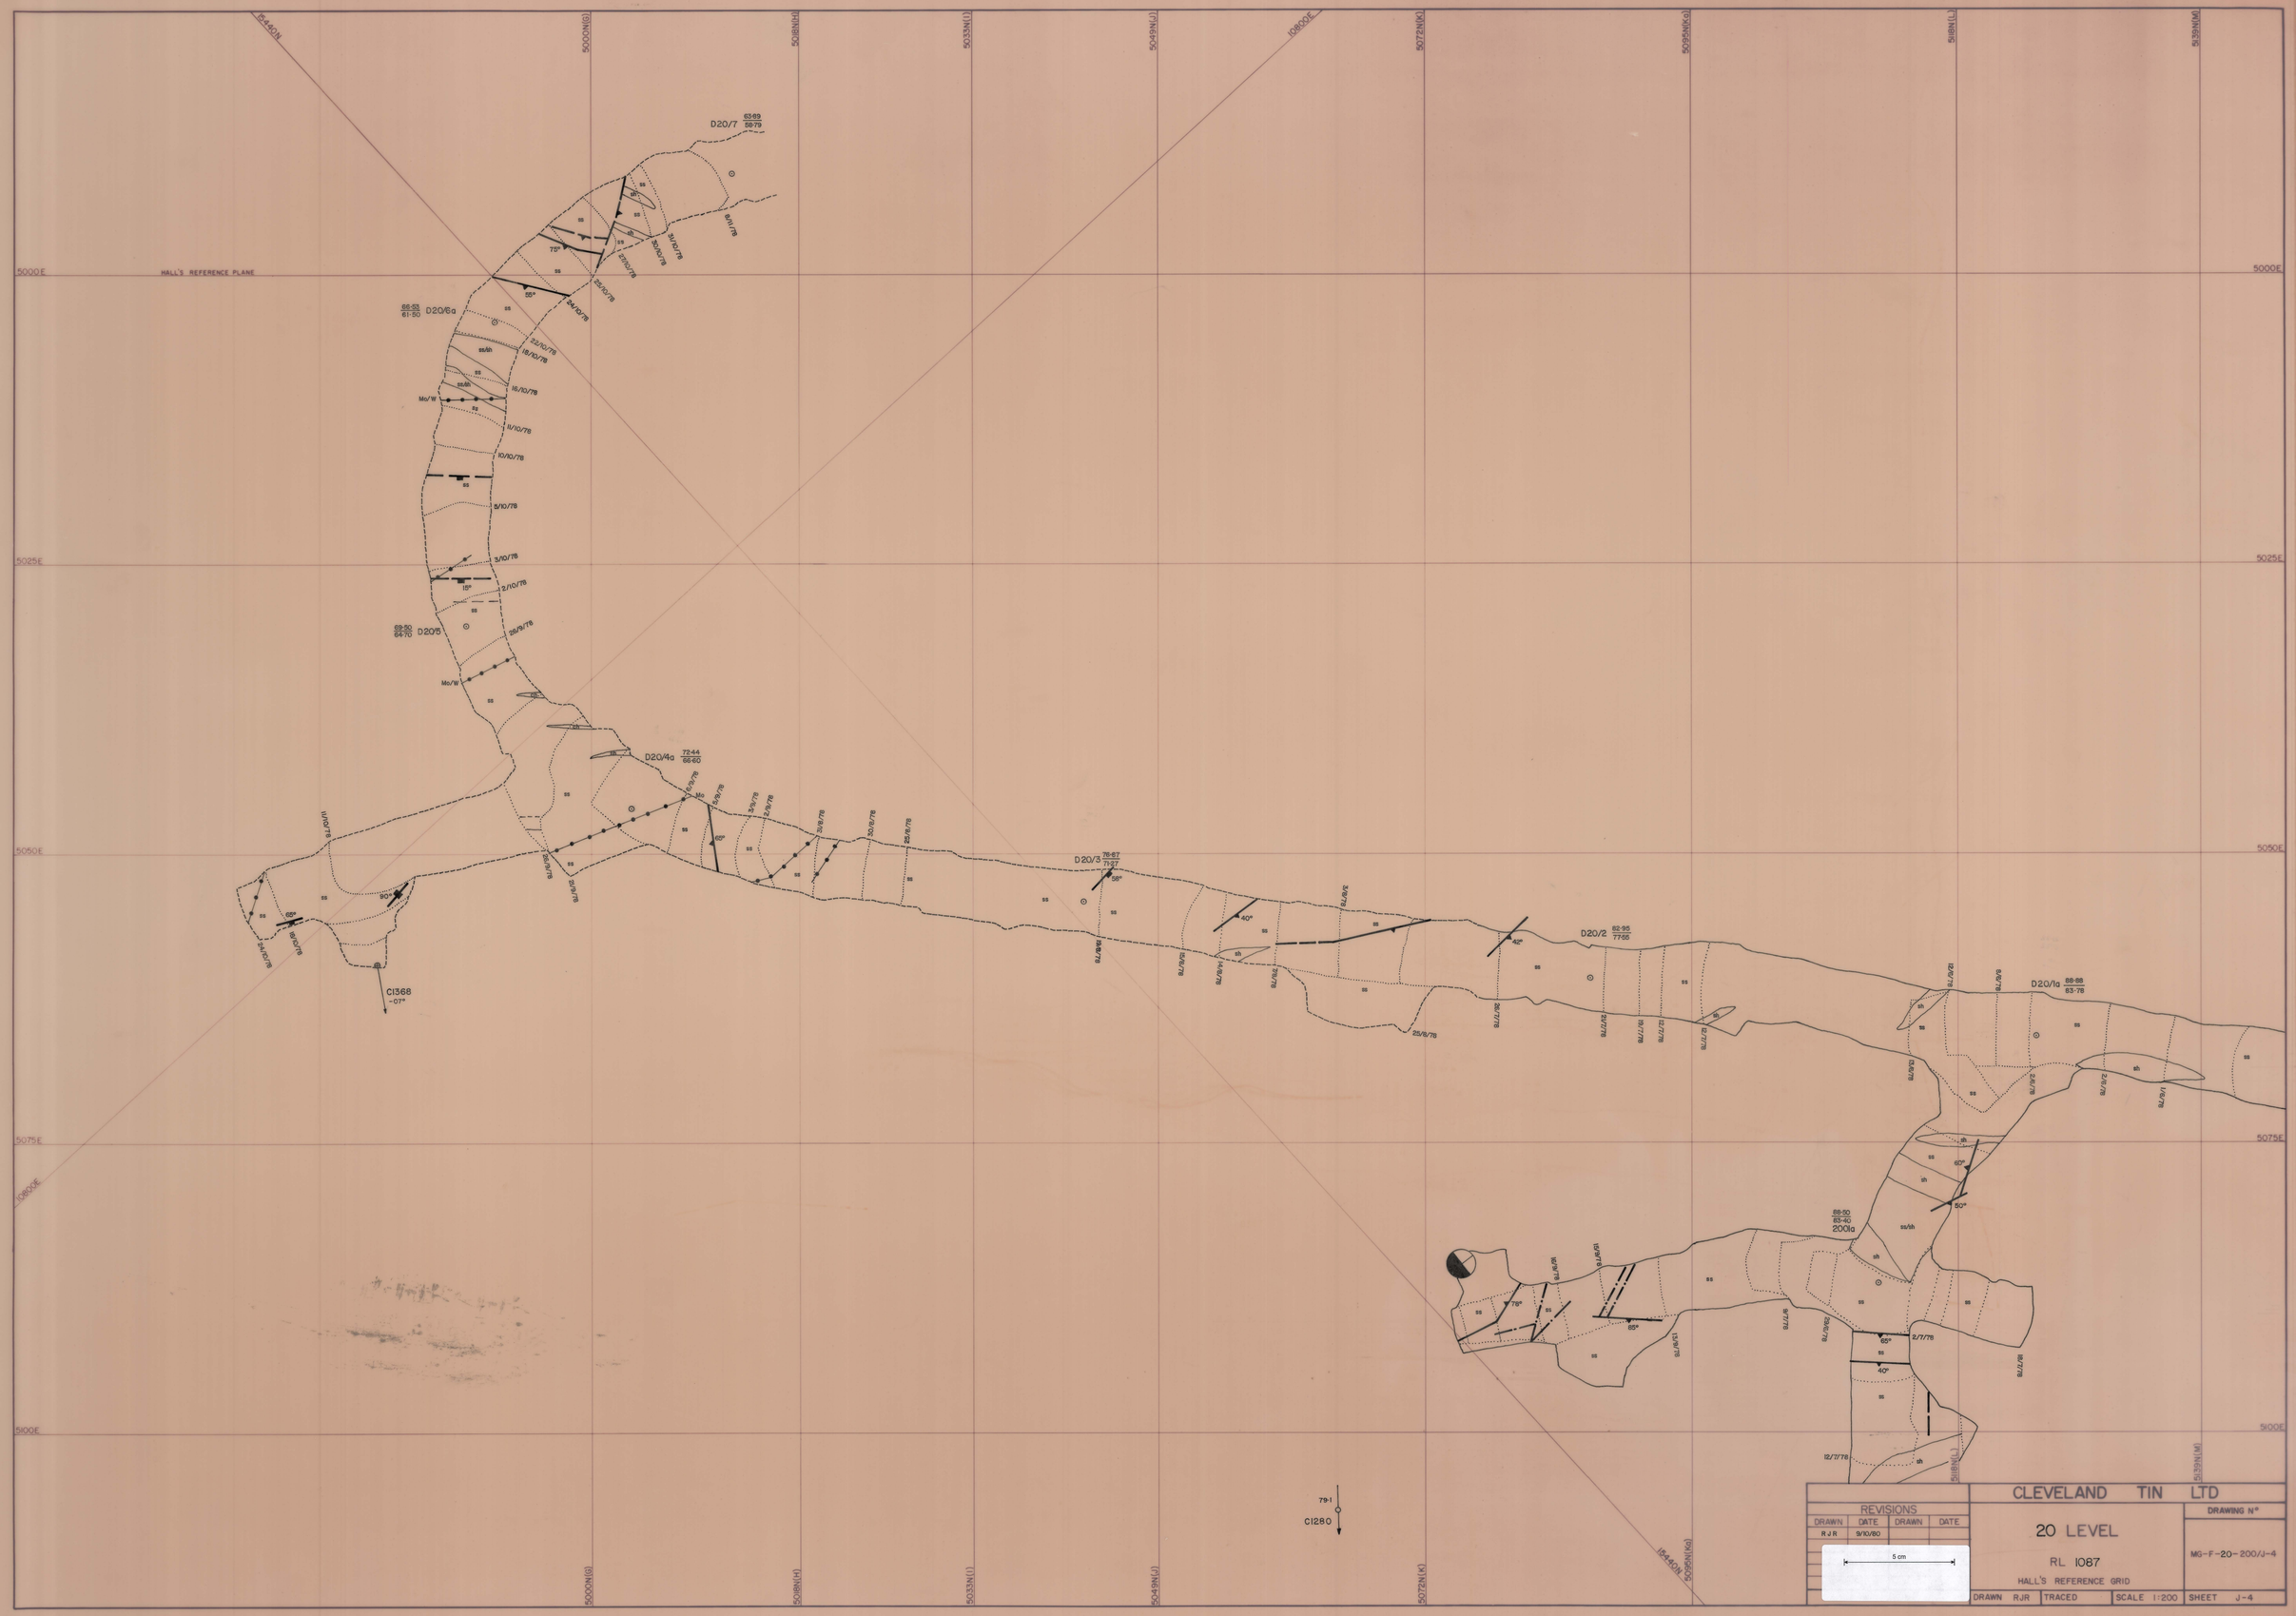
CLEVELAND TIN LTD
20 LEVEL
RL 1087
HALL'S REFERENCE GRID
DRAWING N°
MG-F-20-200/J-4
REVISIONS
DRAWN
DATE
R J R
9/10/80
5 cm
DRAWN RJR
TRACED
SCALE 1:200
SHEET J-4
HALL'S REFERENCE PLANE
5000E
5025E
5050E
5075E
5100E
10800E
15440N
5000N(G)
5008N(H)
5033N(J)
5049N(J)
5072N(K)
5095N(K)
5118N(L)
5135N(M)
D20/7
D20/6a
D20/5
D20/4a
D20/3
D20/2
D20/1a
200/a
C1368
-07°
C1280
79·1

0216_587