


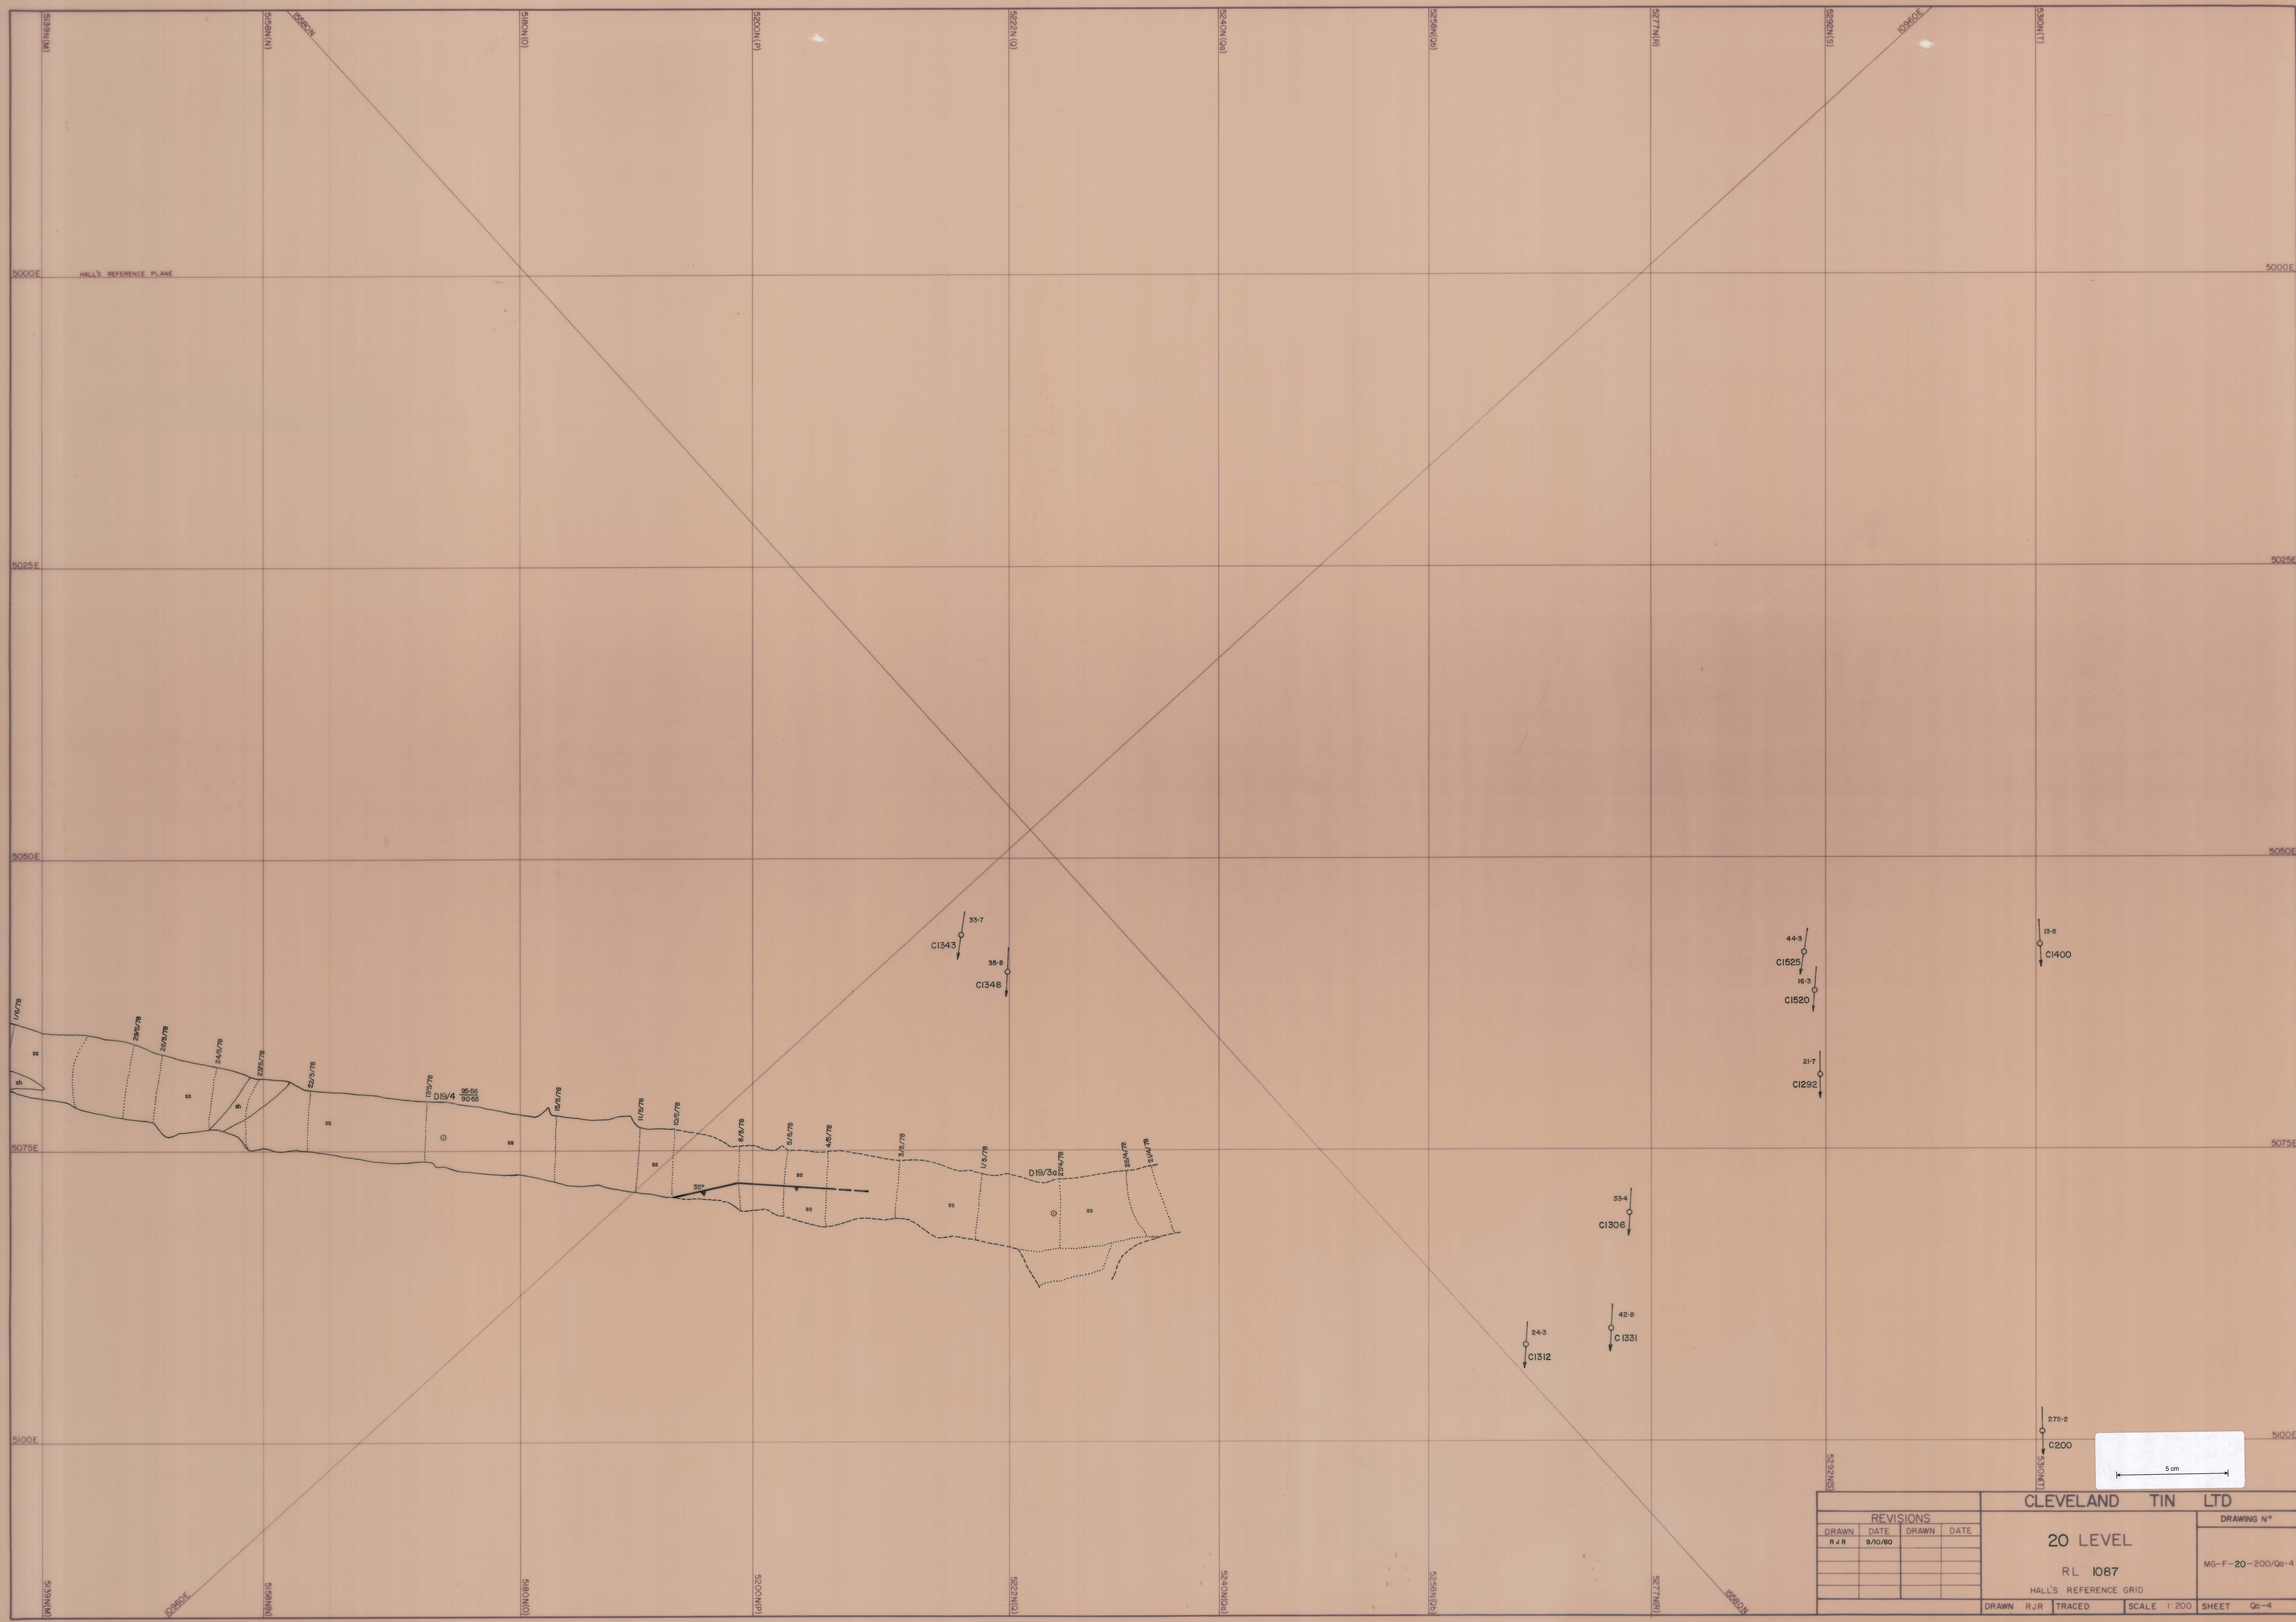

REVISIONS				CLEVELAND TIN LTD		DRAWING N°	
DRAWN	DATE	DRAWN	DATE	20 LEVEL		MG-F-20-200/Qa-4	
RJR	9/10/80						
				RL 1087		Qa-4	
				HALL'S REFERENCE GRID		SCALE 1:200	
				DRAWN RJR		SHEET	