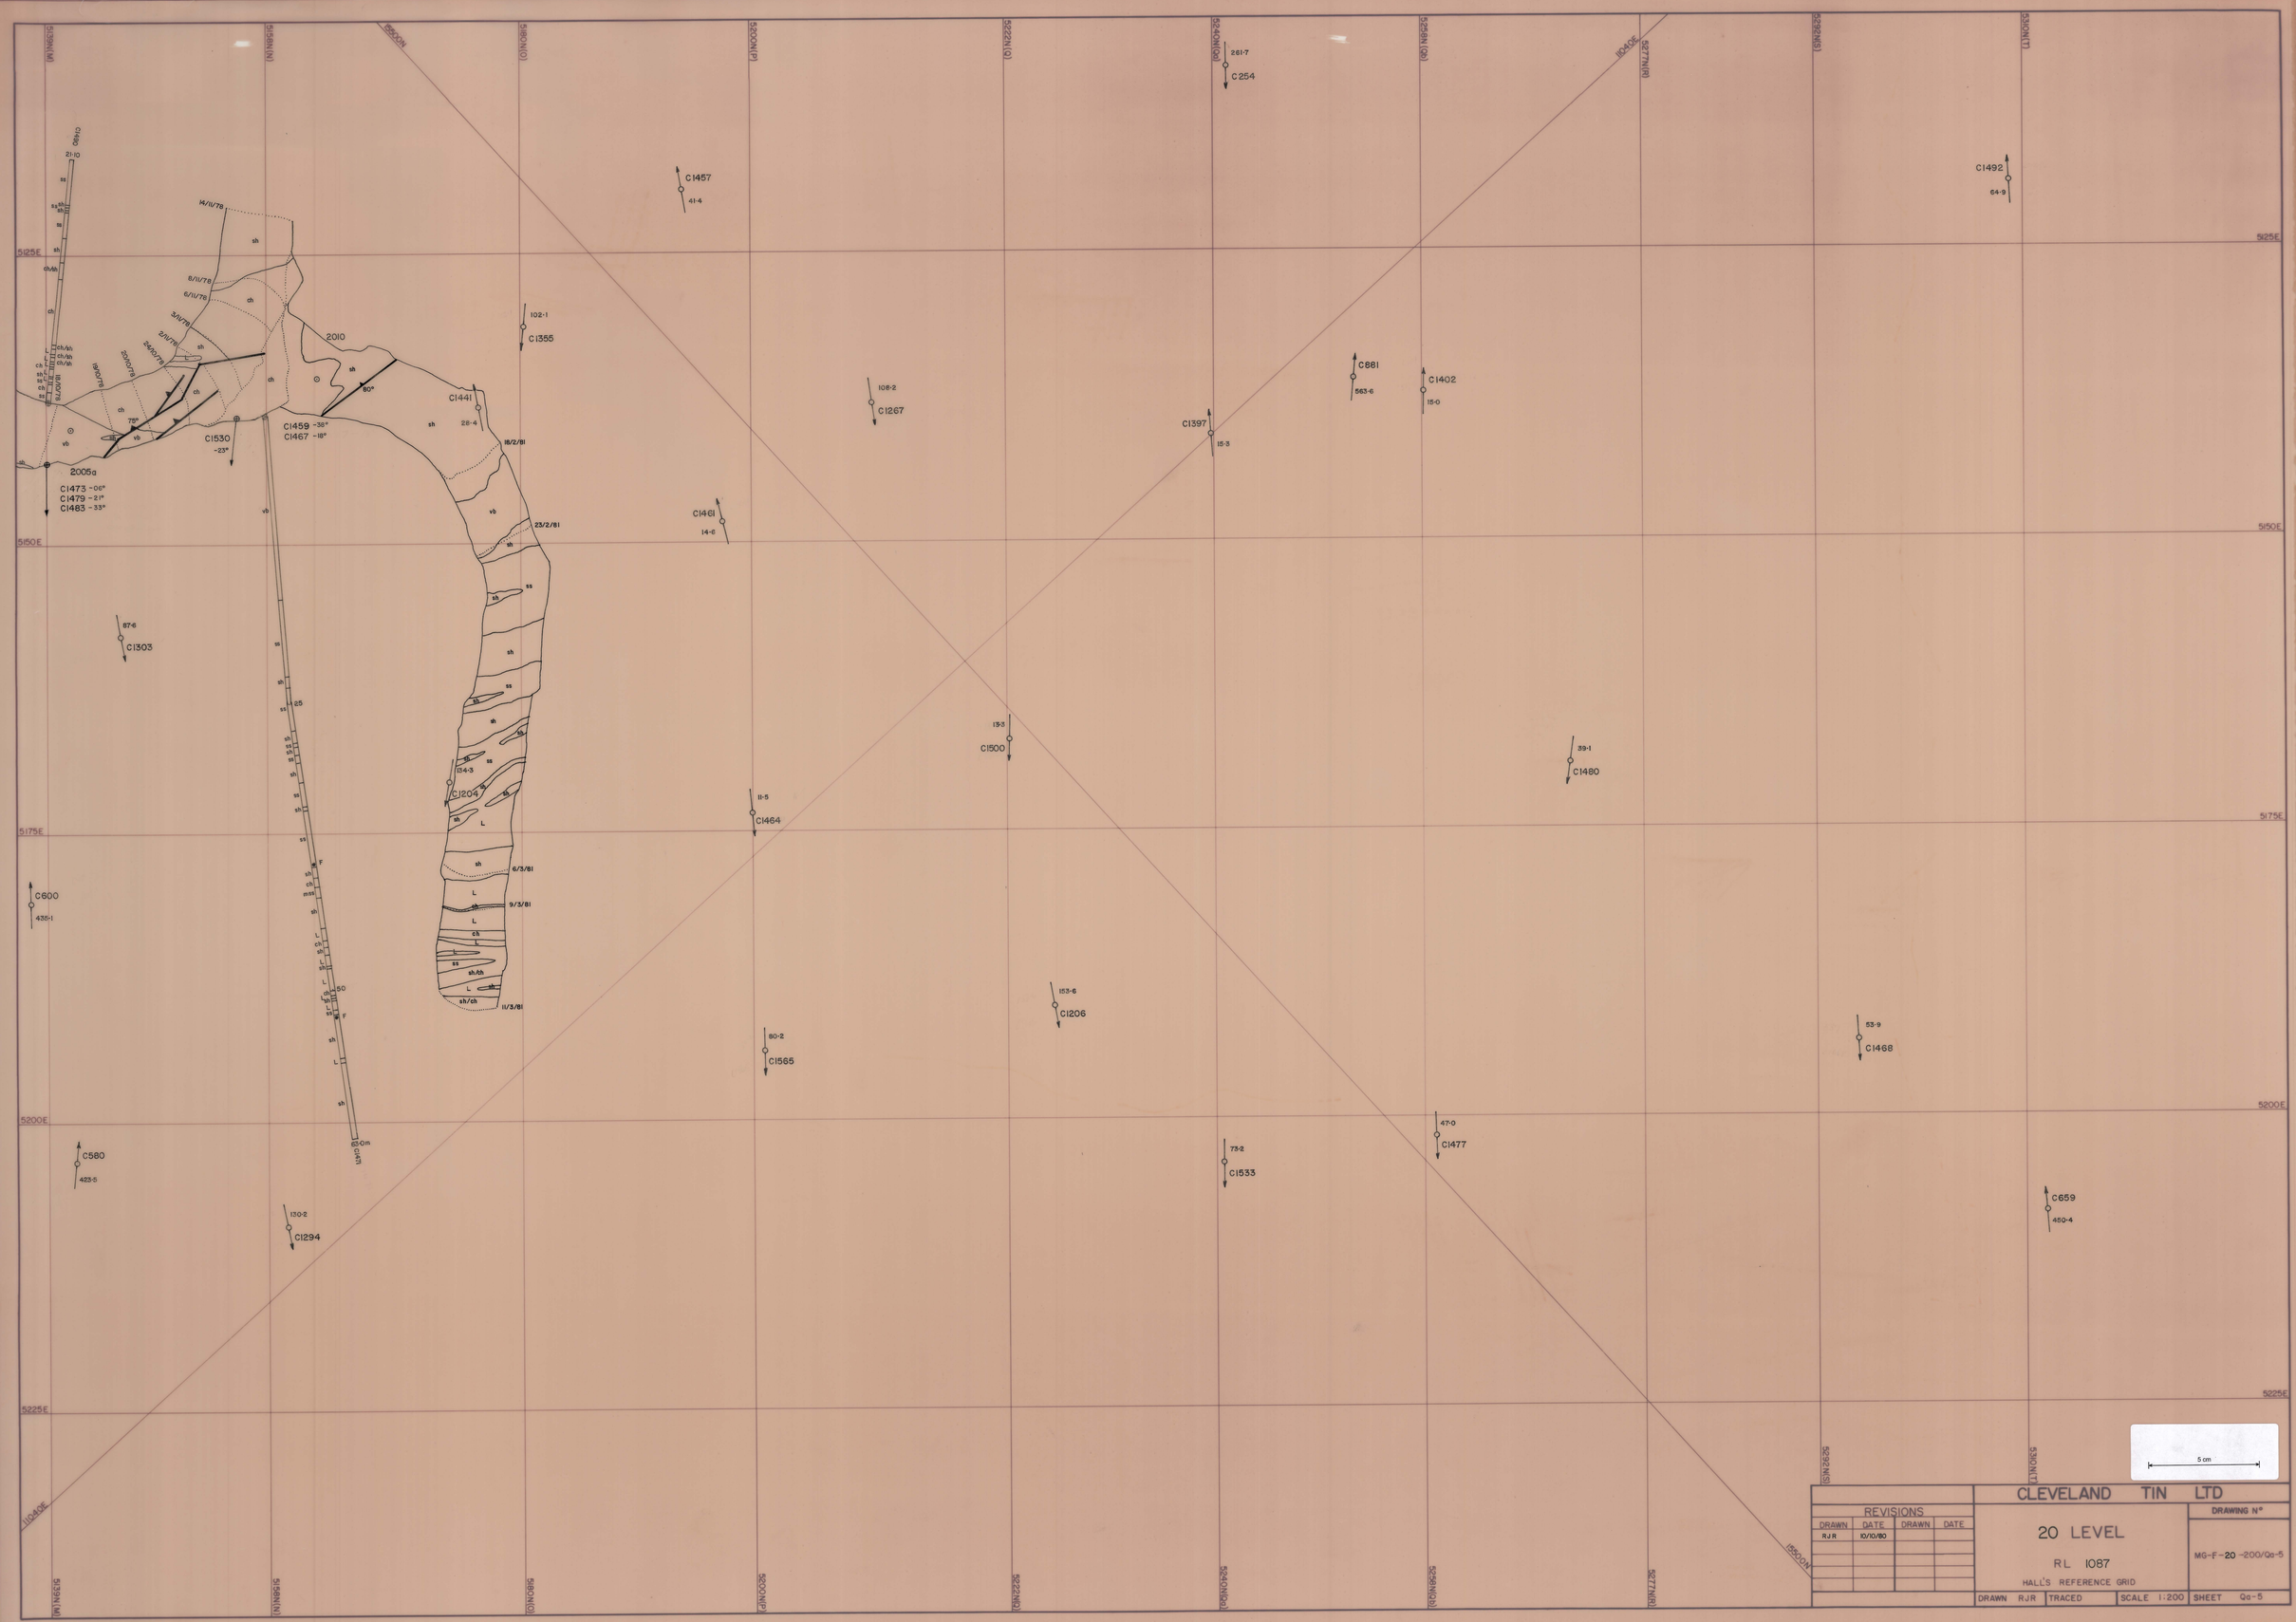
5125E
5150E
5175E
5200E
5225E
2010
2005a
C1473 -06°
C1479 -21°
C1483 -33°
C1459 -36°
C1467 -18°
C1530
-23°
C1441
28·4
18/2/81
23/2/81
6/3/81
9/3/81
11/3/81
C1204
154·3
C1303
67·6
C600
435·1
C580
423·6
C1294
130·2
C1355
102·1
C1457
41·4
C1267
108·2
C1461
14·6
C1500
13·3
C1464
11·5
C1206
153·6
C1565
80·2
C1397
15·3
C881
563·6
C1402
15·0
C1480
39·1
C1468
53·9
C1533
73·2
C1477
47·0
C659
450·4
C1492
64·9
C254
261·7
5 cm
CLEVELAND TIN LTD
REVISIONS
DRAWN DATE DRAWN DATE
RJR 10/10/80
20 LEVEL
RL 1087
HALL'S REFERENCE GRID
DRAWING N°
MG-F-20-200/Qa-5
DRAWN RJR TRACED SCALE 1:200 SHEET Qa-5

0216_590