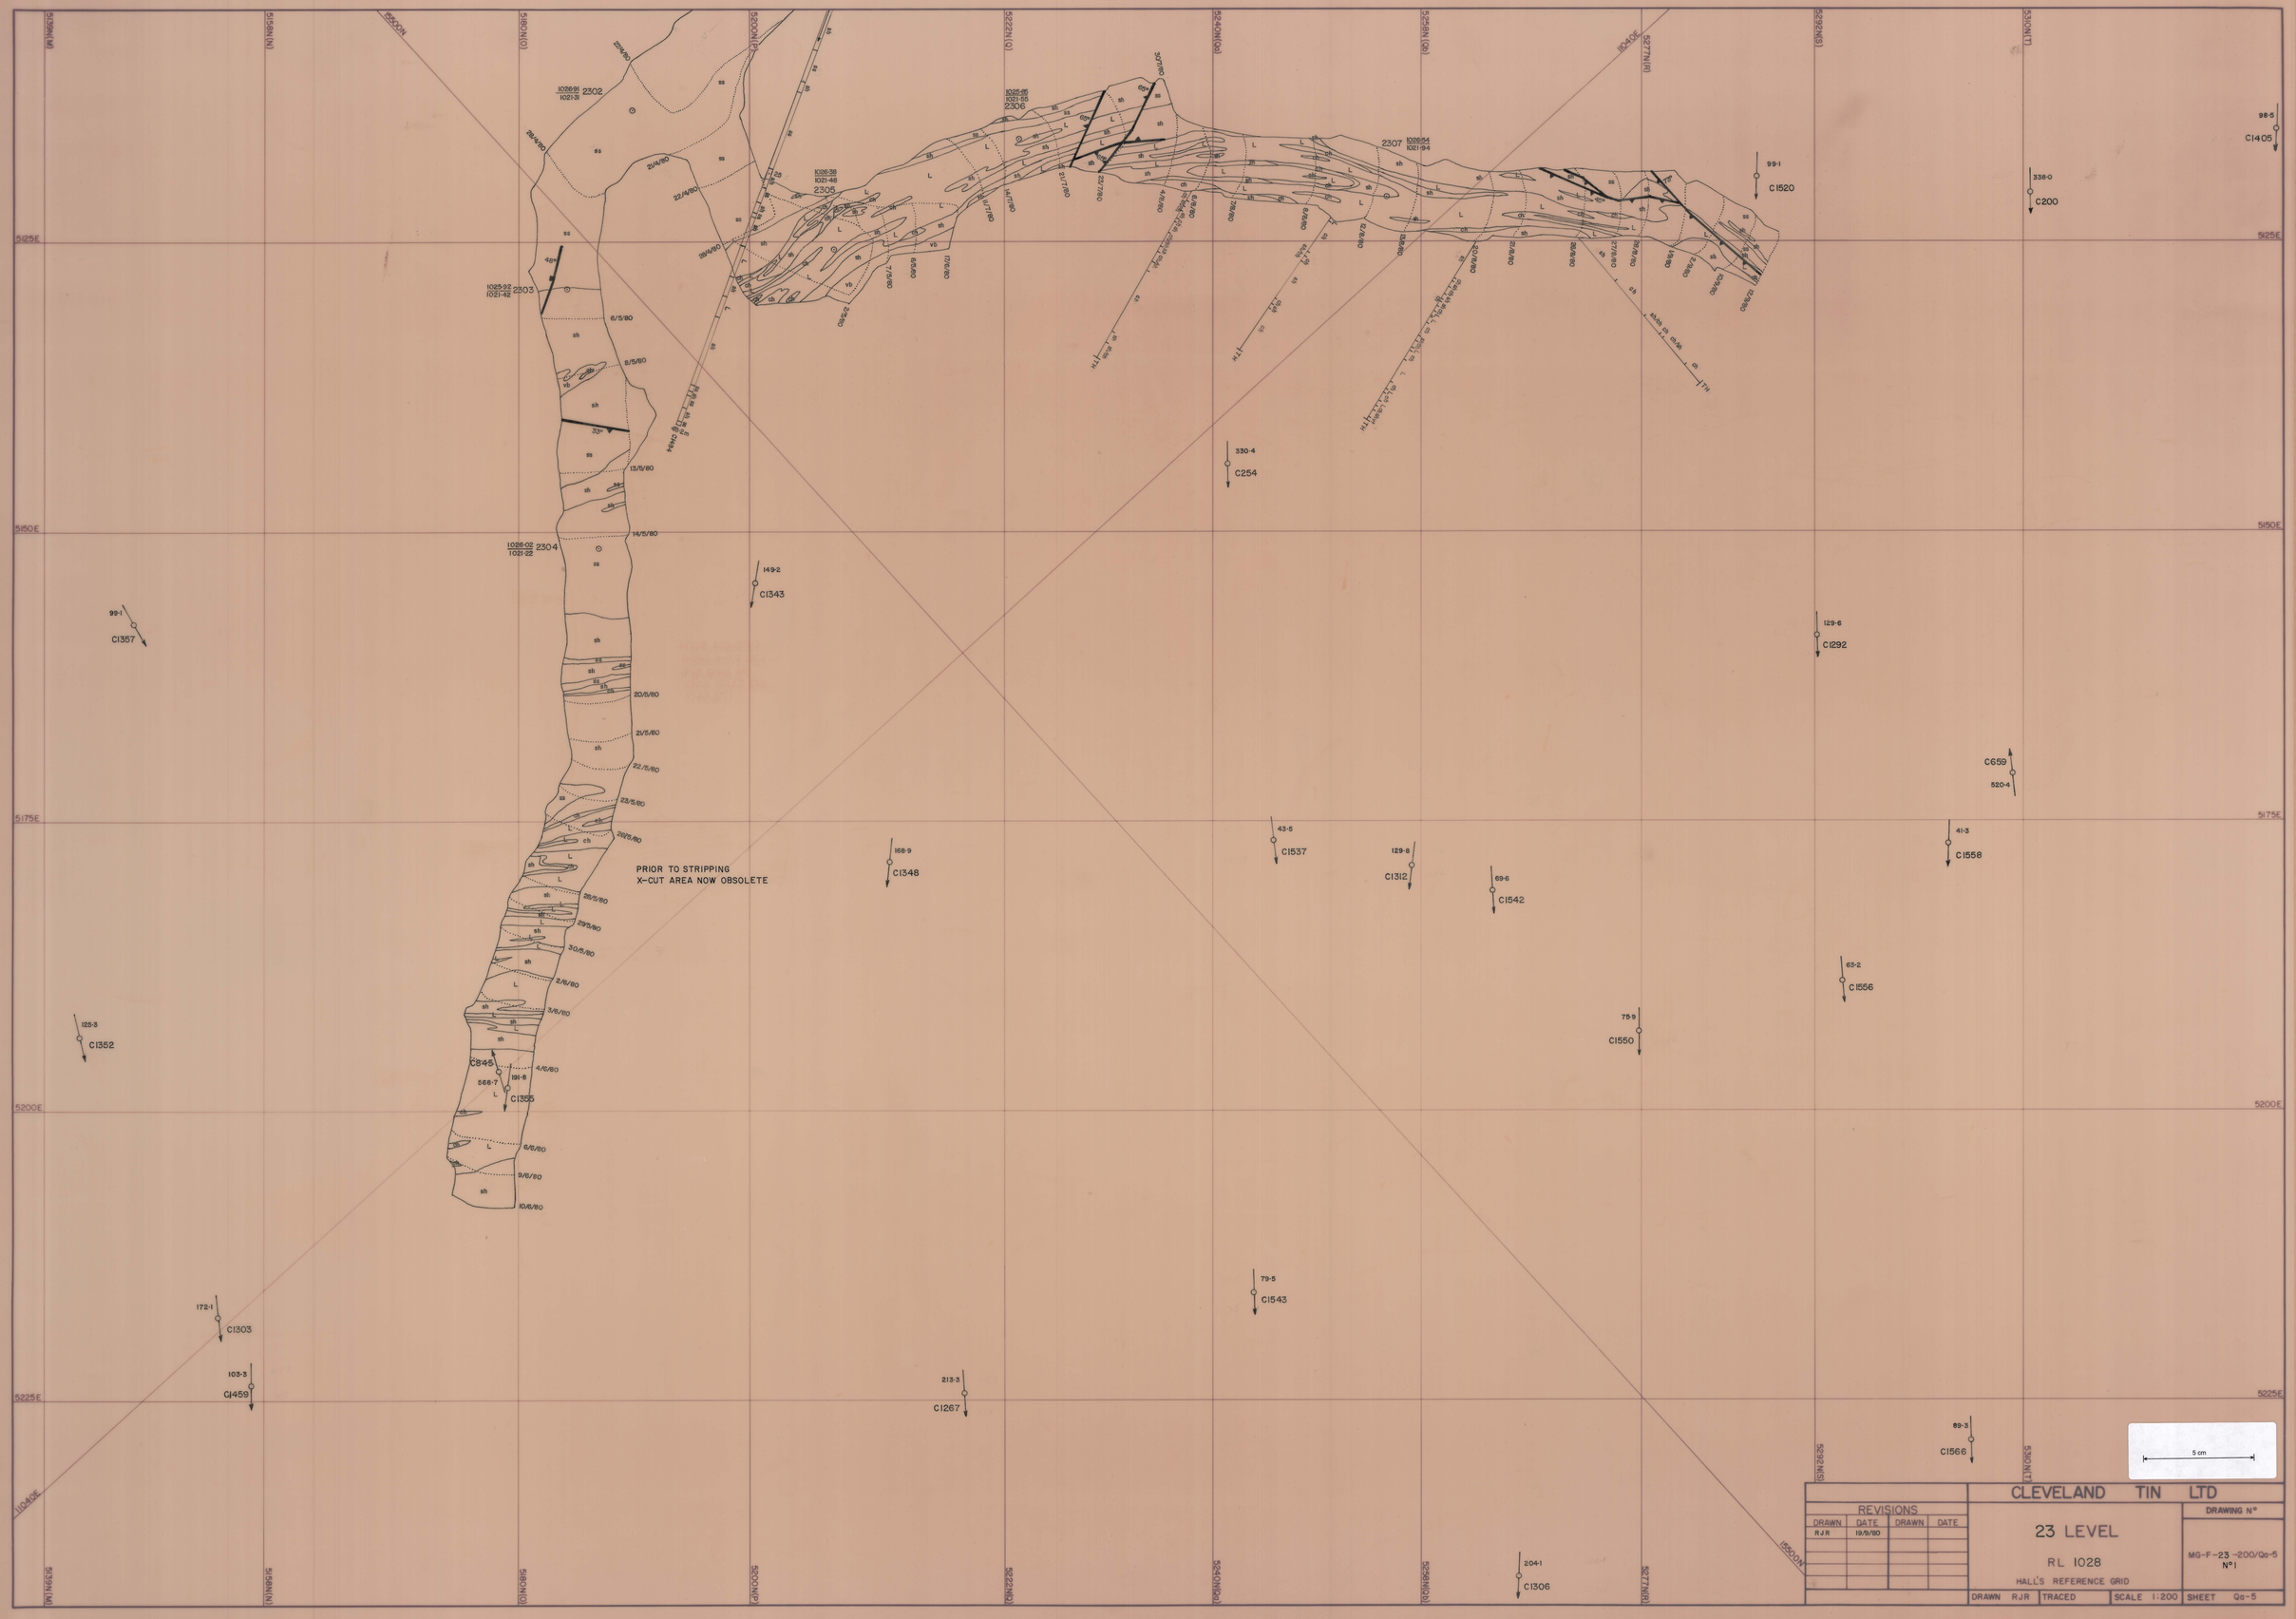
5125E
5150E
5175E
5200E
5225E
PRIOR TO STRIPPING
X-CUT AREA NOW OBSOLETE
2302
2303
2304
2305
2306
2307
C1520
C1405
C200
C254
C1343
C1357
C1292
C659
C1558
C1348
C1537
C1312
C1542
C1556
C1550
C1352
C1355
C1543
C1303
C1459
C1267
C1566
C1306
5 cm
CLEVELAND TIN LTD
REVISIONS
DRAWN
DATE
RJR
19/9/80
23 LEVEL
RL 1028
HALL'S REFERENCE GRID
DRAWING N°
MG-F-23 -200/Qa-5
N°1
DRAWN RJR
TRACED
SCALE 1:200
SHEET Qa-5

0216_597