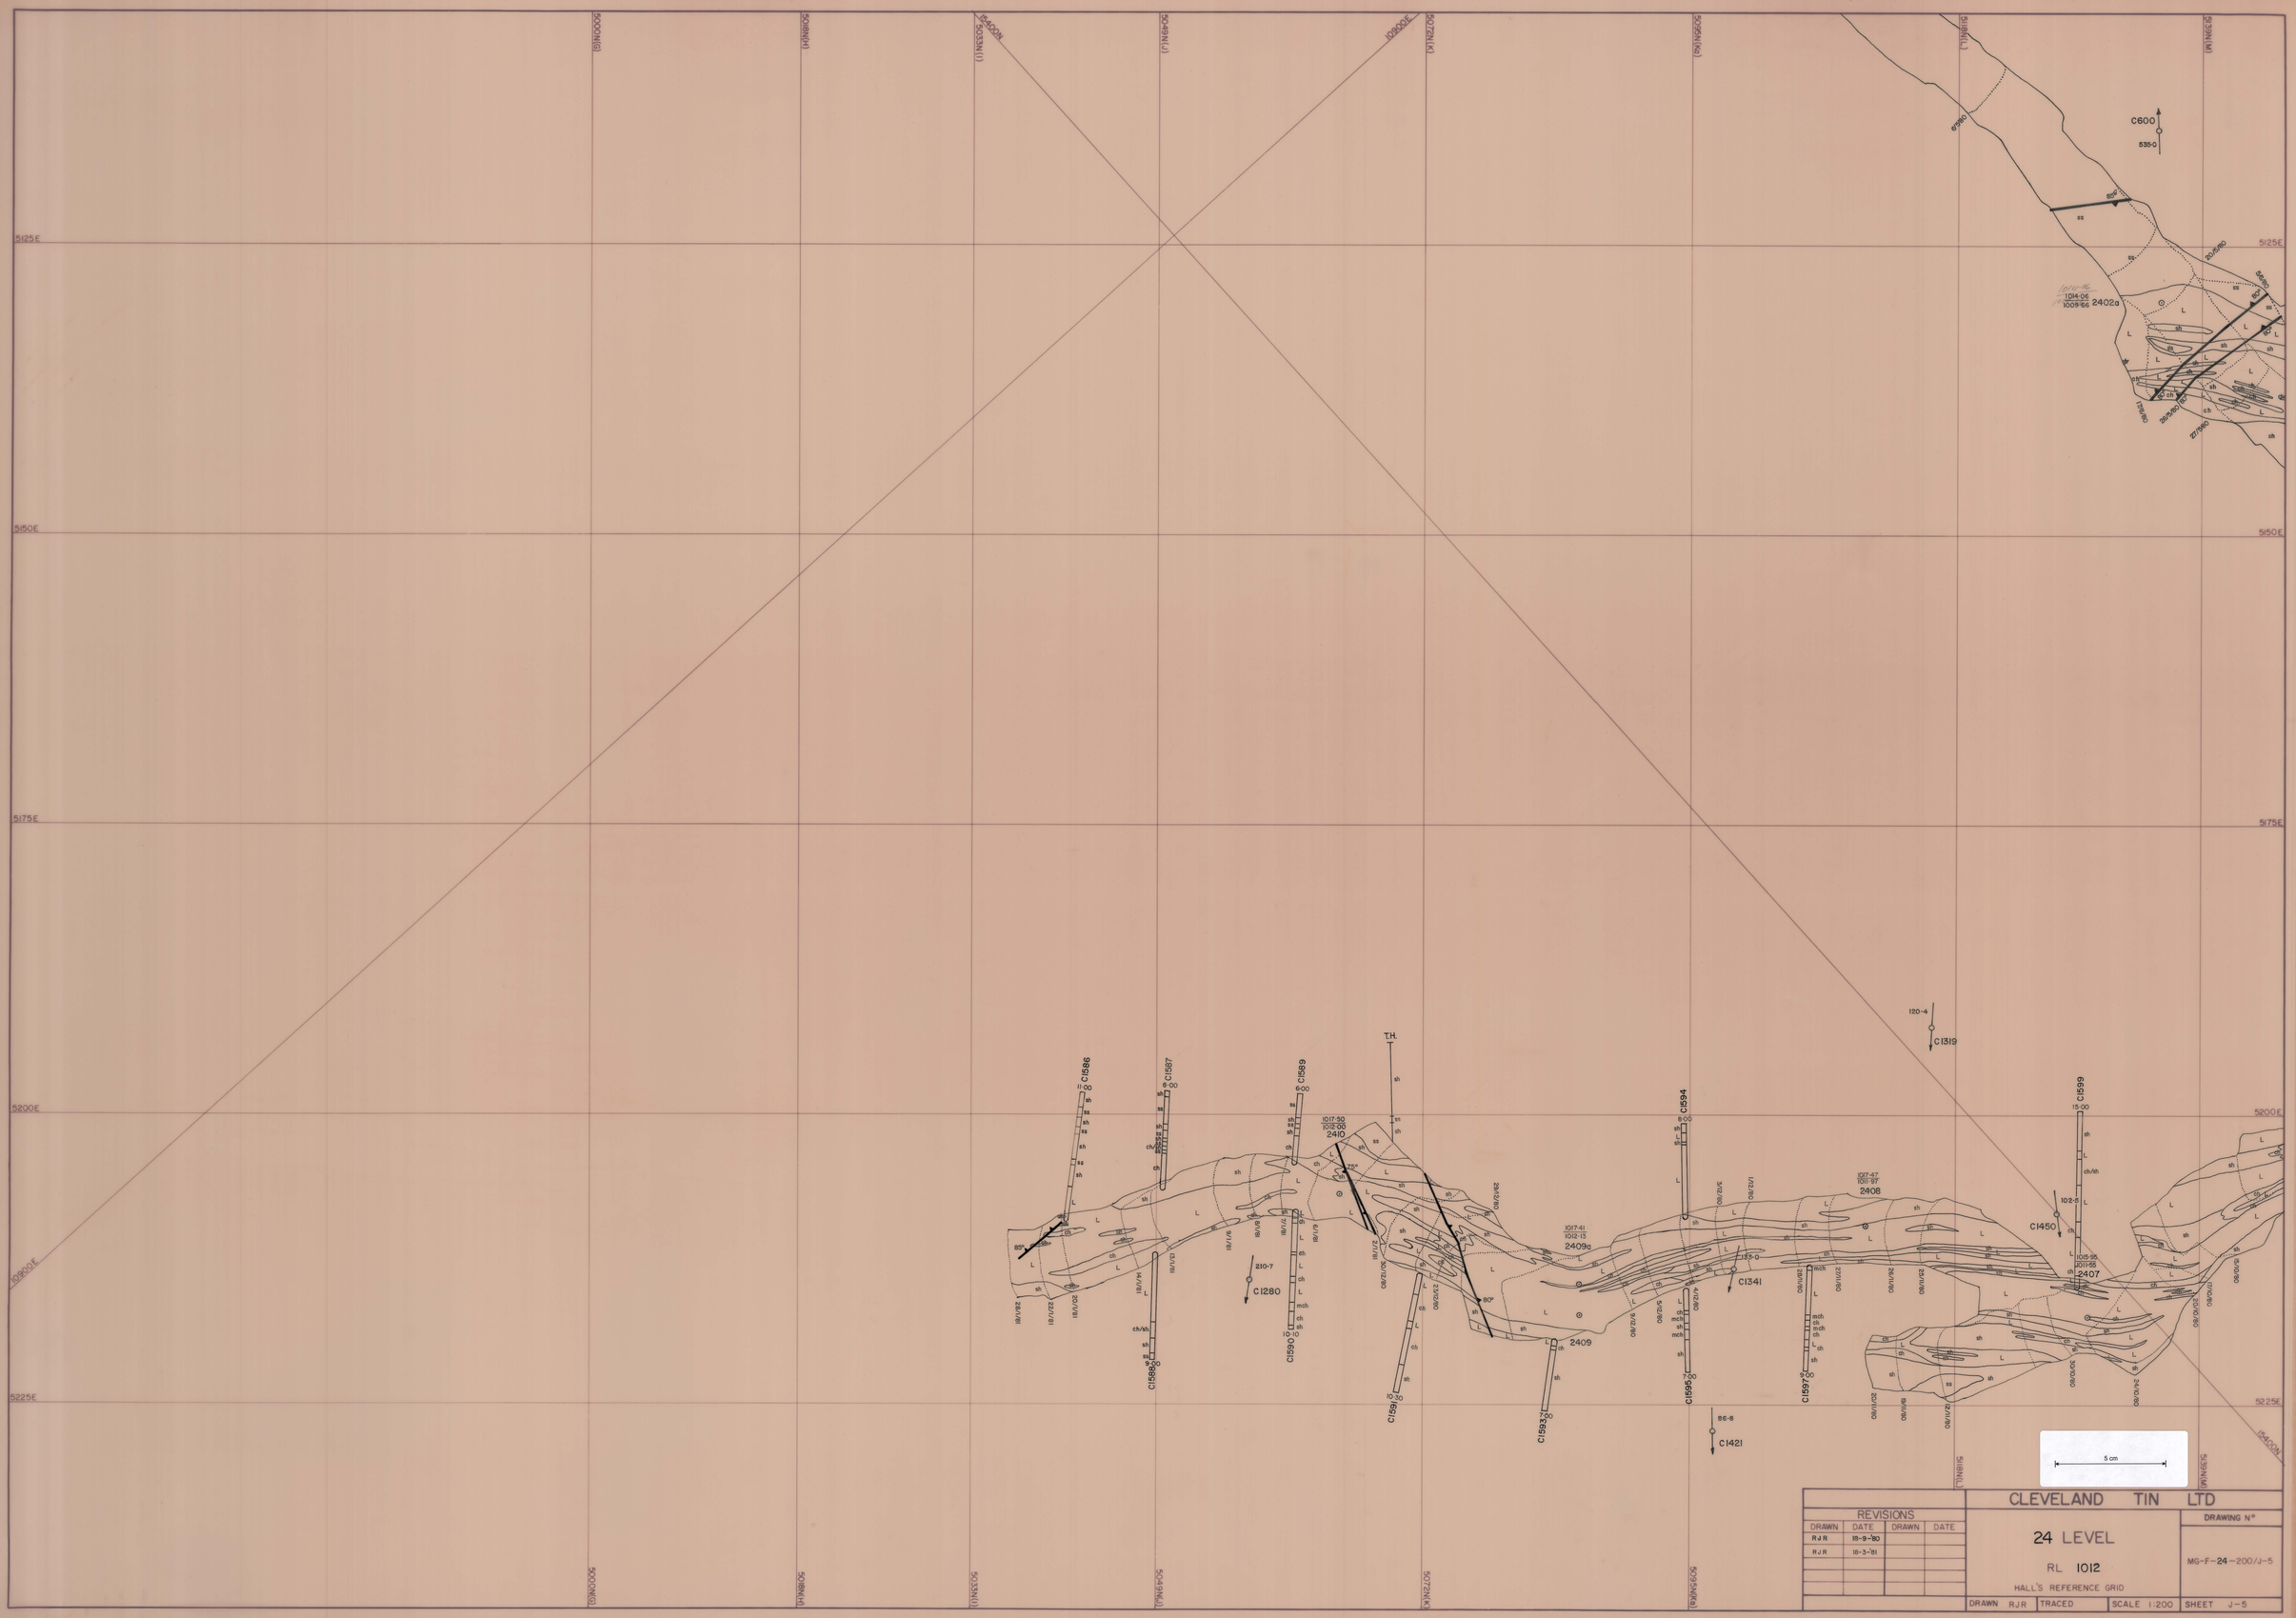
5125E
5150E
5175E
5200E
5225E
C600
535·0
2402a
1014·06
1008·86
C1586
C1587
C1589
C1588
C1590
C1591
C1592
C1593
C1594
C1595
C1597
C1319
C1450
C1341
C1421
C1280
T.H.
2410
2409e
2409
2408
2407
1017·50
1012·50
1017·41
1012·13
1017·47
1011·97
1015·96
1011·96
210·7
120·4
102·5
86·8
183·0
15·00
5 cm
REVISIONS
DRAWN
DATE
RJR
18-9-80
RJR
18-3-81
CLEVELAND TIN LTD
24 LEVEL
RL 1012
HALL'S REFERENCE GRID
DRAWING N°
MG-F-24-200/J-5
DRAWN RJR
TRACED
SCALE 1:200
SHEET J-5

0216_600