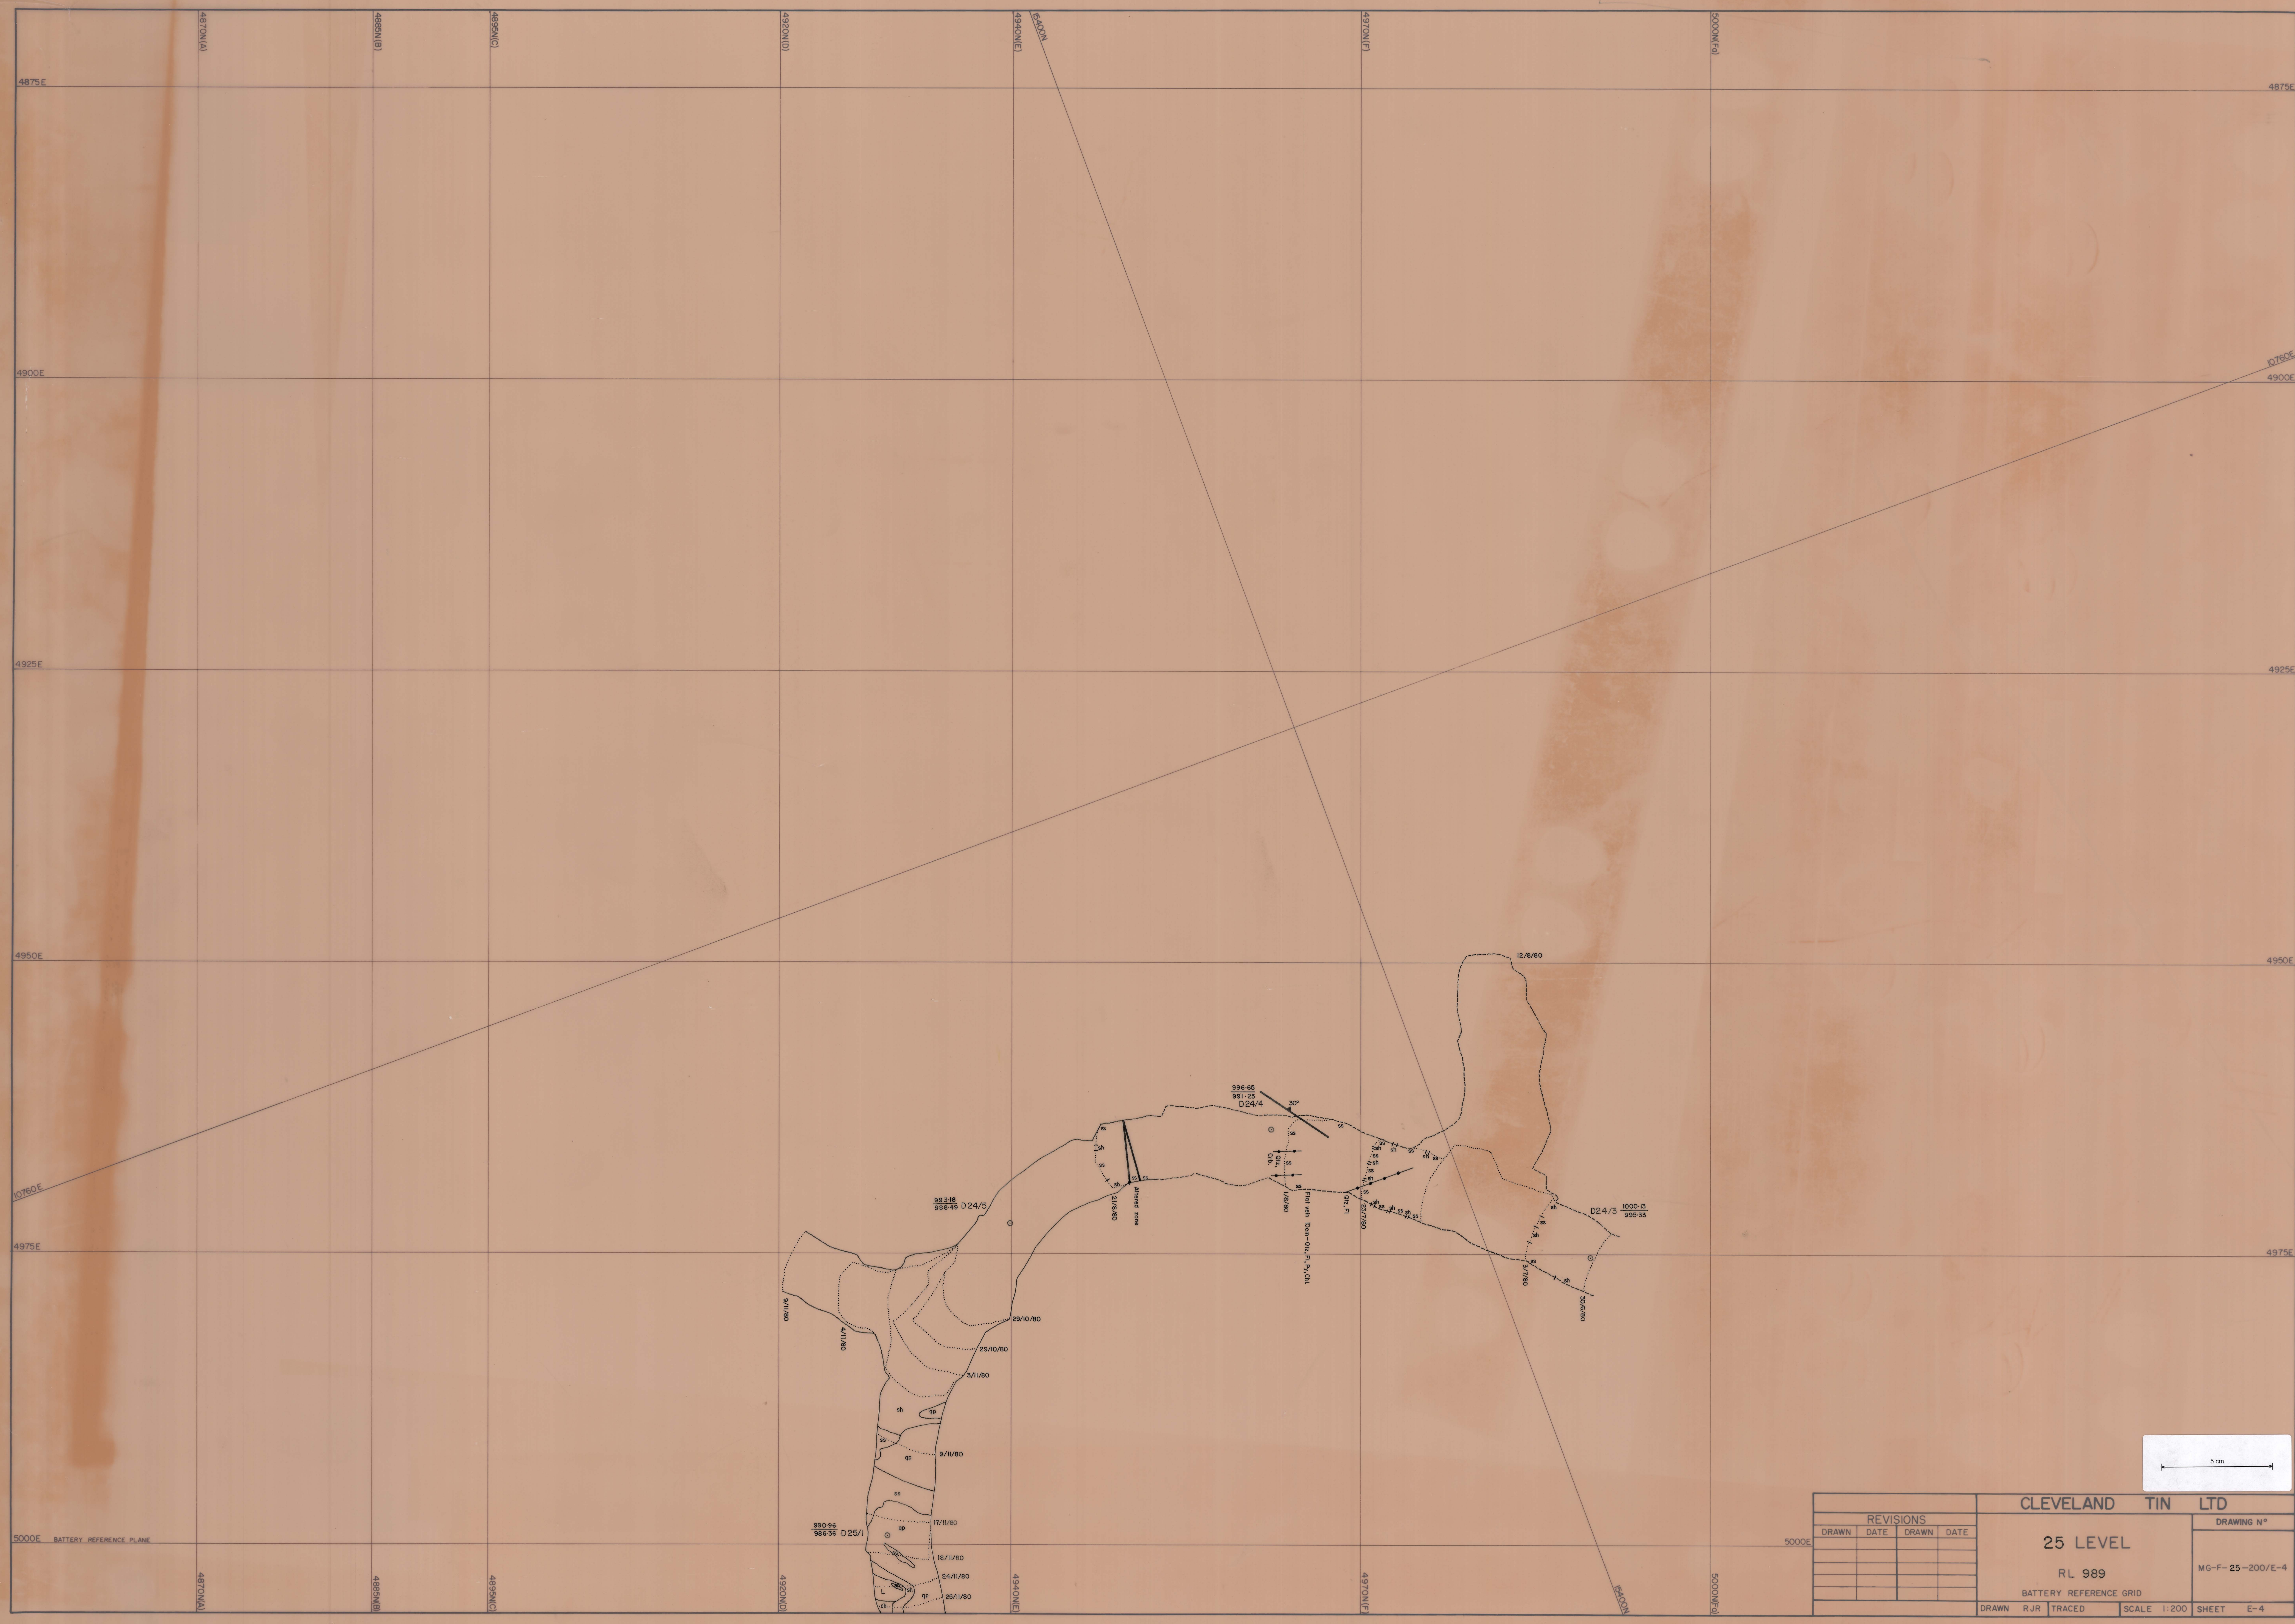
4870N(A)
4885N(B)
4895N(C)
4920N(D)
4940N(E)
15400N
4970N(F)
5000N(Fa)
4875E
4900E
4925E
4950E
4975E
5000E BATTERY REFERENCE PLANE
10760E
996·65
991·25
D24/4
30°
993·18
988·49 D24/5
990·96
986·36 D25/1
D24/3 1000·13
995·33
12/8/80
21/8/80
Altered zone
1/8/80
Flat vein 10cm–Qtz,Fl,Py,Chl.
Qtz, Crb.
Qtz, Fl.
23/7/80
3/7/80
30/6/80
9/11/80
4/11/80
29/10/80
29/10/80
3/11/80
9/11/80
17/11/80
18/11/80
24/11/80
25/11/80
ss
sh
qp
ch
L
CLEVELAND TIN LTD
REVISIONS
DRAWN DATE DRAWN DATE
DRAWING N°
25 LEVEL
RL 989
BATTERY REFERENCE GRID
MG-F-25-200/E-4
DRAWN RJR TRACED SCALE 1:200 SHEET E-4

5 cm
0216_603