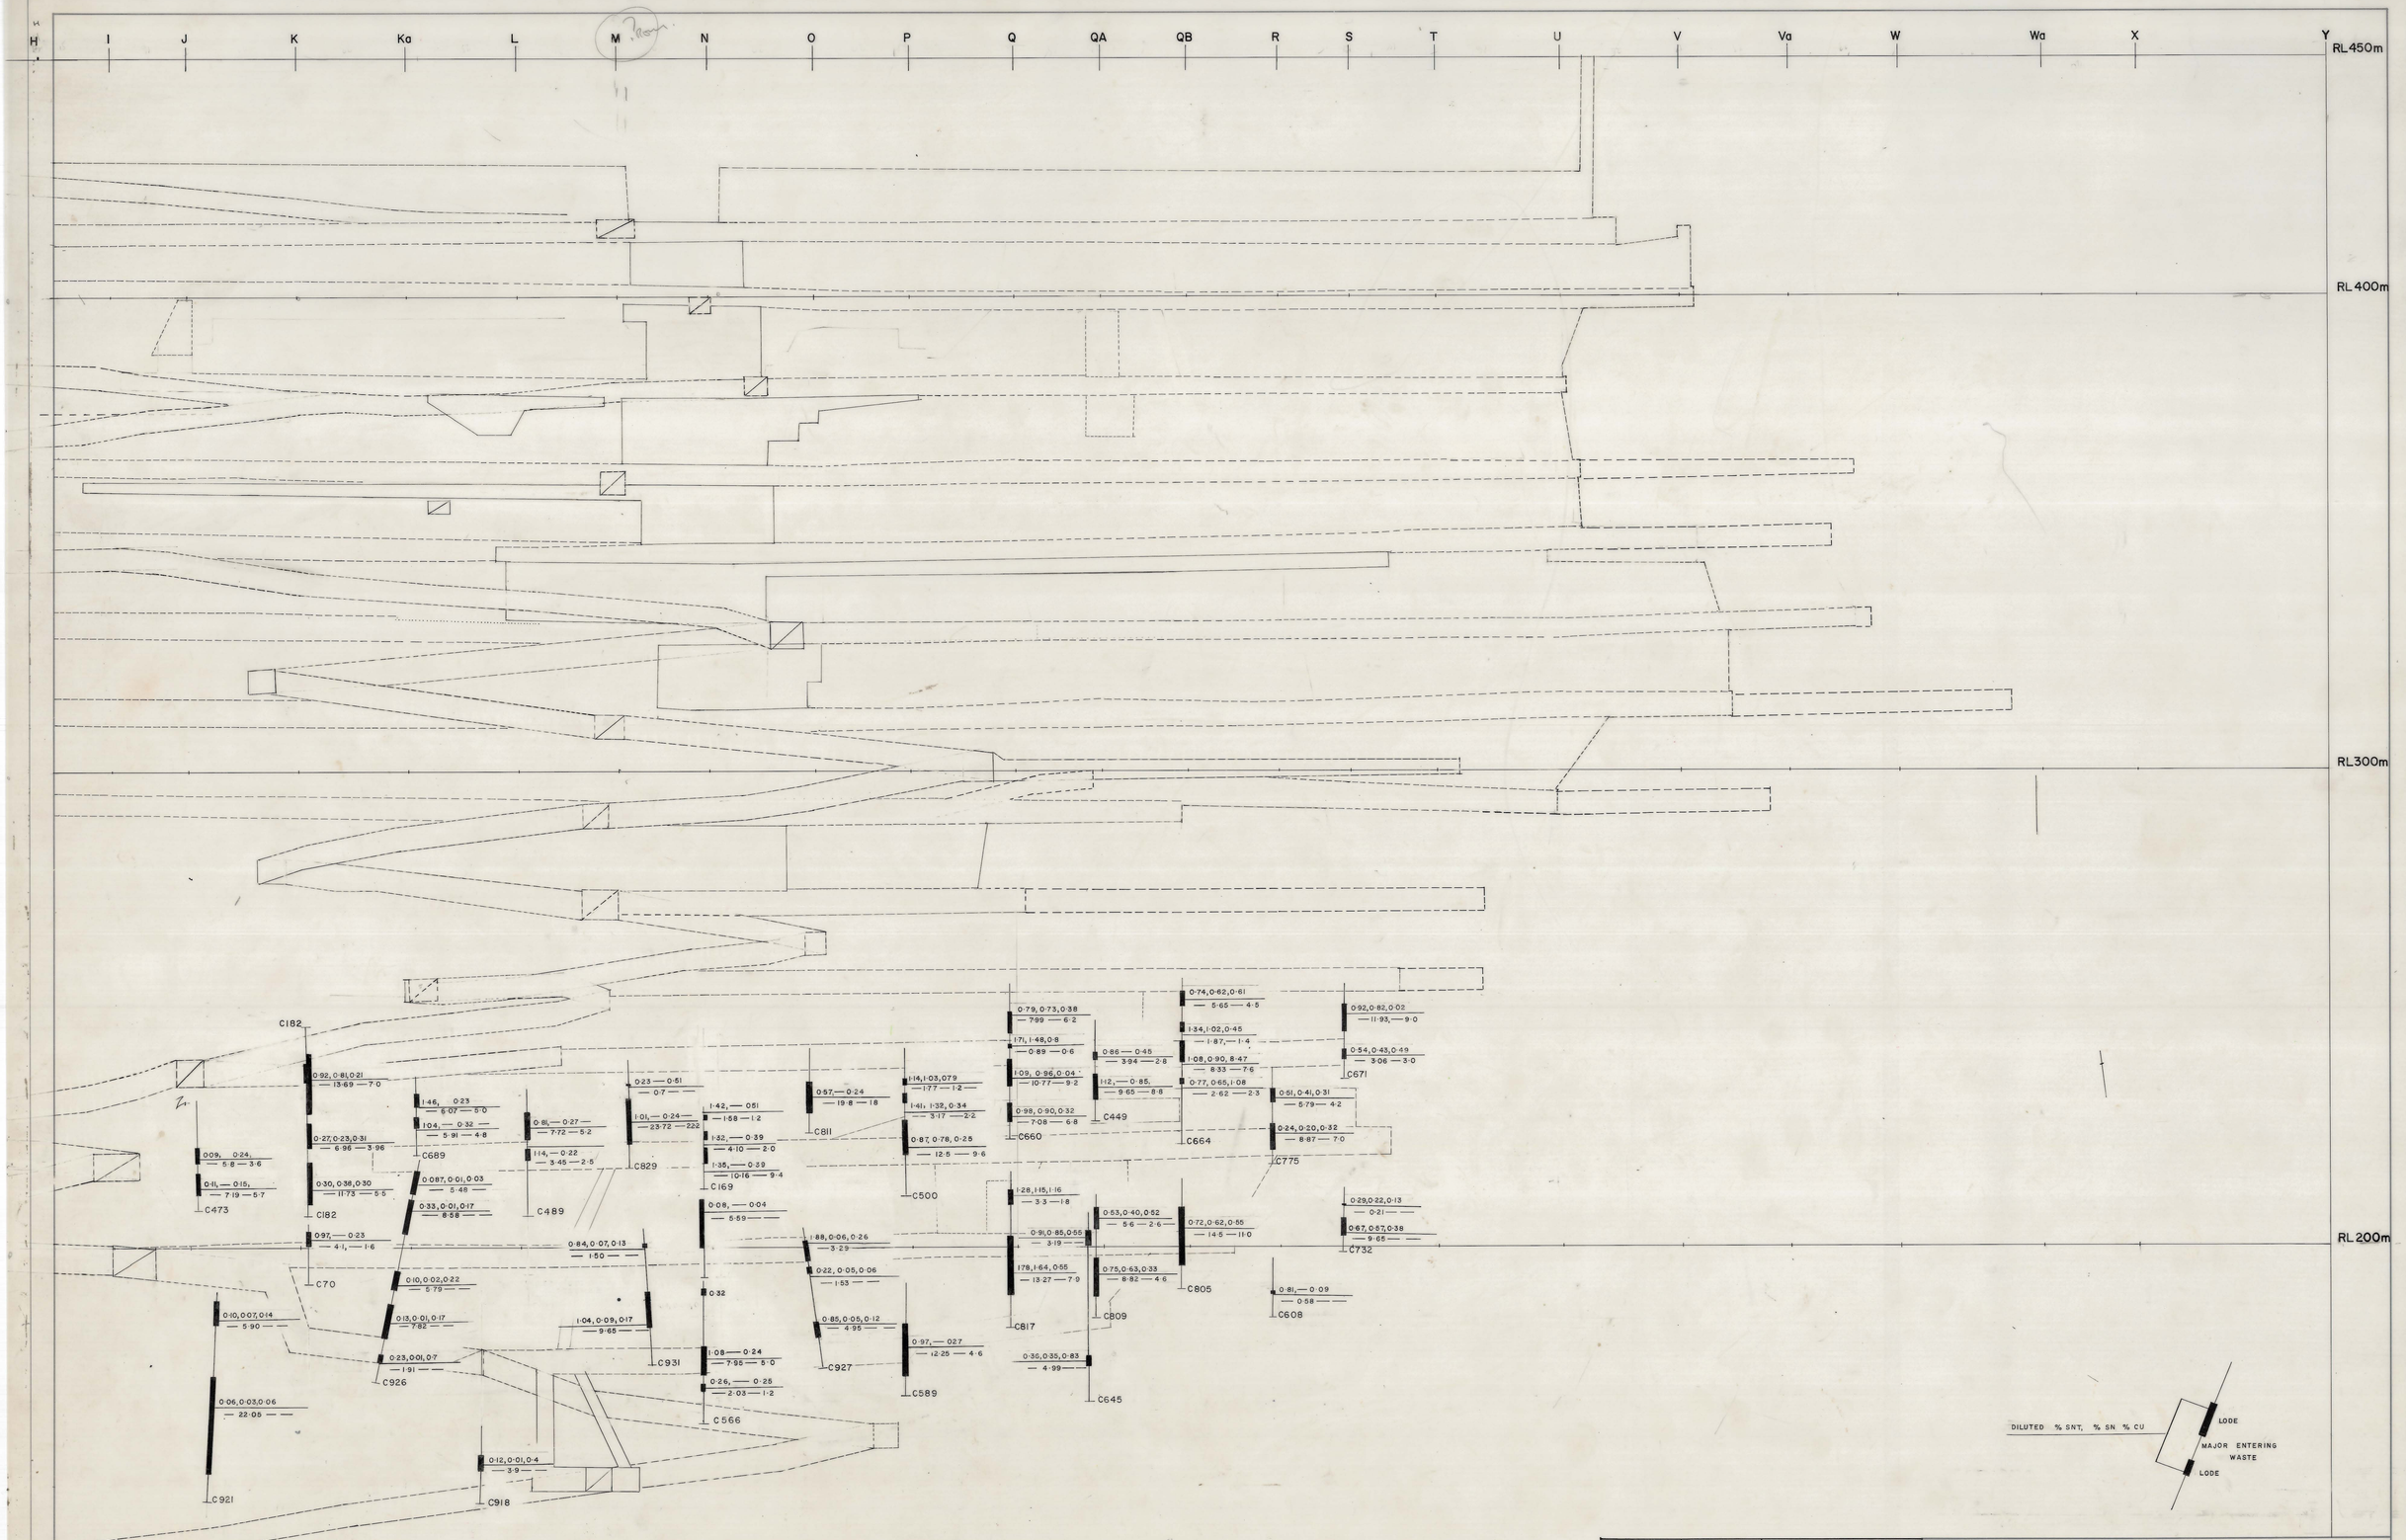

REFERENCES	INFORMATION	APPROVALS		CLEVELAND TIN L.T.D.			
		MINE SUPT/		Surveyed:	CLEVELAND MINE LONGITUDINAL PROJECTION B LENS		Drawing Nº
		MINE PROJ. SUPT		Drawn:			
		MINE CAPT		Traced:			
		SEN MINE ENG		Checked:			
		SEN. MINE ENG		App'd C/Surv.			
				App'd M/Supt.	Scale:	Date:	Sheet: b

0216_606