0216_727

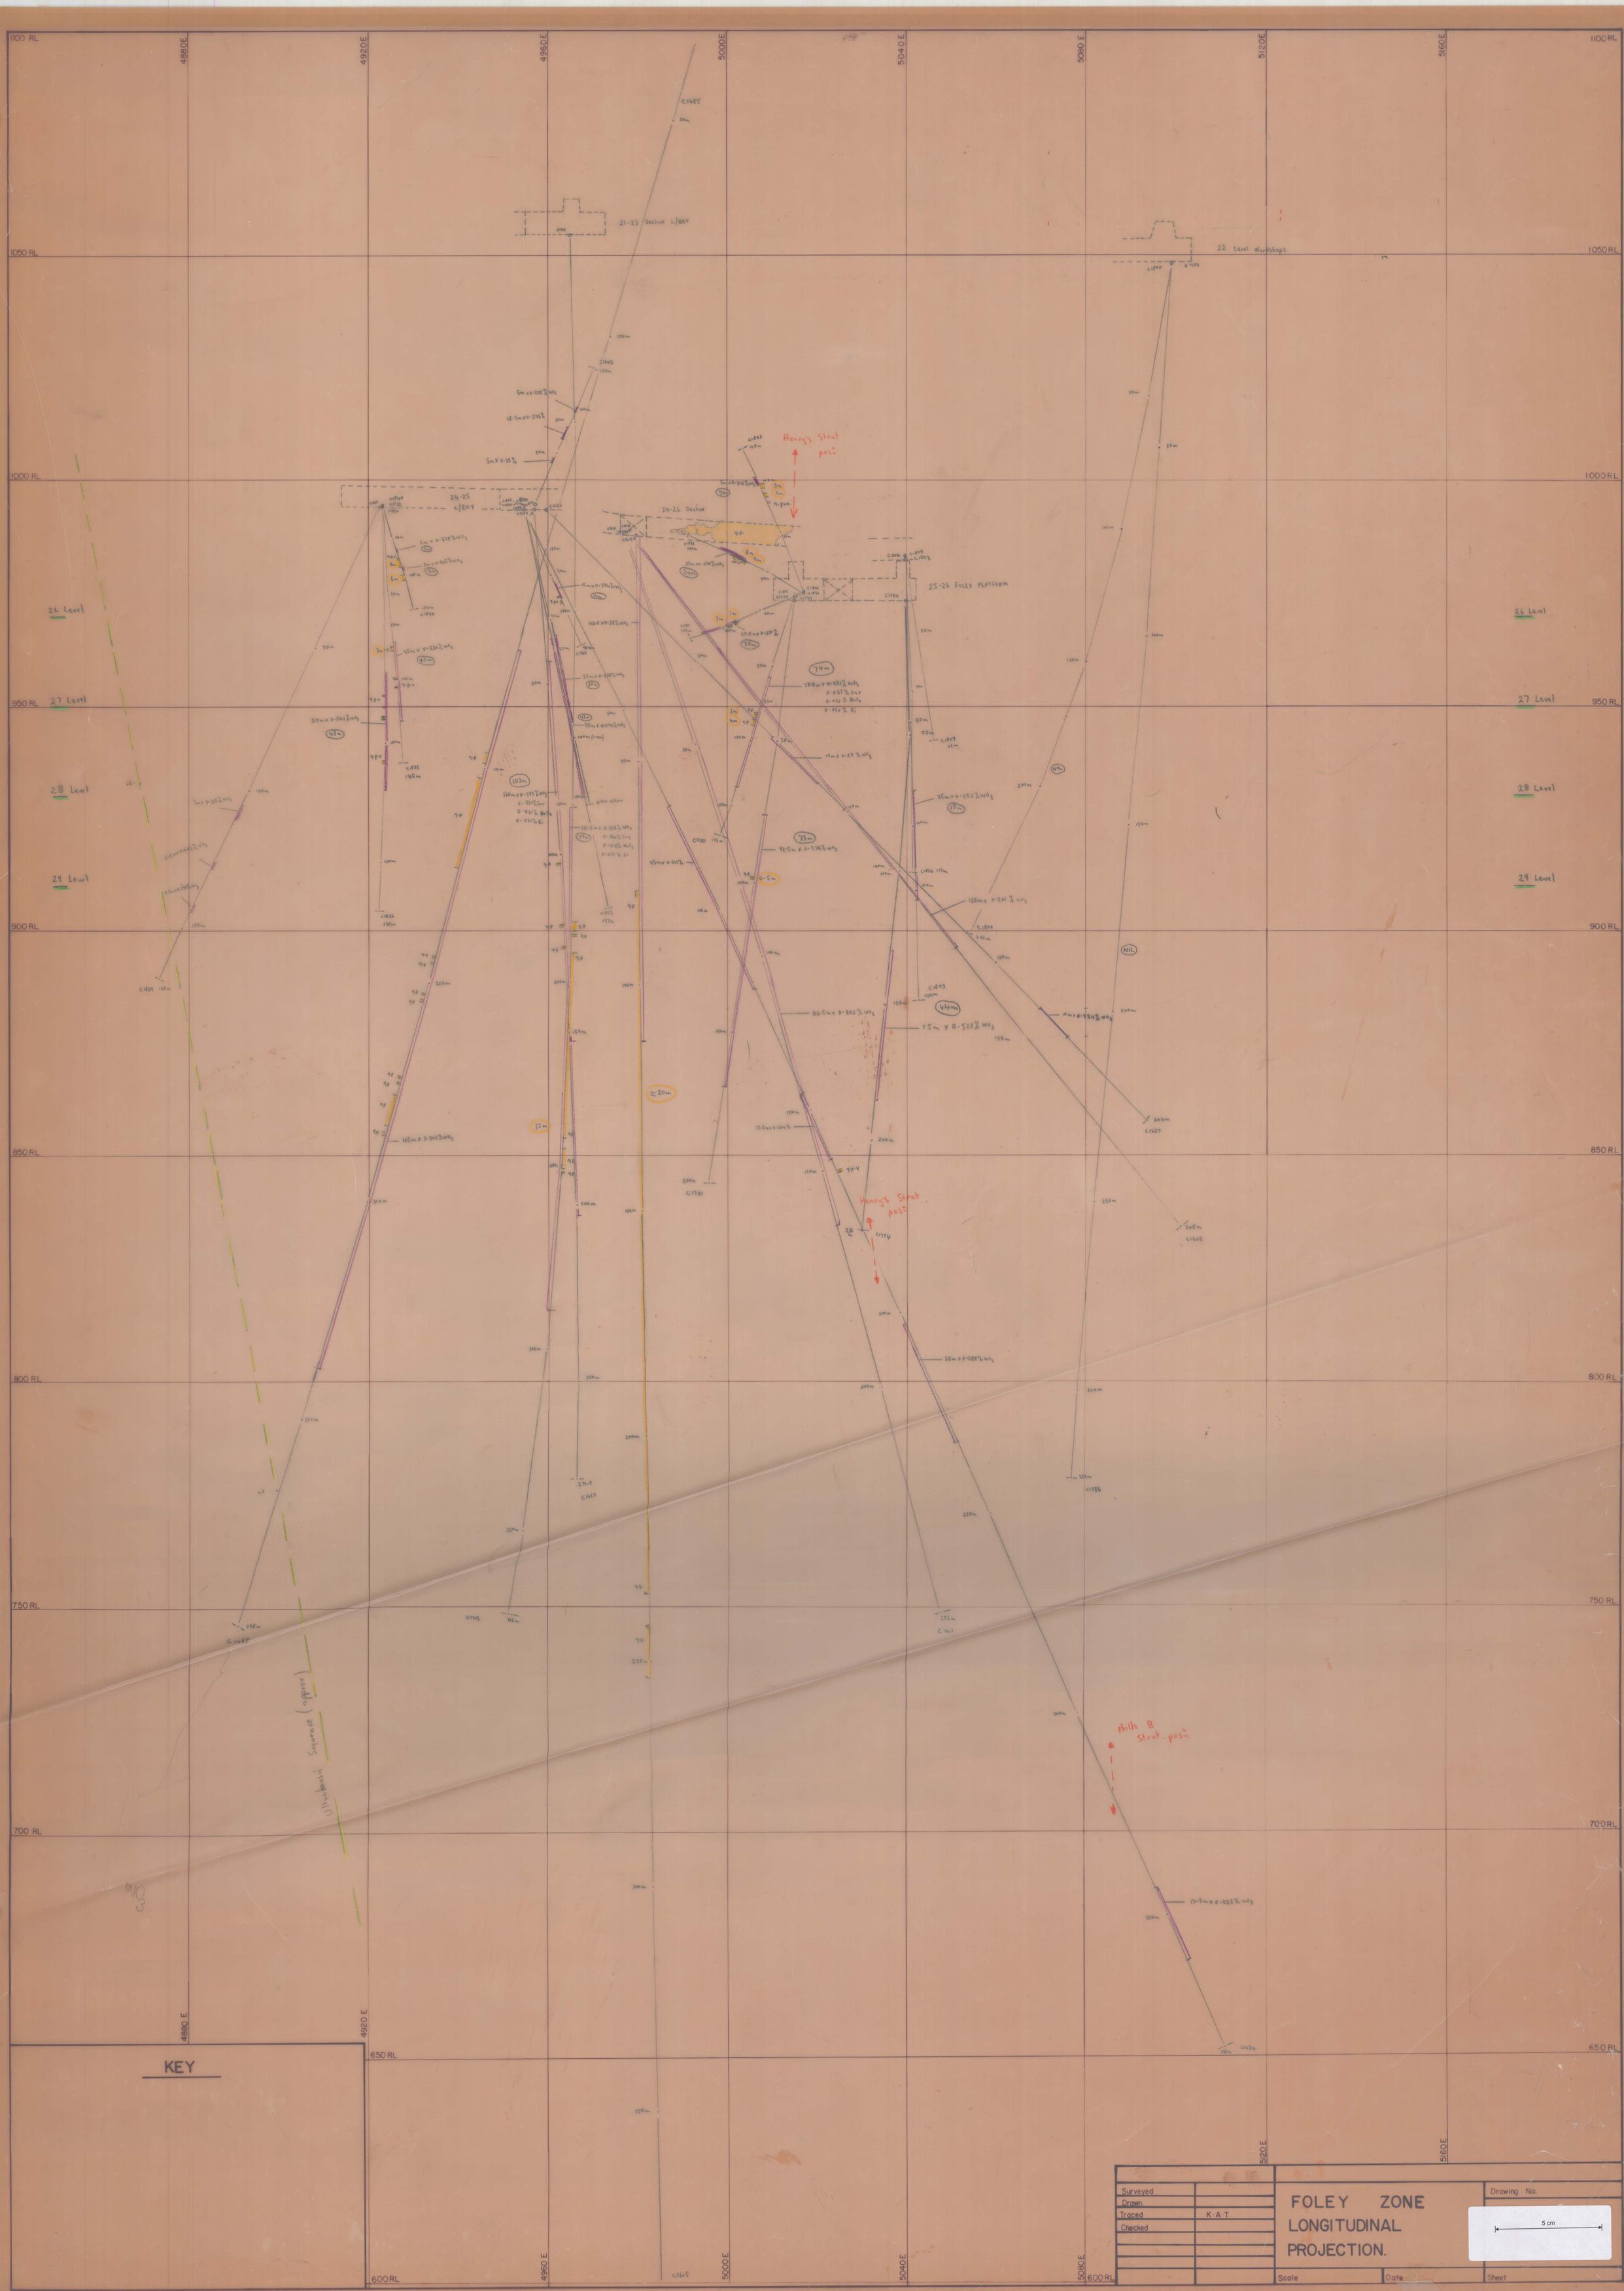
1100 RL
1050 RL
1000 RL
950 RL
900 RL
850 RL
800 RL
750 RL
700 RL
650 RL
600 RL
4880E
4920E
4960E
5000E
5040E
5080E
5120E
5160E
21-22 Decline L/BAY
22 Level Workshops
24-25 L/BAY
24-26 Decline
25-26 FOLEY PLATFORM
26 Level
27 Level
28 Level
29 Level
Henry's Strat pos.
Hills 8 Strat. pos.
KEY
FOLEY ZONE
LONGITUDINAL
PROJECTION.
Surveyed
Drawn
Traced
Checked
K·A·T
Drawing No.
Scale
Date
Sheet
5 cm