


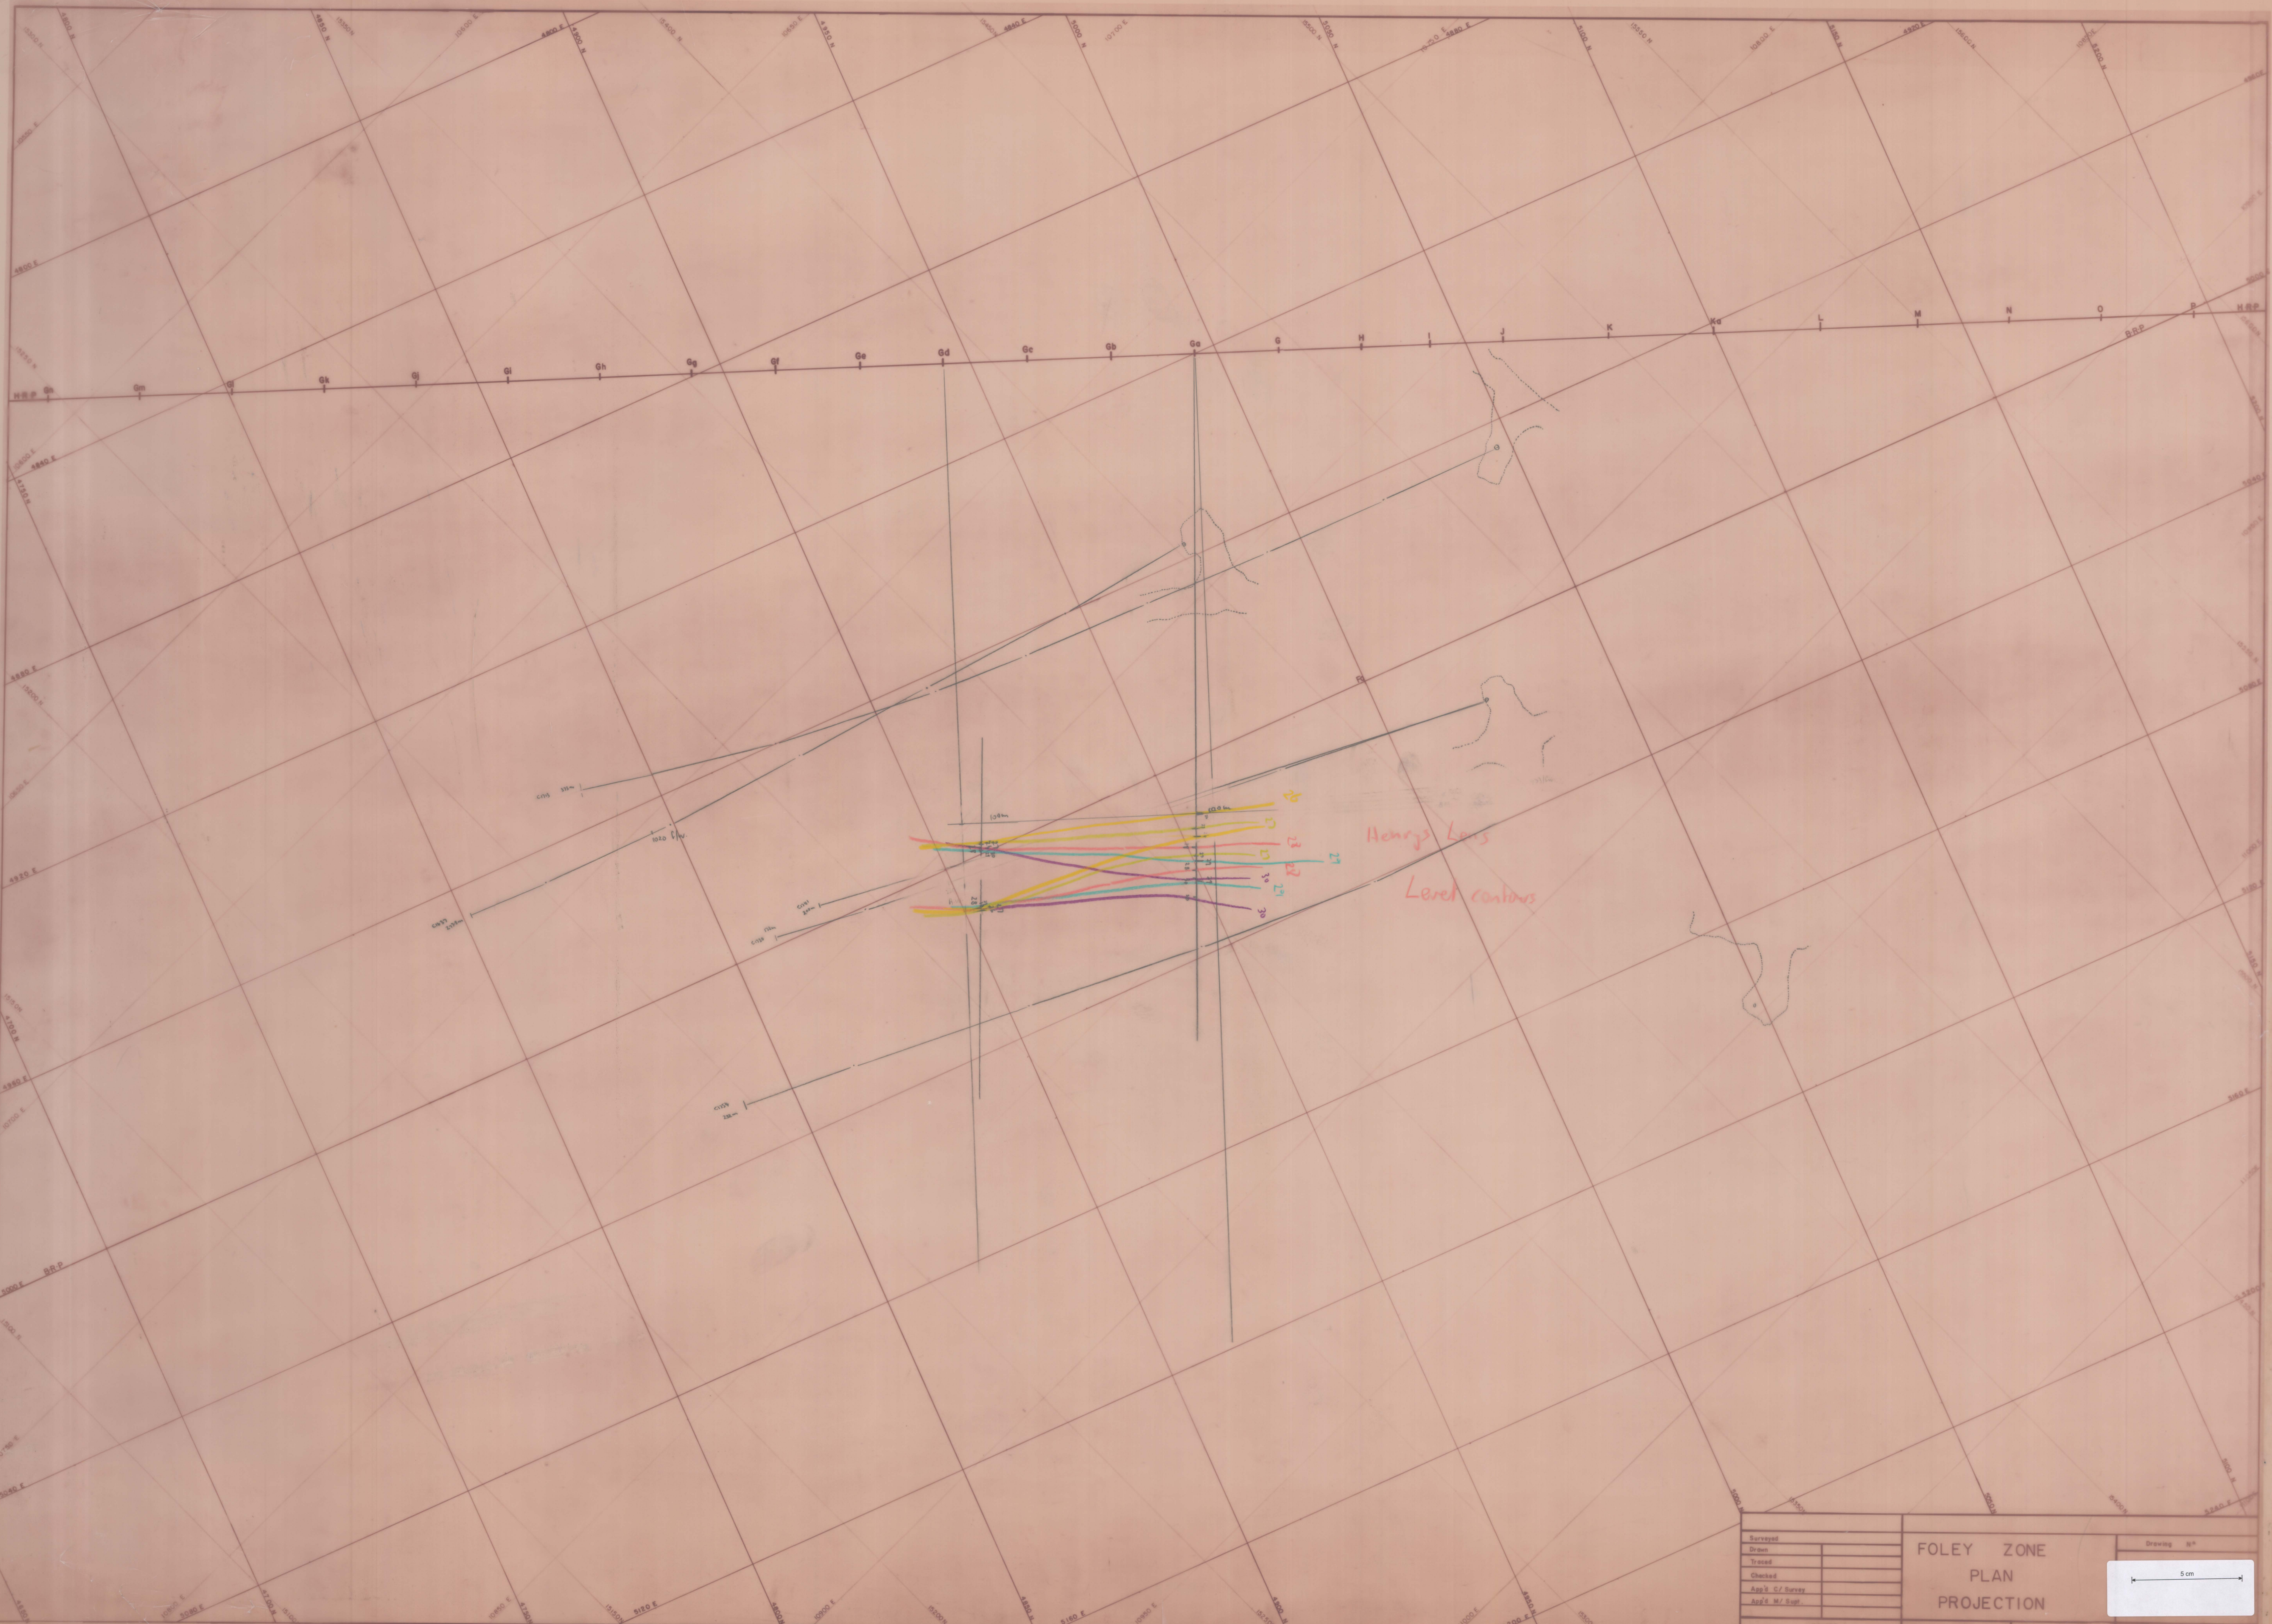

Surveyed		FOLEY ZONE PLAN PROJECTION	Drawing No.
Drawn			
Traced			
Checked			
App'd. C. J. Survey			
App'd. M. J. Sup.		Scale 1" = 100'	
7/1/80		Date	