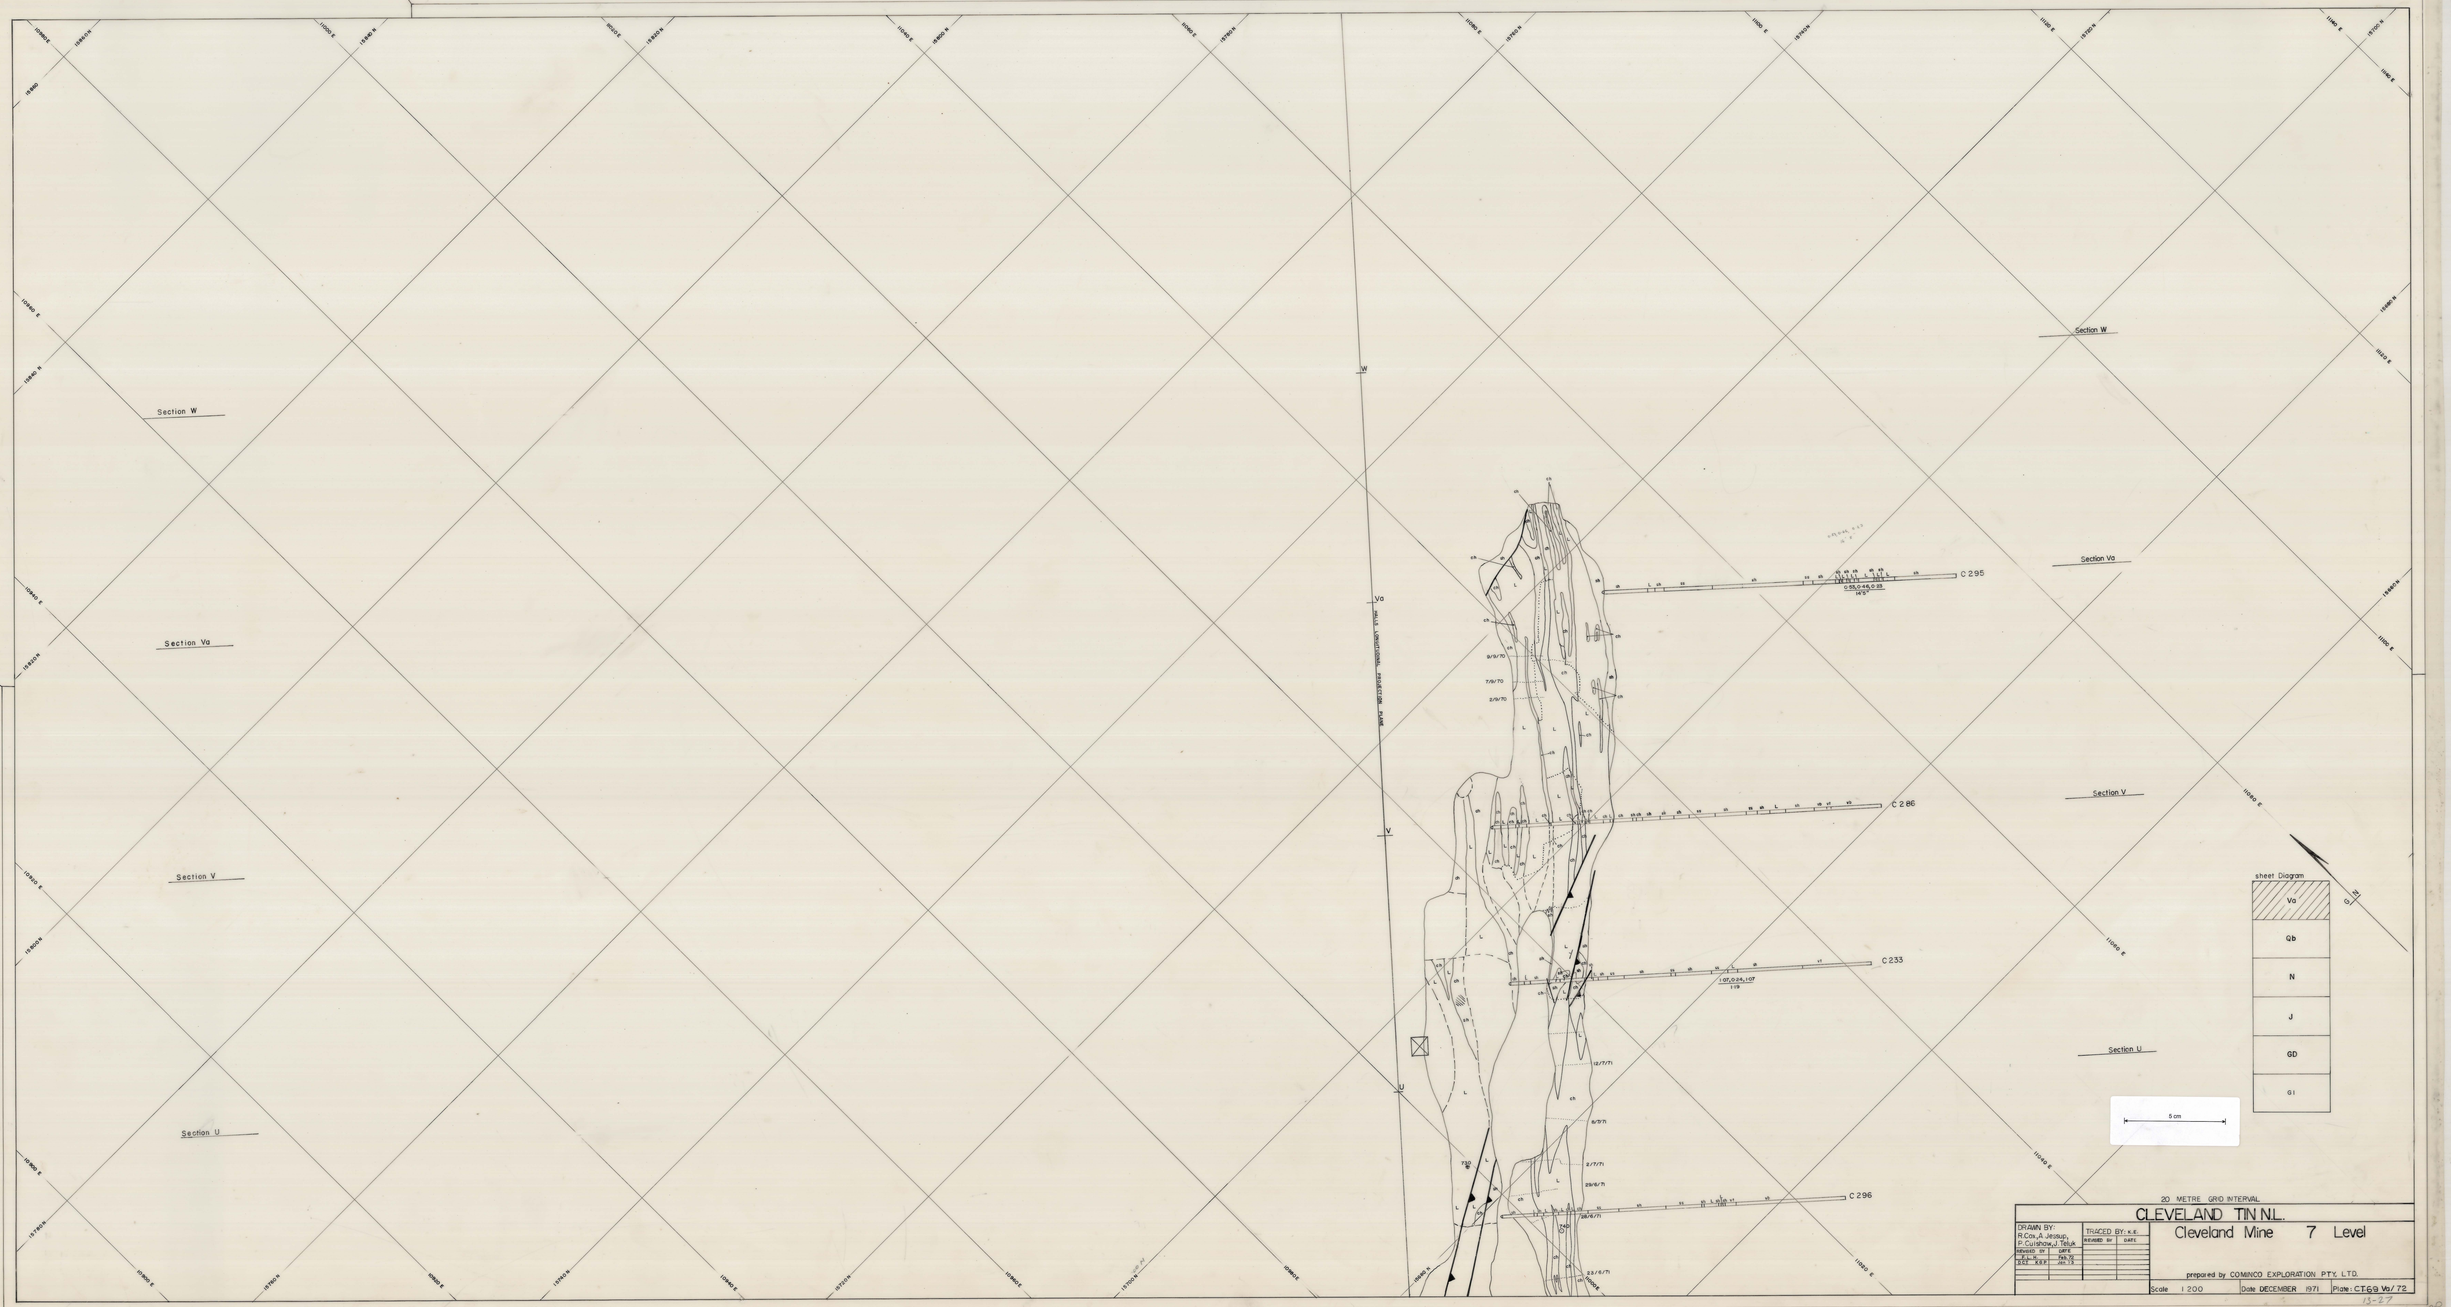

CT69 VA-72
0216_777