Section S

Section R

Section Qb

Section Qa

Section Q

Section P

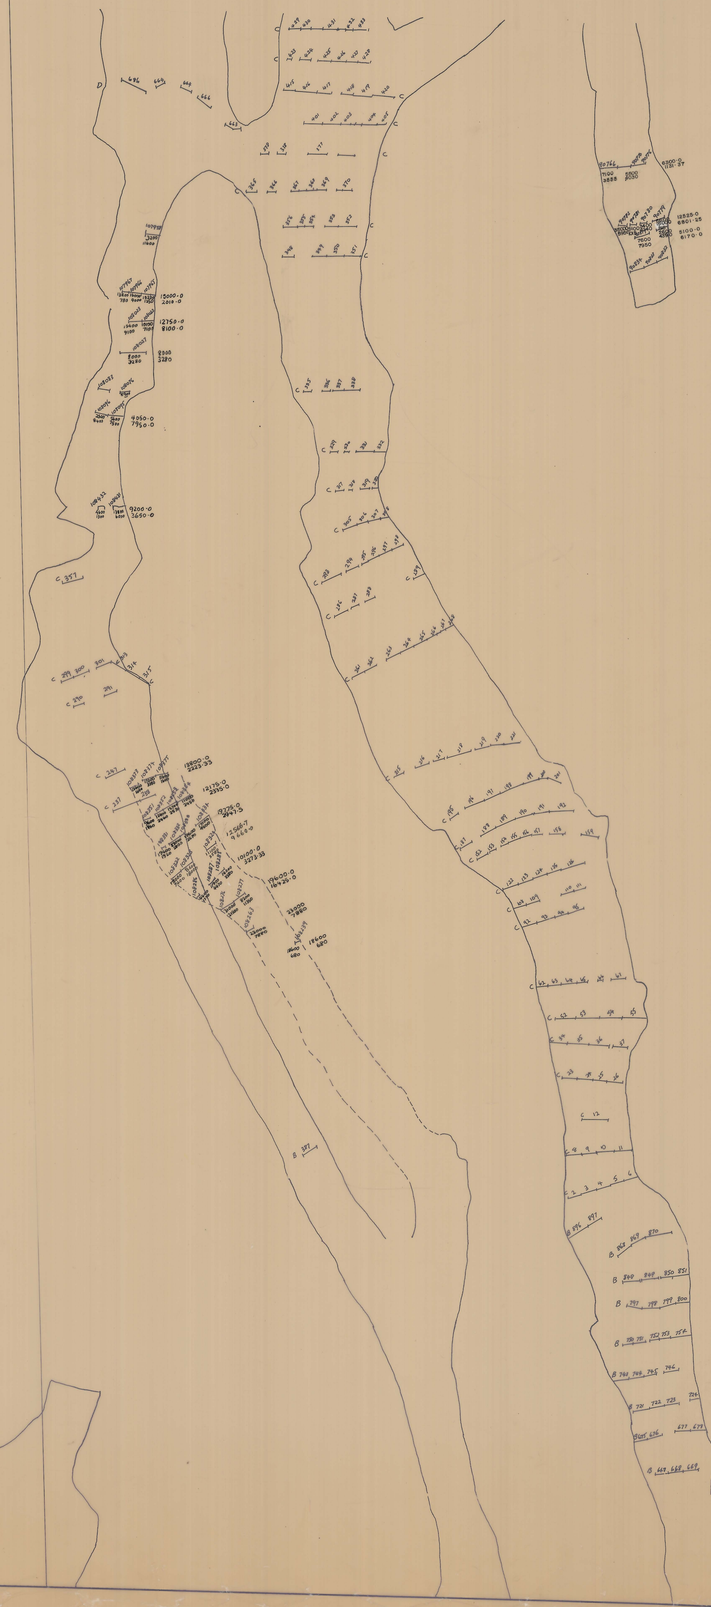

Section S

Section R

Section Qb

Section Qa

Section Q

Section P

5 cm

| Abminco Exploration | | |
|---|---|---|
| Geology: | Cleveland Mine 10 Level | Location code: |
| Drawn: | | Date: |
| Traced: | | Scale: |
| Checked: | Sheet Qa Samples Sent Out | Plate № |
| Revised by: Date: | | |

0216_793