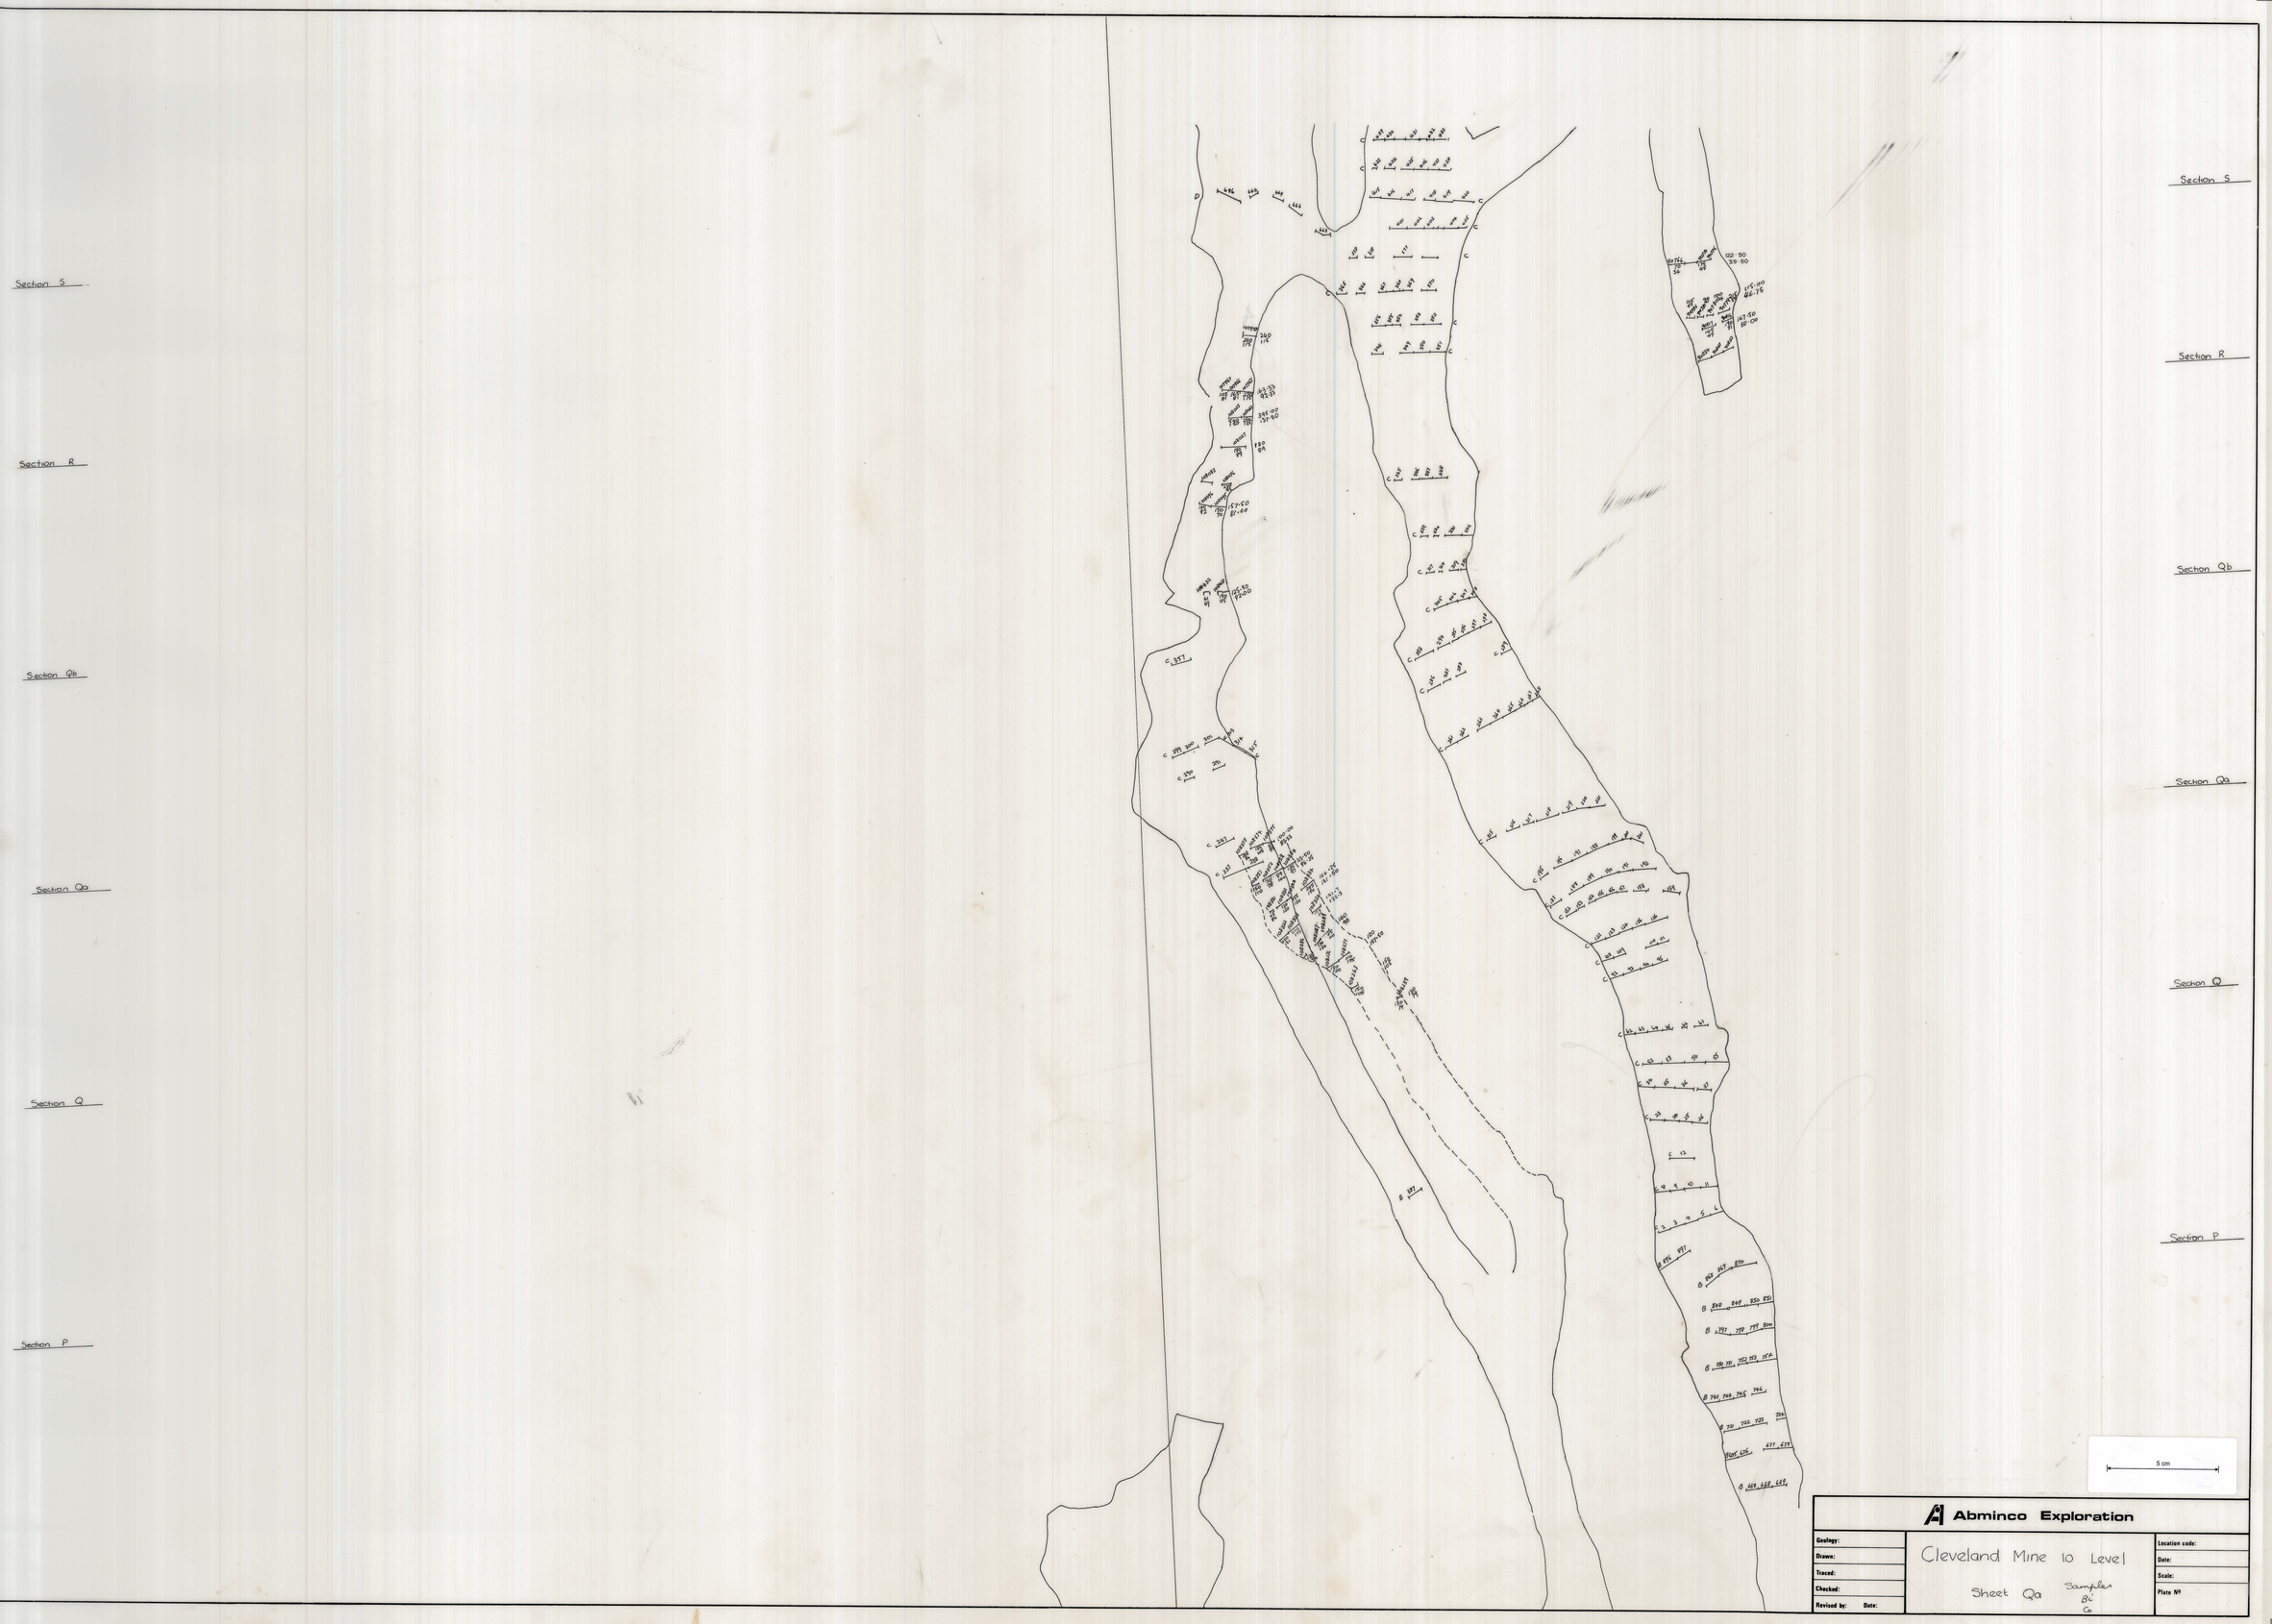
Section S
Section R
Section Qb
Section Qa
Section Q
Section P
5 cm
Abminco Exploration
Geology:
Drawn:
Traced:
Checked:
Revised by:
Date:
Cleveland Mine 10 Level
Sheet Qa
Samples
Bi
Co
Location code:
Date:
Scale:
Plate Nº

0216_795