

Section O

Section N

Section M

Section L

Section Ka

Section K

Section Q


Section H

Section M

Section L

Section Ka

Section K

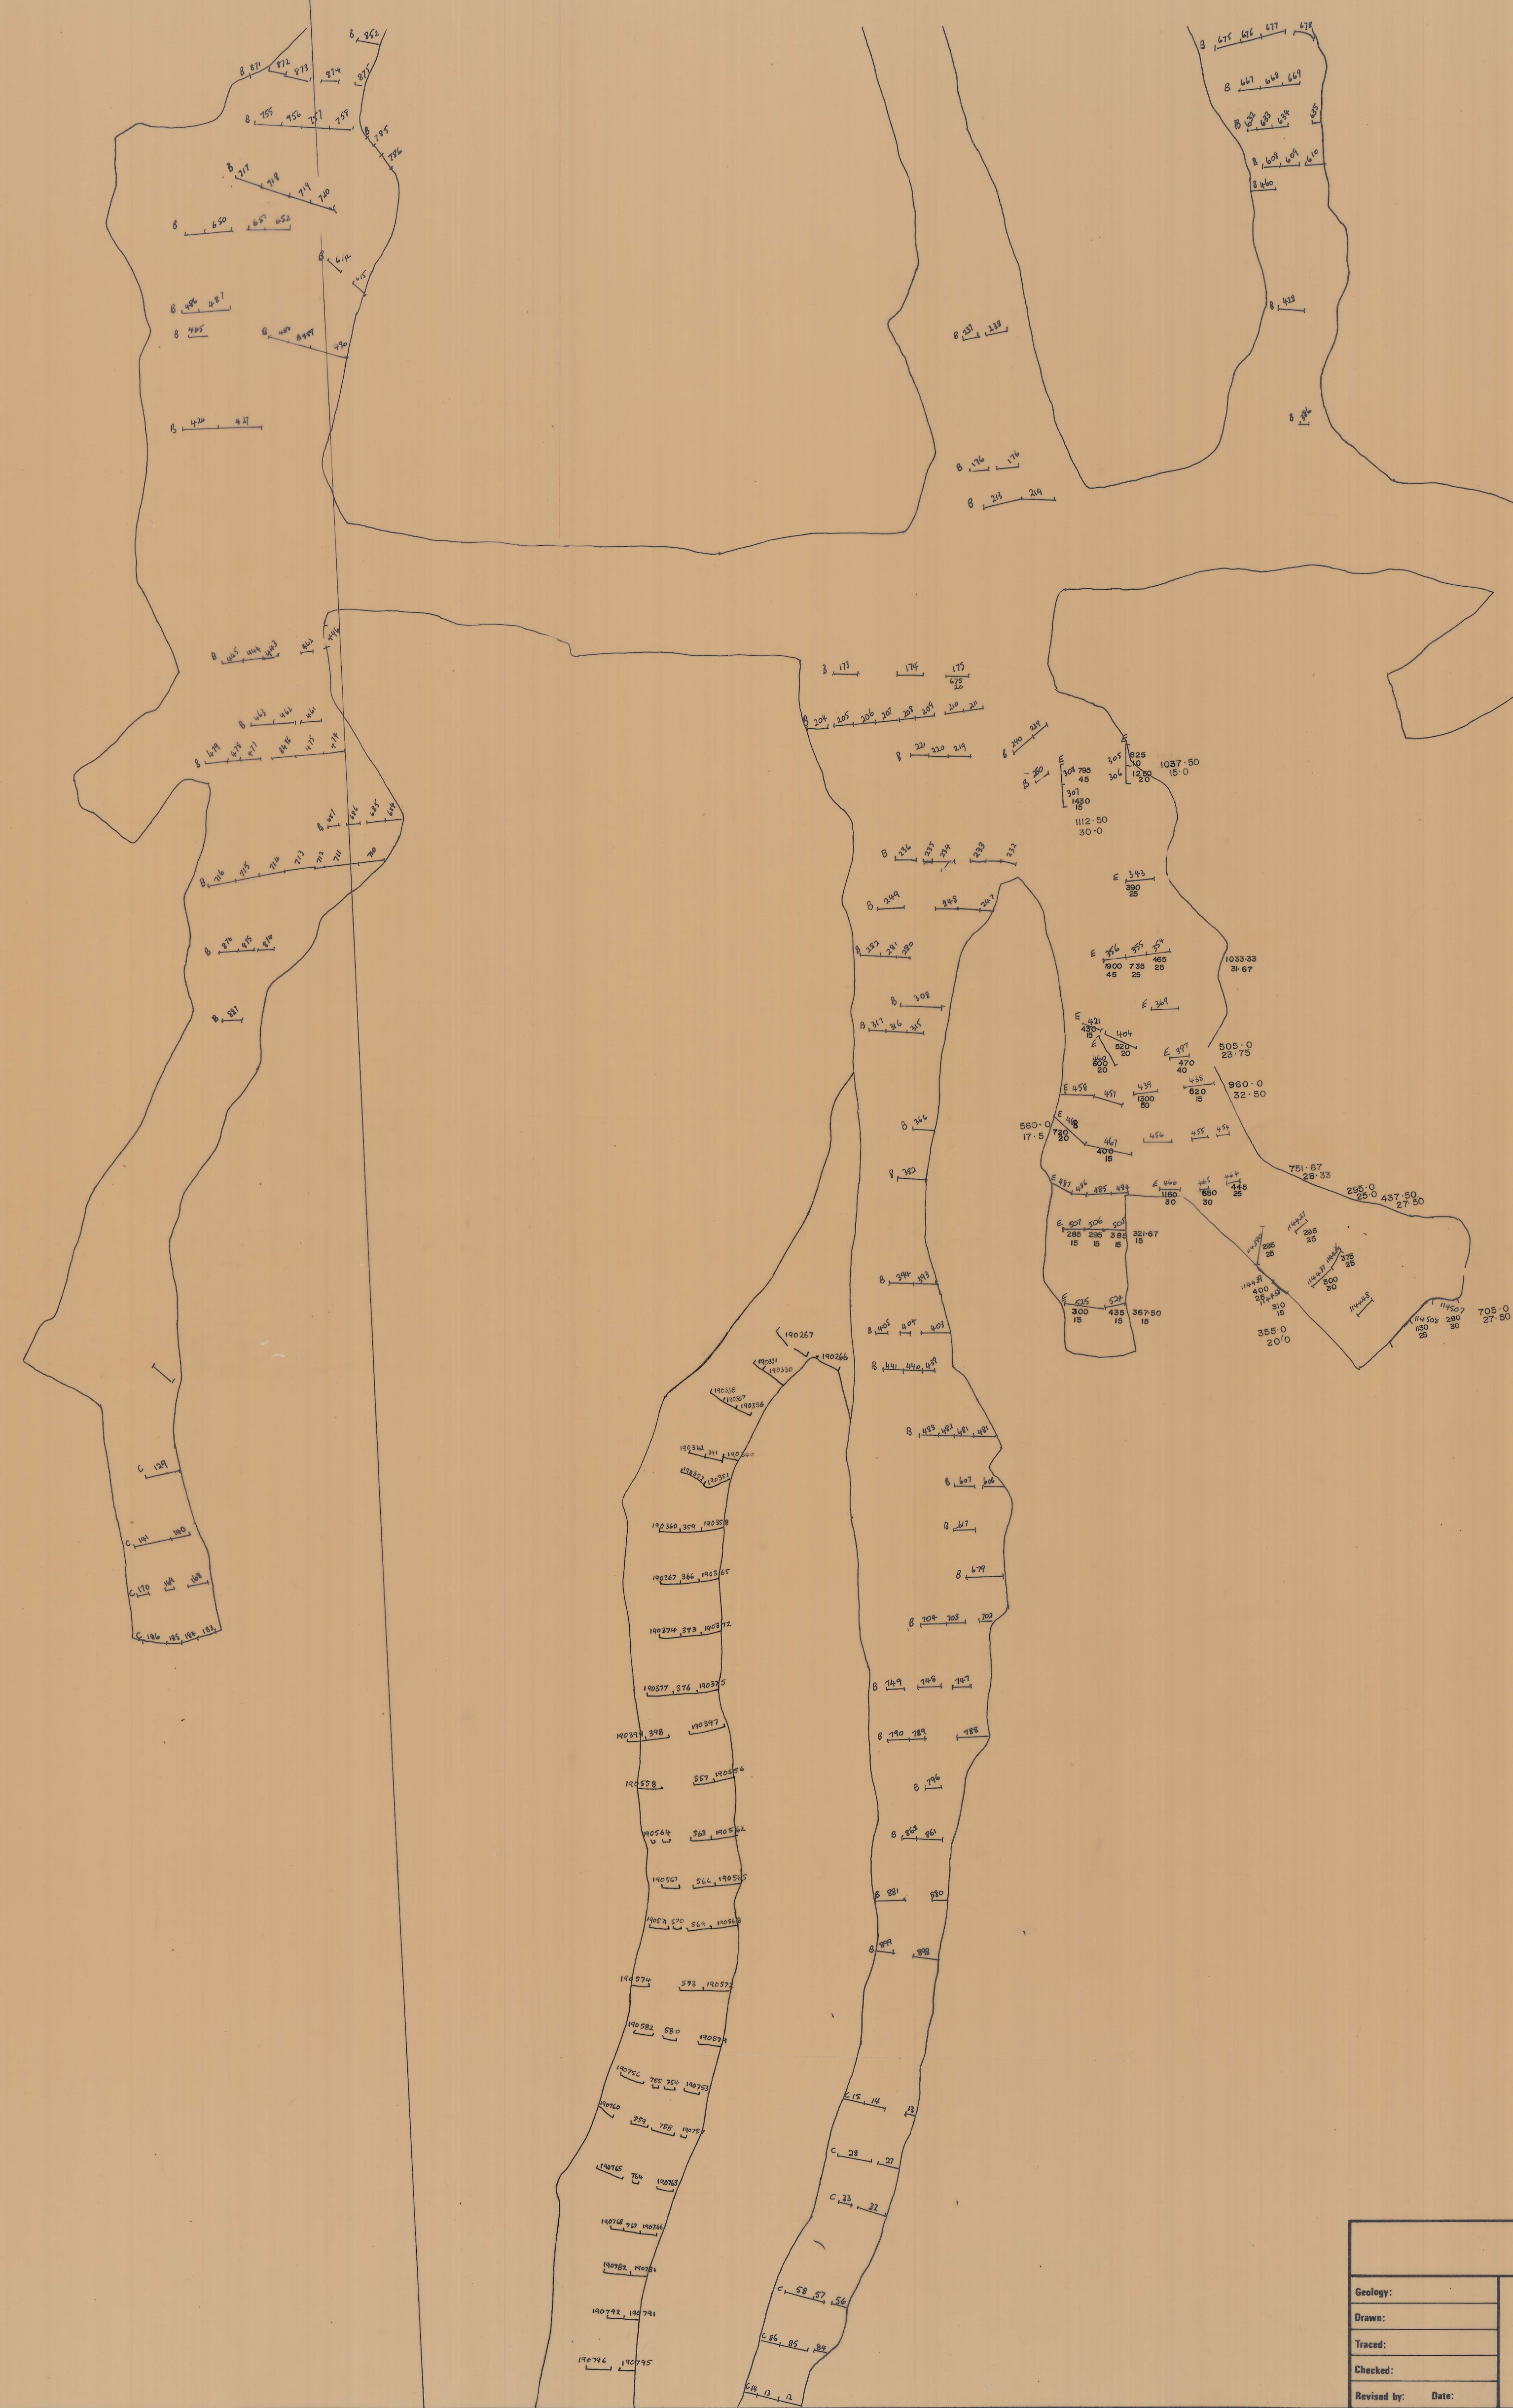

Abminco Exploration	
Geology:	CLEVELAND MINE 10 LEVEL
Drawn:	Sheet M
Traced:	
Checked:	
Revised by:	Date:
Location code:	
Date:	
Scale:	
Plot No:	

0216/797