


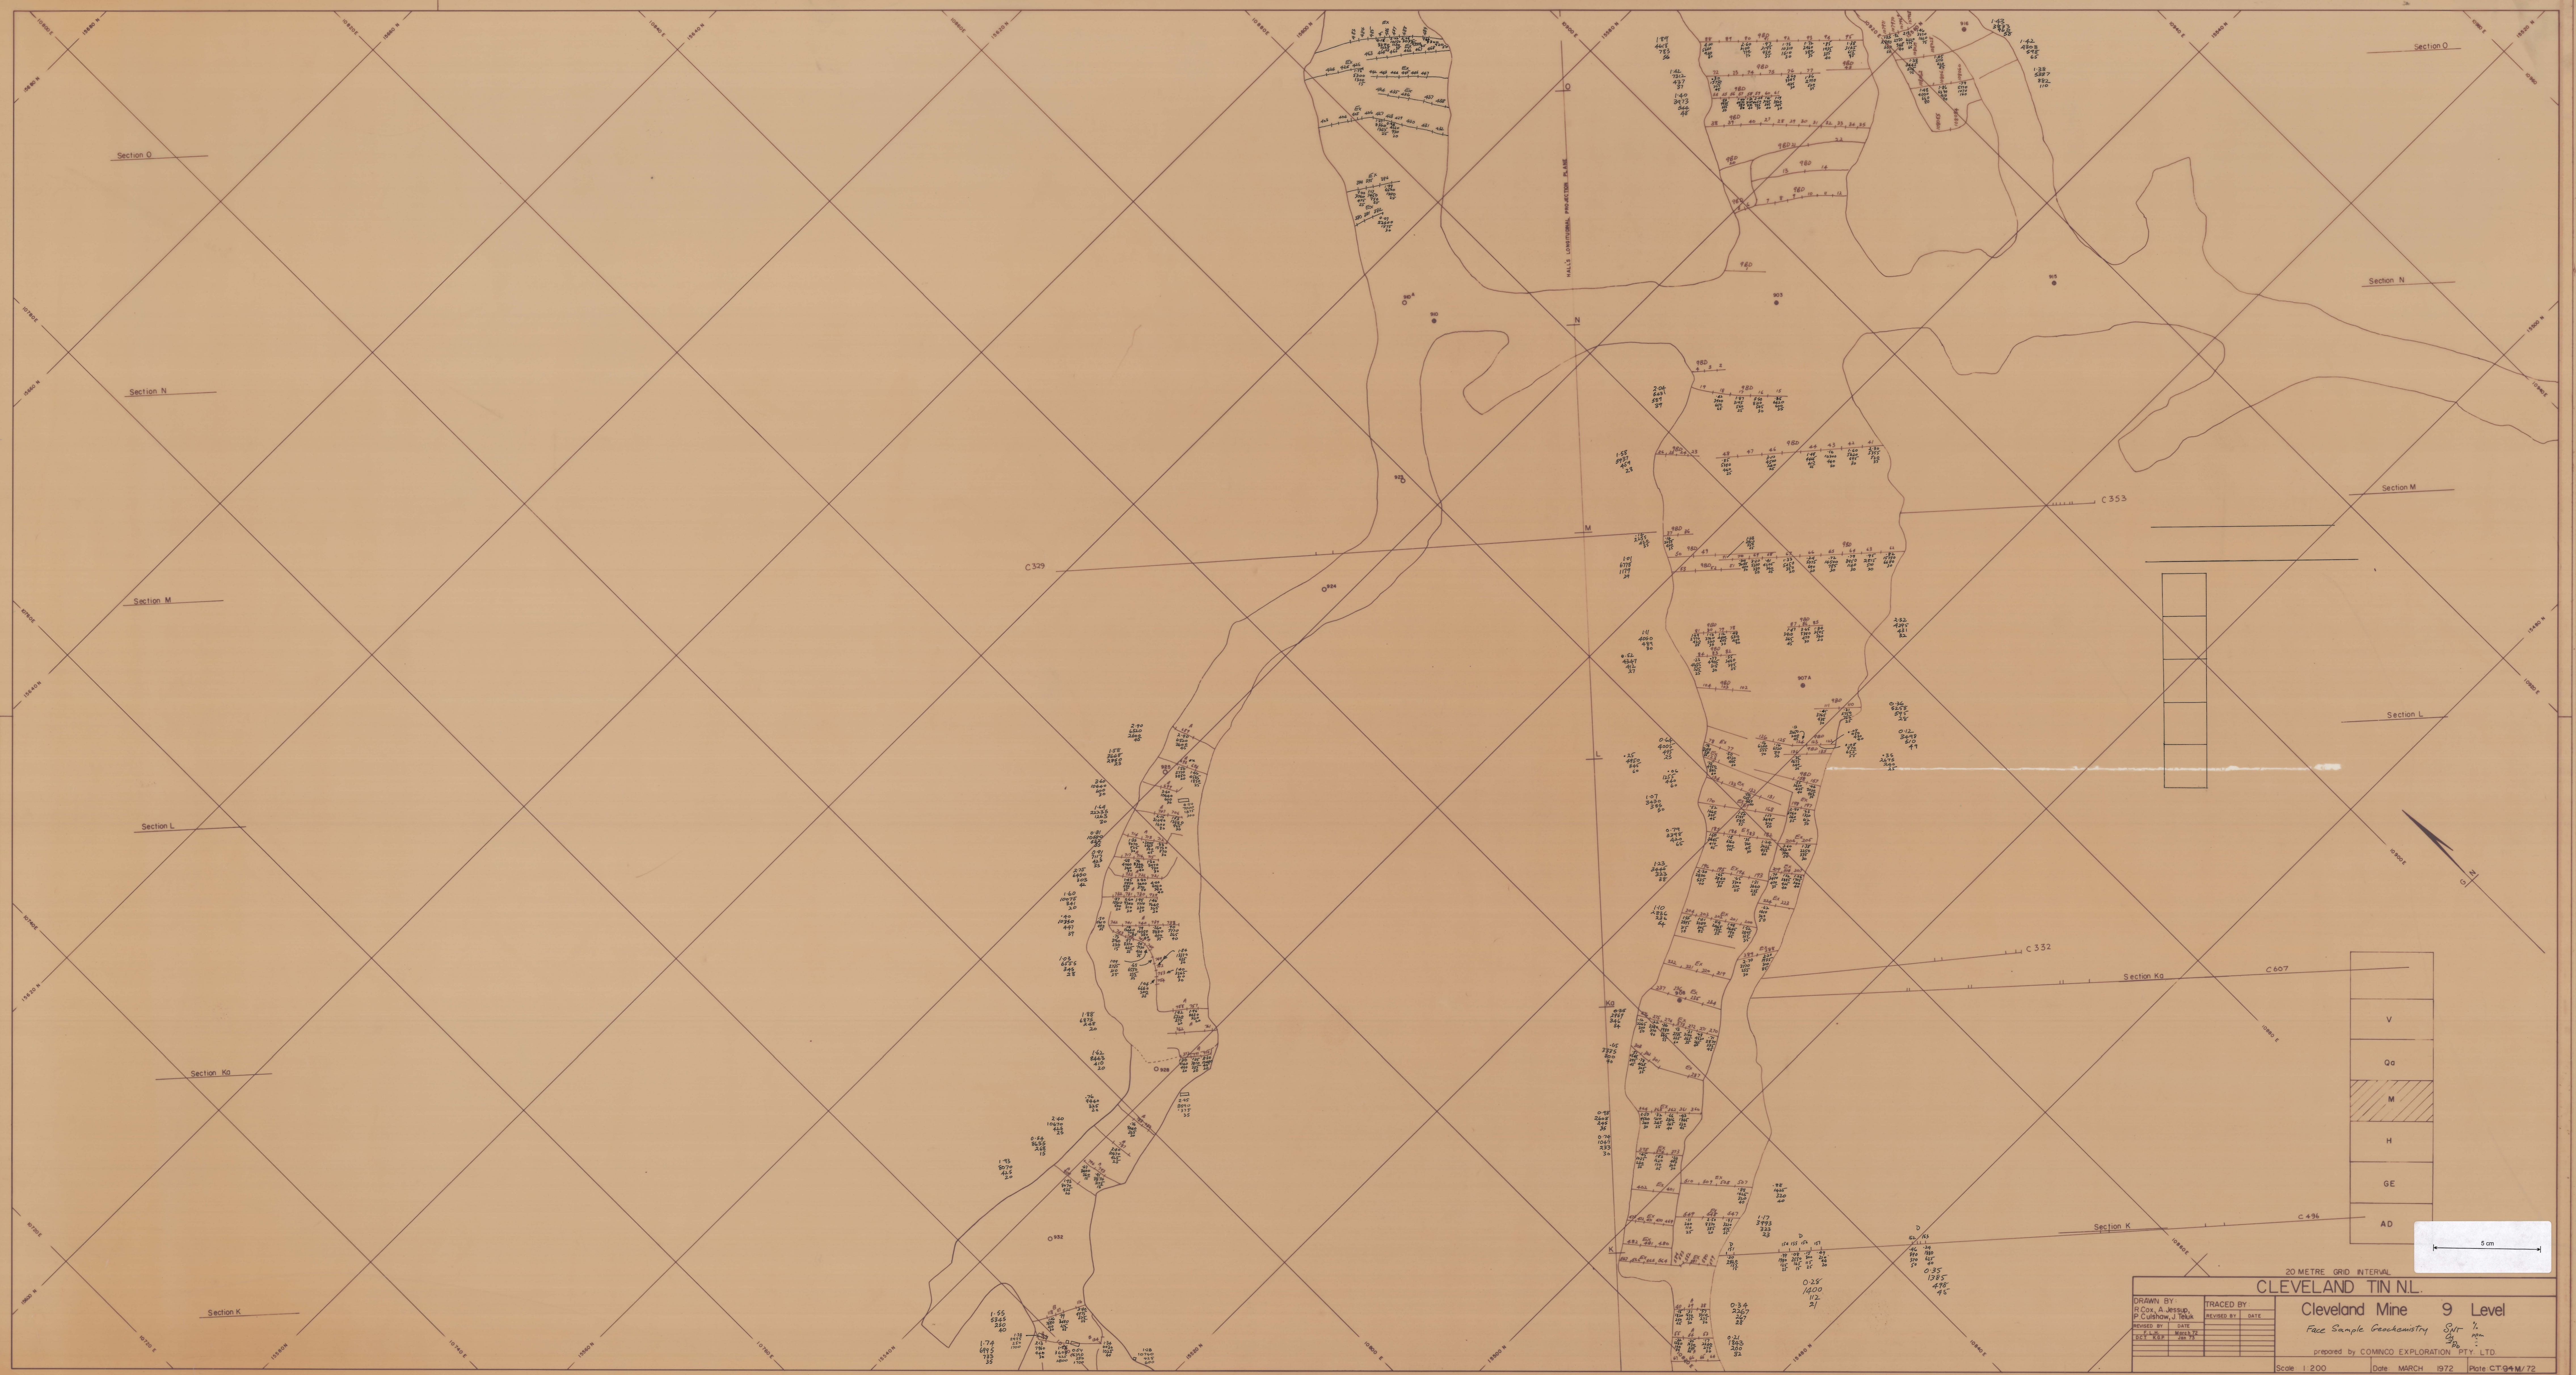

20 METRE GRID INTERVAL
CLEVELAND TIN NL.
Cleveland Mine 9 Level
Face Sample Geochemistry
prepared by COMINCO EXPLORATION PTY. LTD.
Scale 1:200 Date MARCH 1972 Plate CT 94M/72

DRAWN BY		TRACED BY	
R. COX, A. WESLO, P. CUSHAW, J. TOLA			
REVISION BY	DATE	REVISION BY	DATE
1001	10/1/72		
1002	10/1/72		
V
Qa
M
H
GE
AD