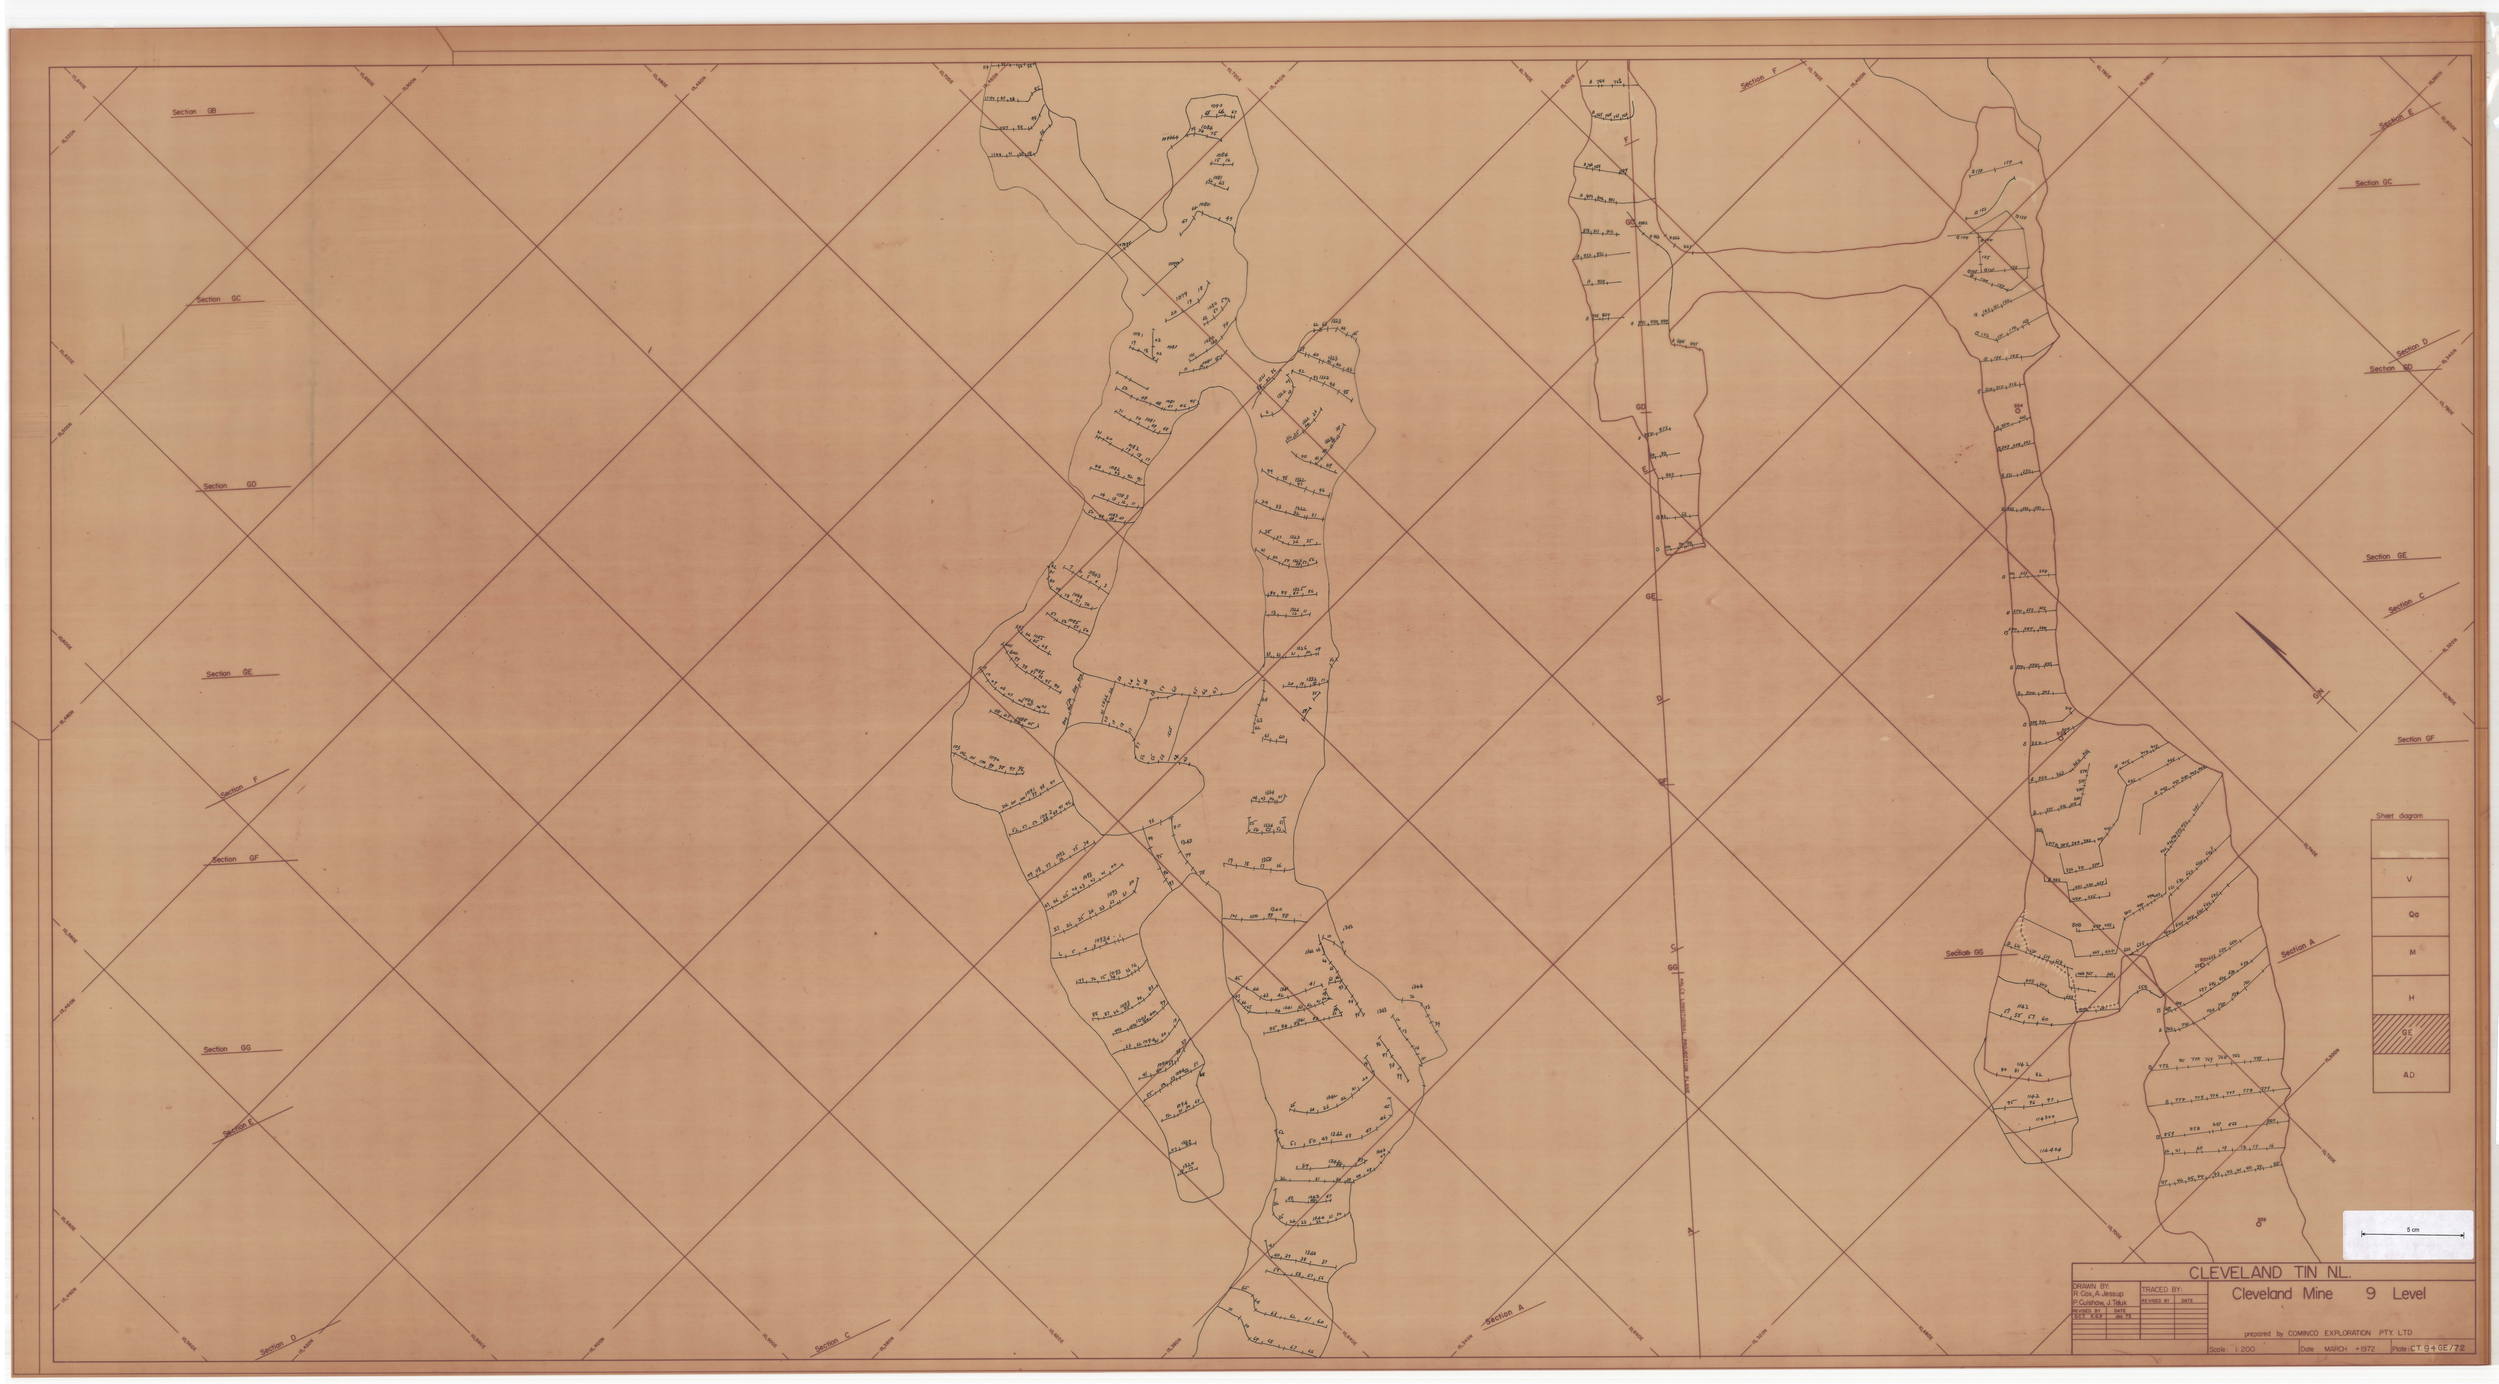
Section GB
Section GC
Section GD
Section GE
Section F
Section GF
Section GG
Section B
Section D
Section C
Section A
Section E
Section GC
Section D
Section GD
Section GE
Section C
Section GF
Section GG
Section A
Sheet diagram
V
Qa
M
H
GE
AD
5 cm
CLEVELAND TIN NL.
Cleveland Mine 9 Level
DRAWN BY
R. Cox, A. Jessup
P. Cutshow, J. Tilus
TRACED BY
REVISED BY
DATE
prepared by COMINCO EXPLORATION PTY. LTD
Scale: 1:200
Date MARCH 1972
Plate: CT 9 + GE / 72

0216_828