


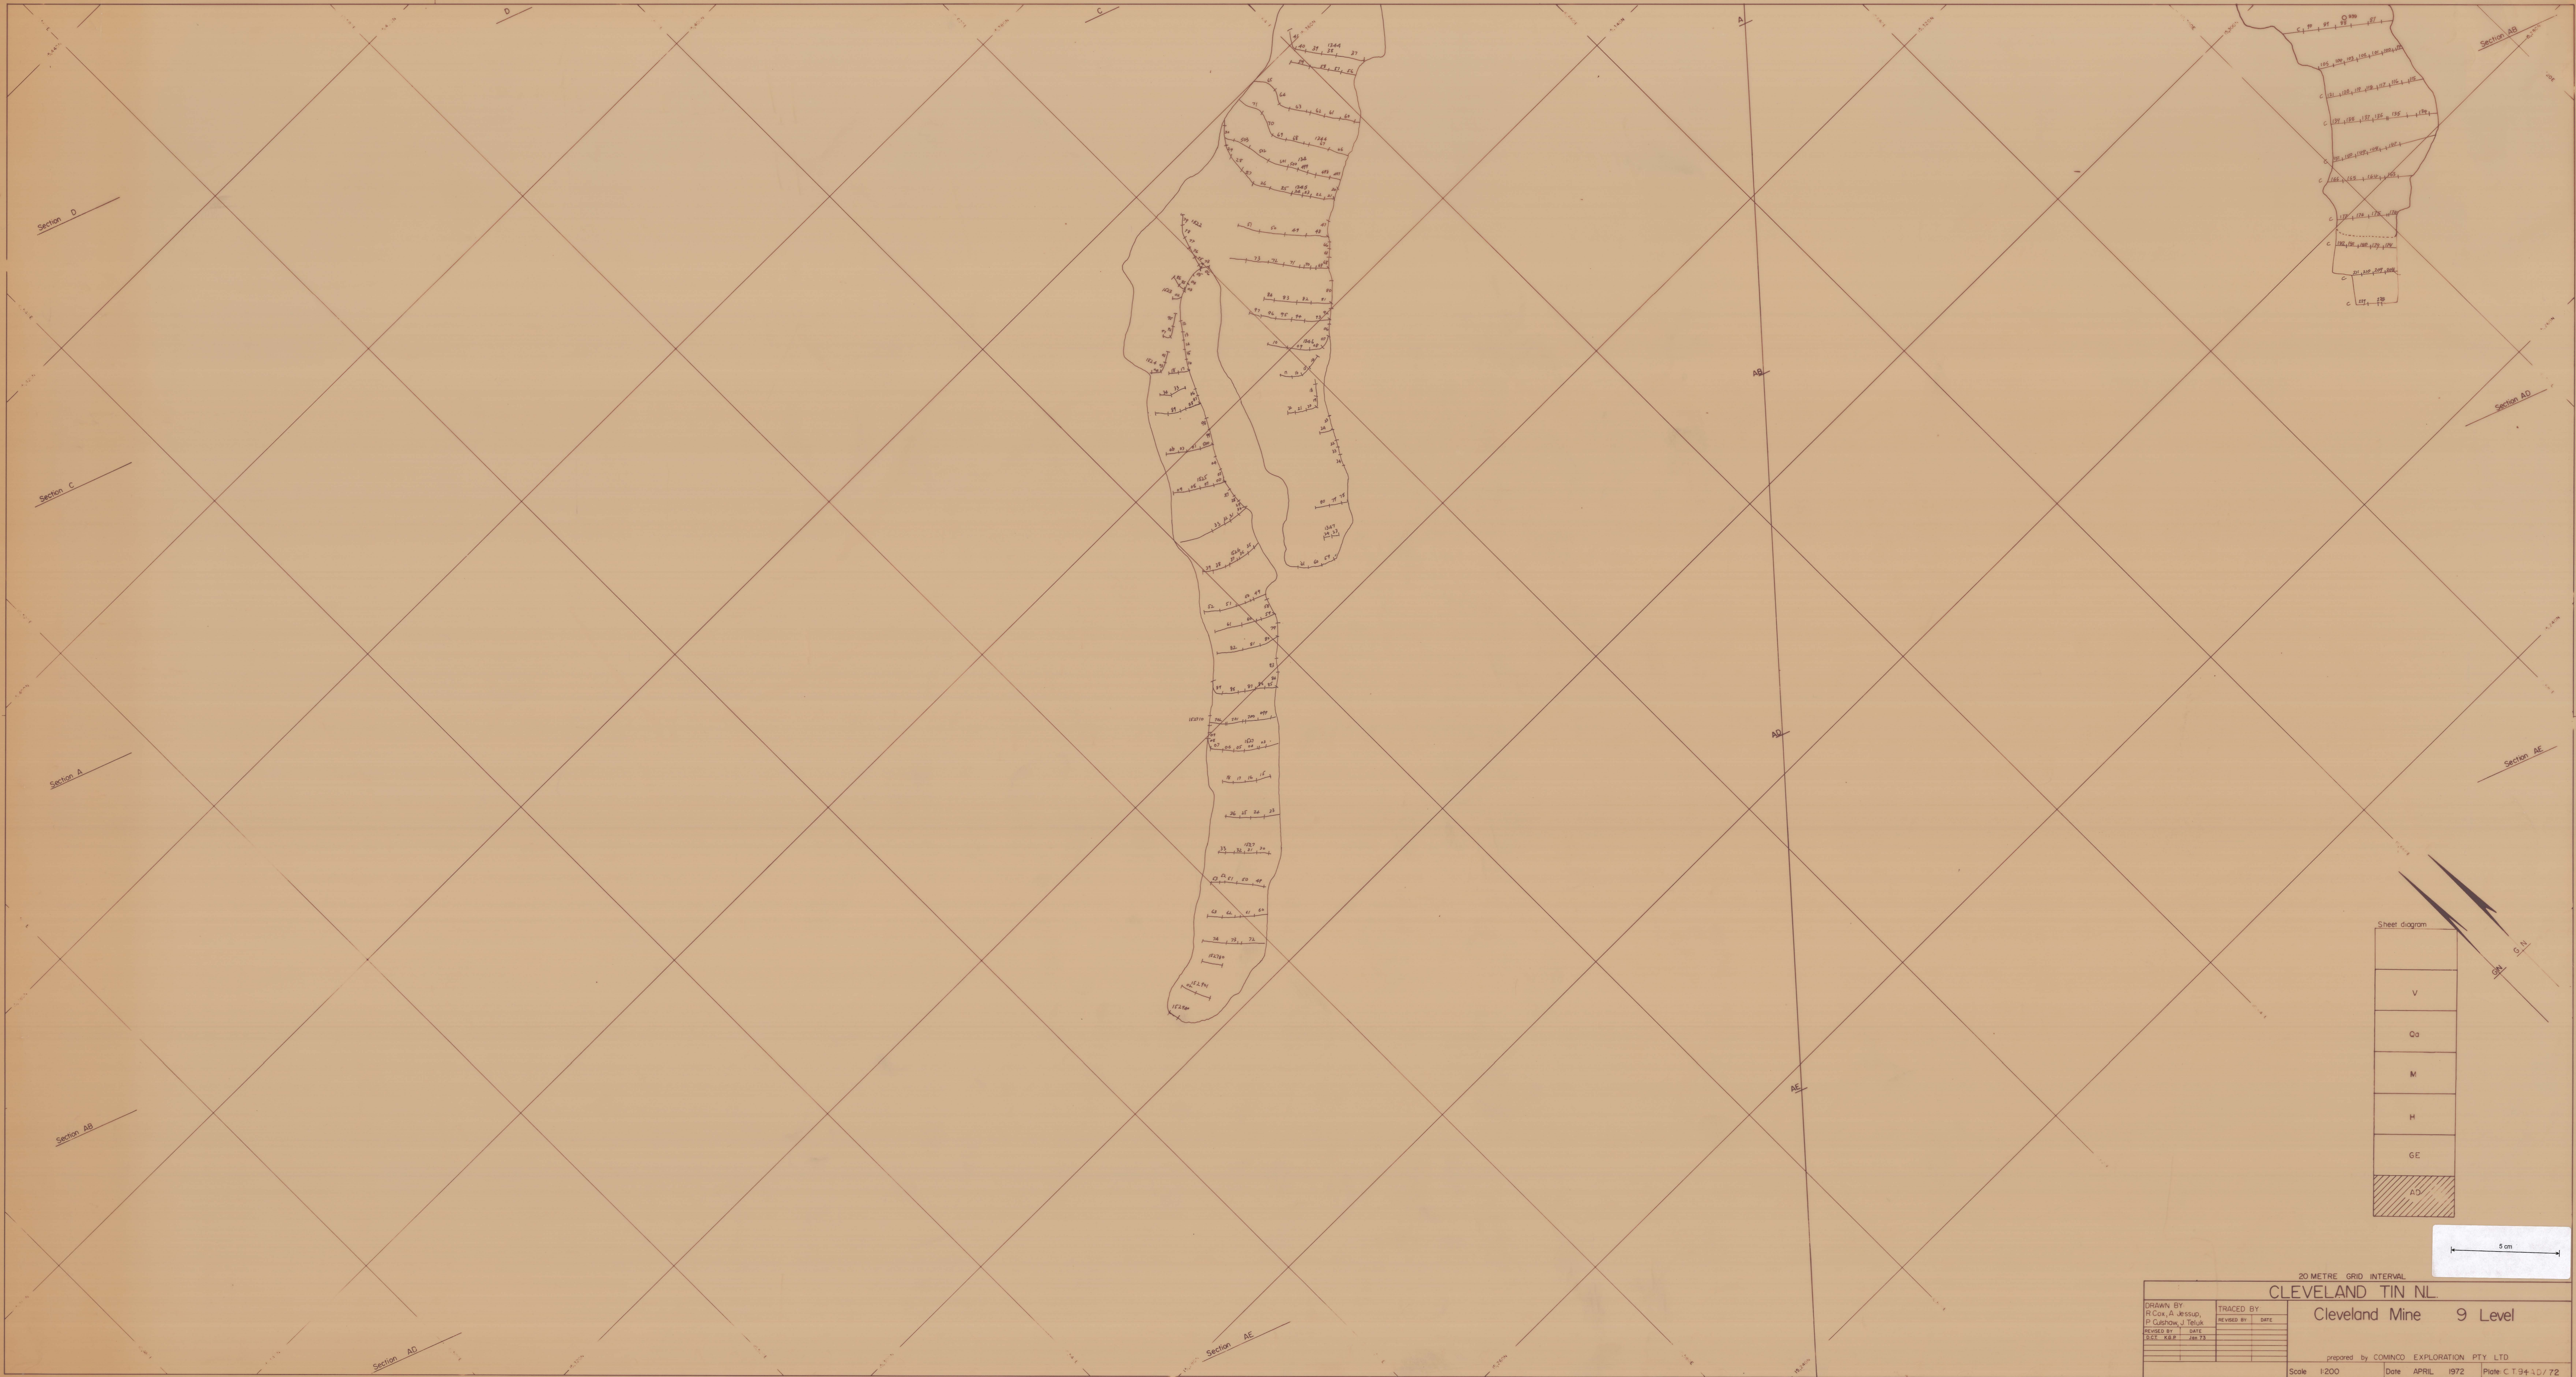

Sheet diagram

V
Q3
M
H
GE
AD

20 METRE GRID INTERVAL

CLEVELAND TIN NL

Cleveland Mine 9 Level

prepared by COMINCO EXPLORATION PTY LTD

Scale 1:200 Date APRIL 1972 Plate C.T.34-1D/72

DRAWN BY	TRACED BY
H. COX, A. JESSUP,	
P. CHISHOLM, J. TOLUH,	
REVISED BY	DATE
SCALE	DATE

0216_829