


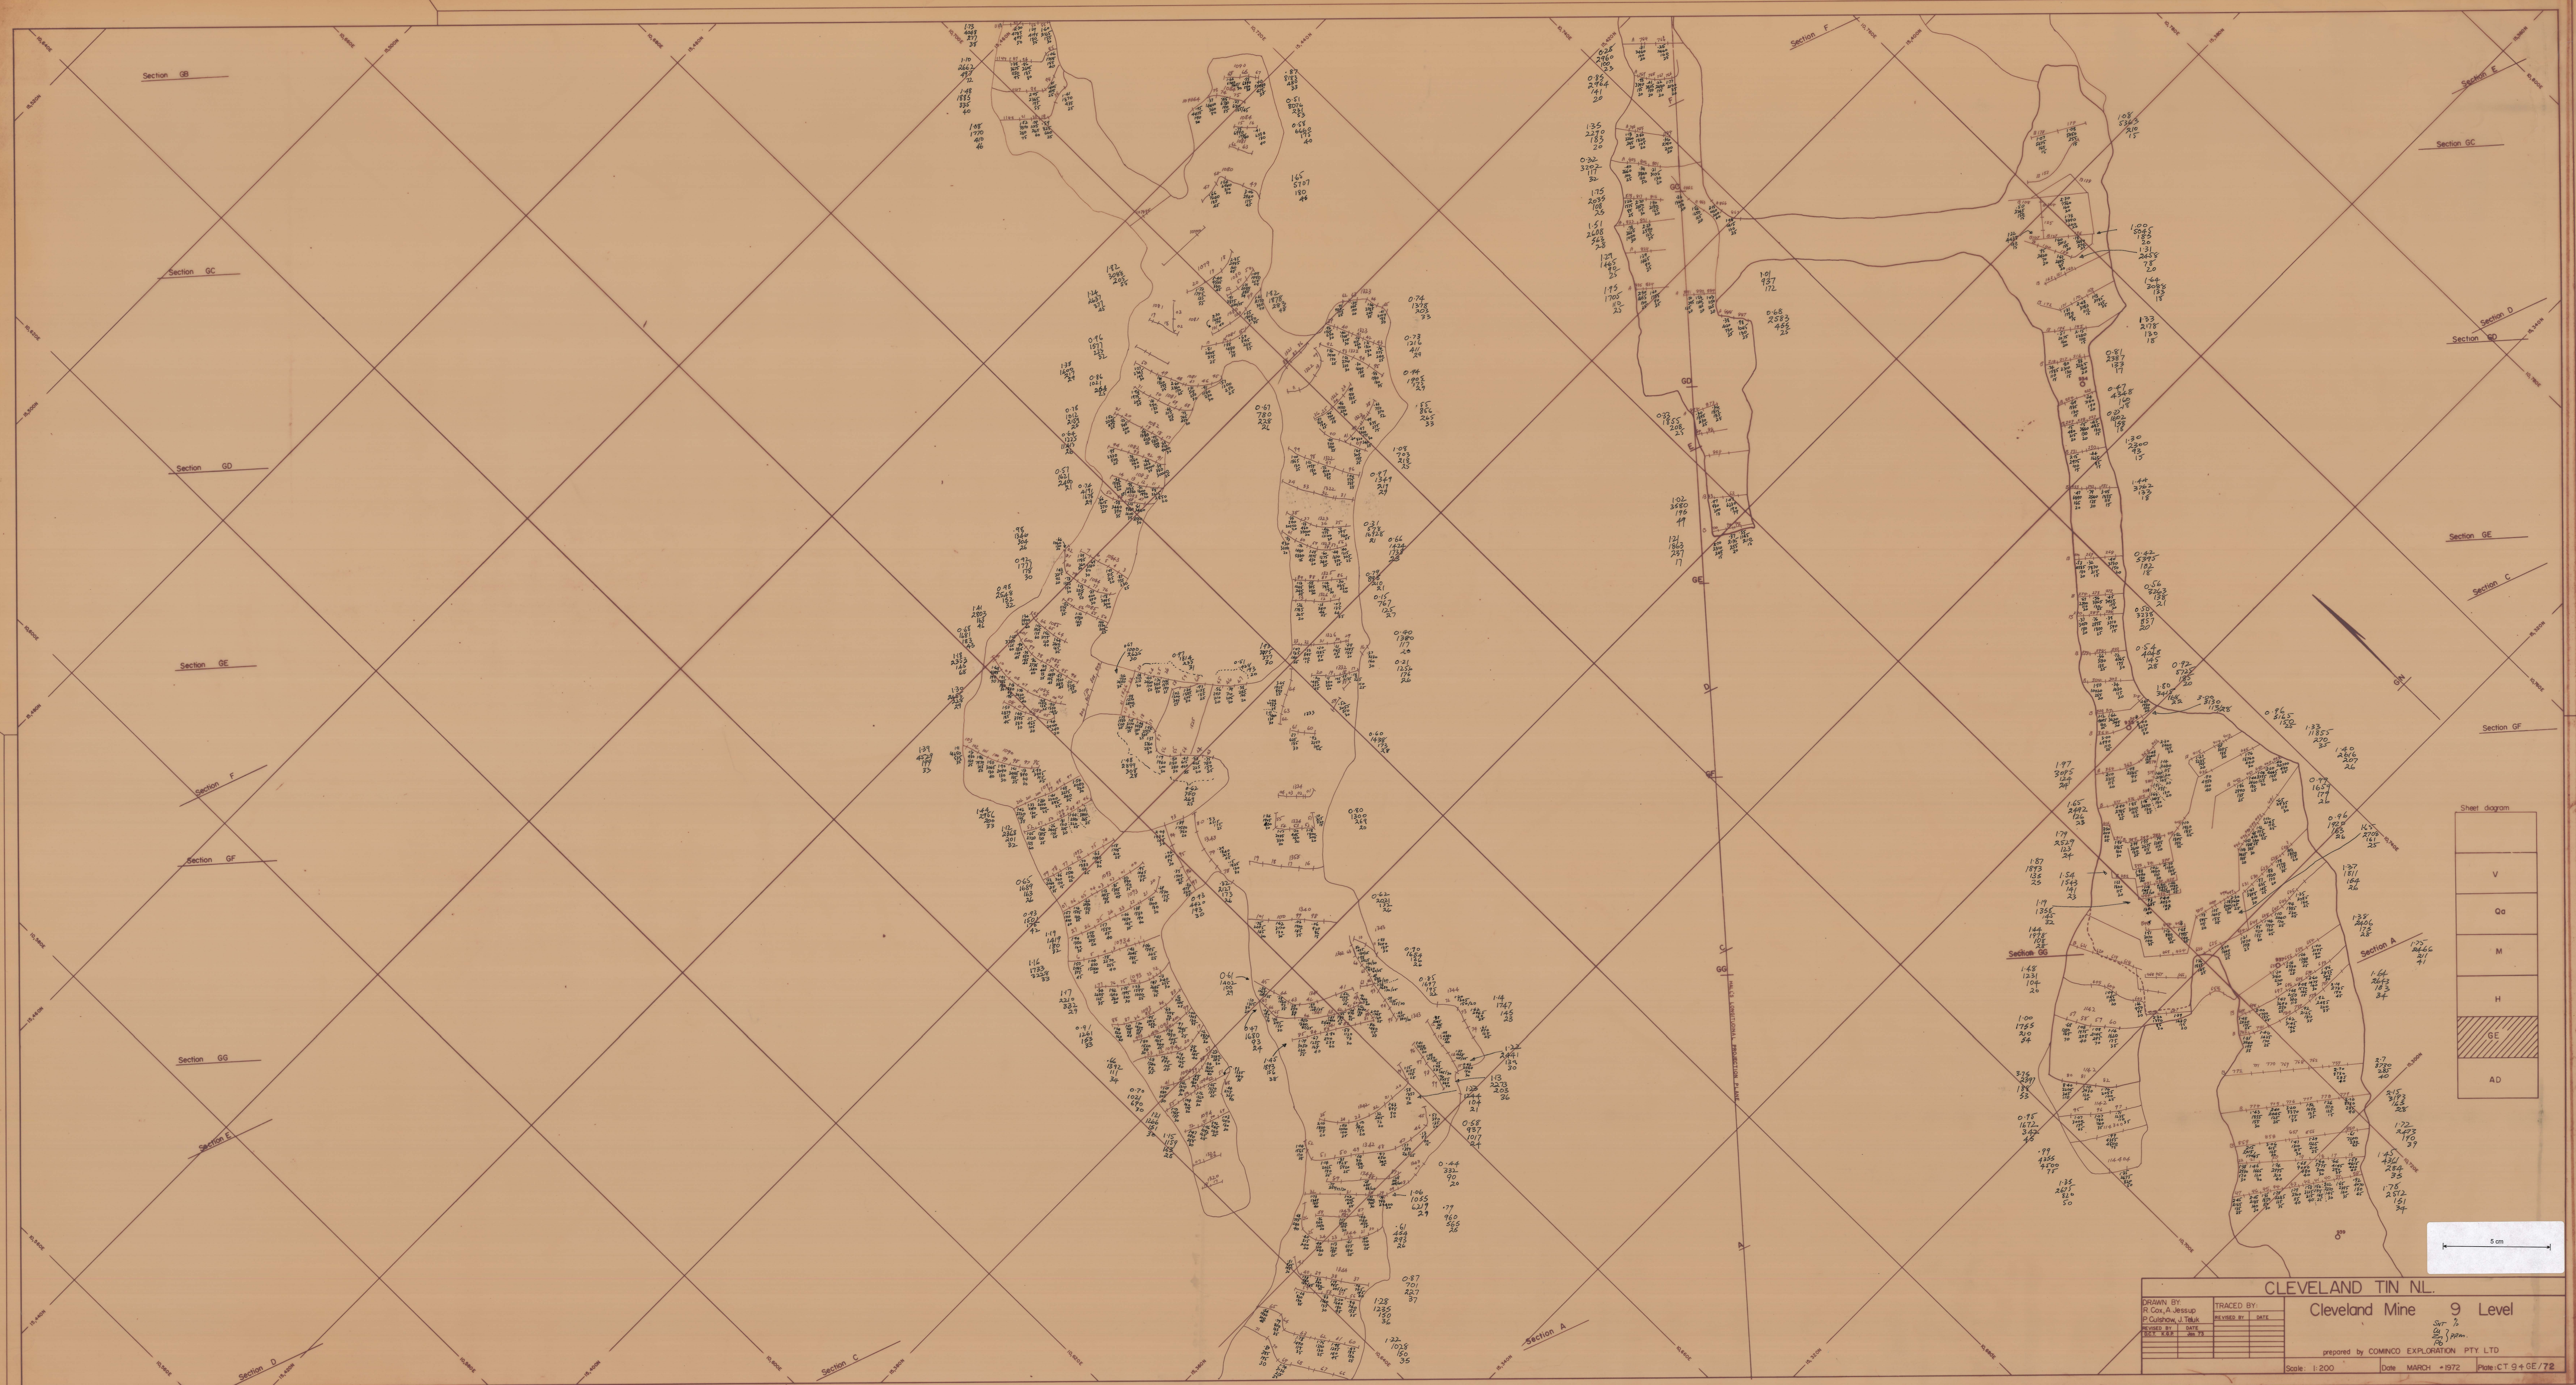

Sheet diagram

V
Qa
M
H
GE
AD

5m

CLEVELAND TIN NL.
Cleveland Mine 9 Level

DRAWN BY: R. Cox, A. Jessup P. Clouston, J. Tark CHECKED BY: J. Tark	TRACED BY: J. Tark
--	-----------------------

prepared by COMINCO EXPLORATION PTY LTD

Scale 1:200 Date MARCH 1972 Plate CT 9+GE/72