


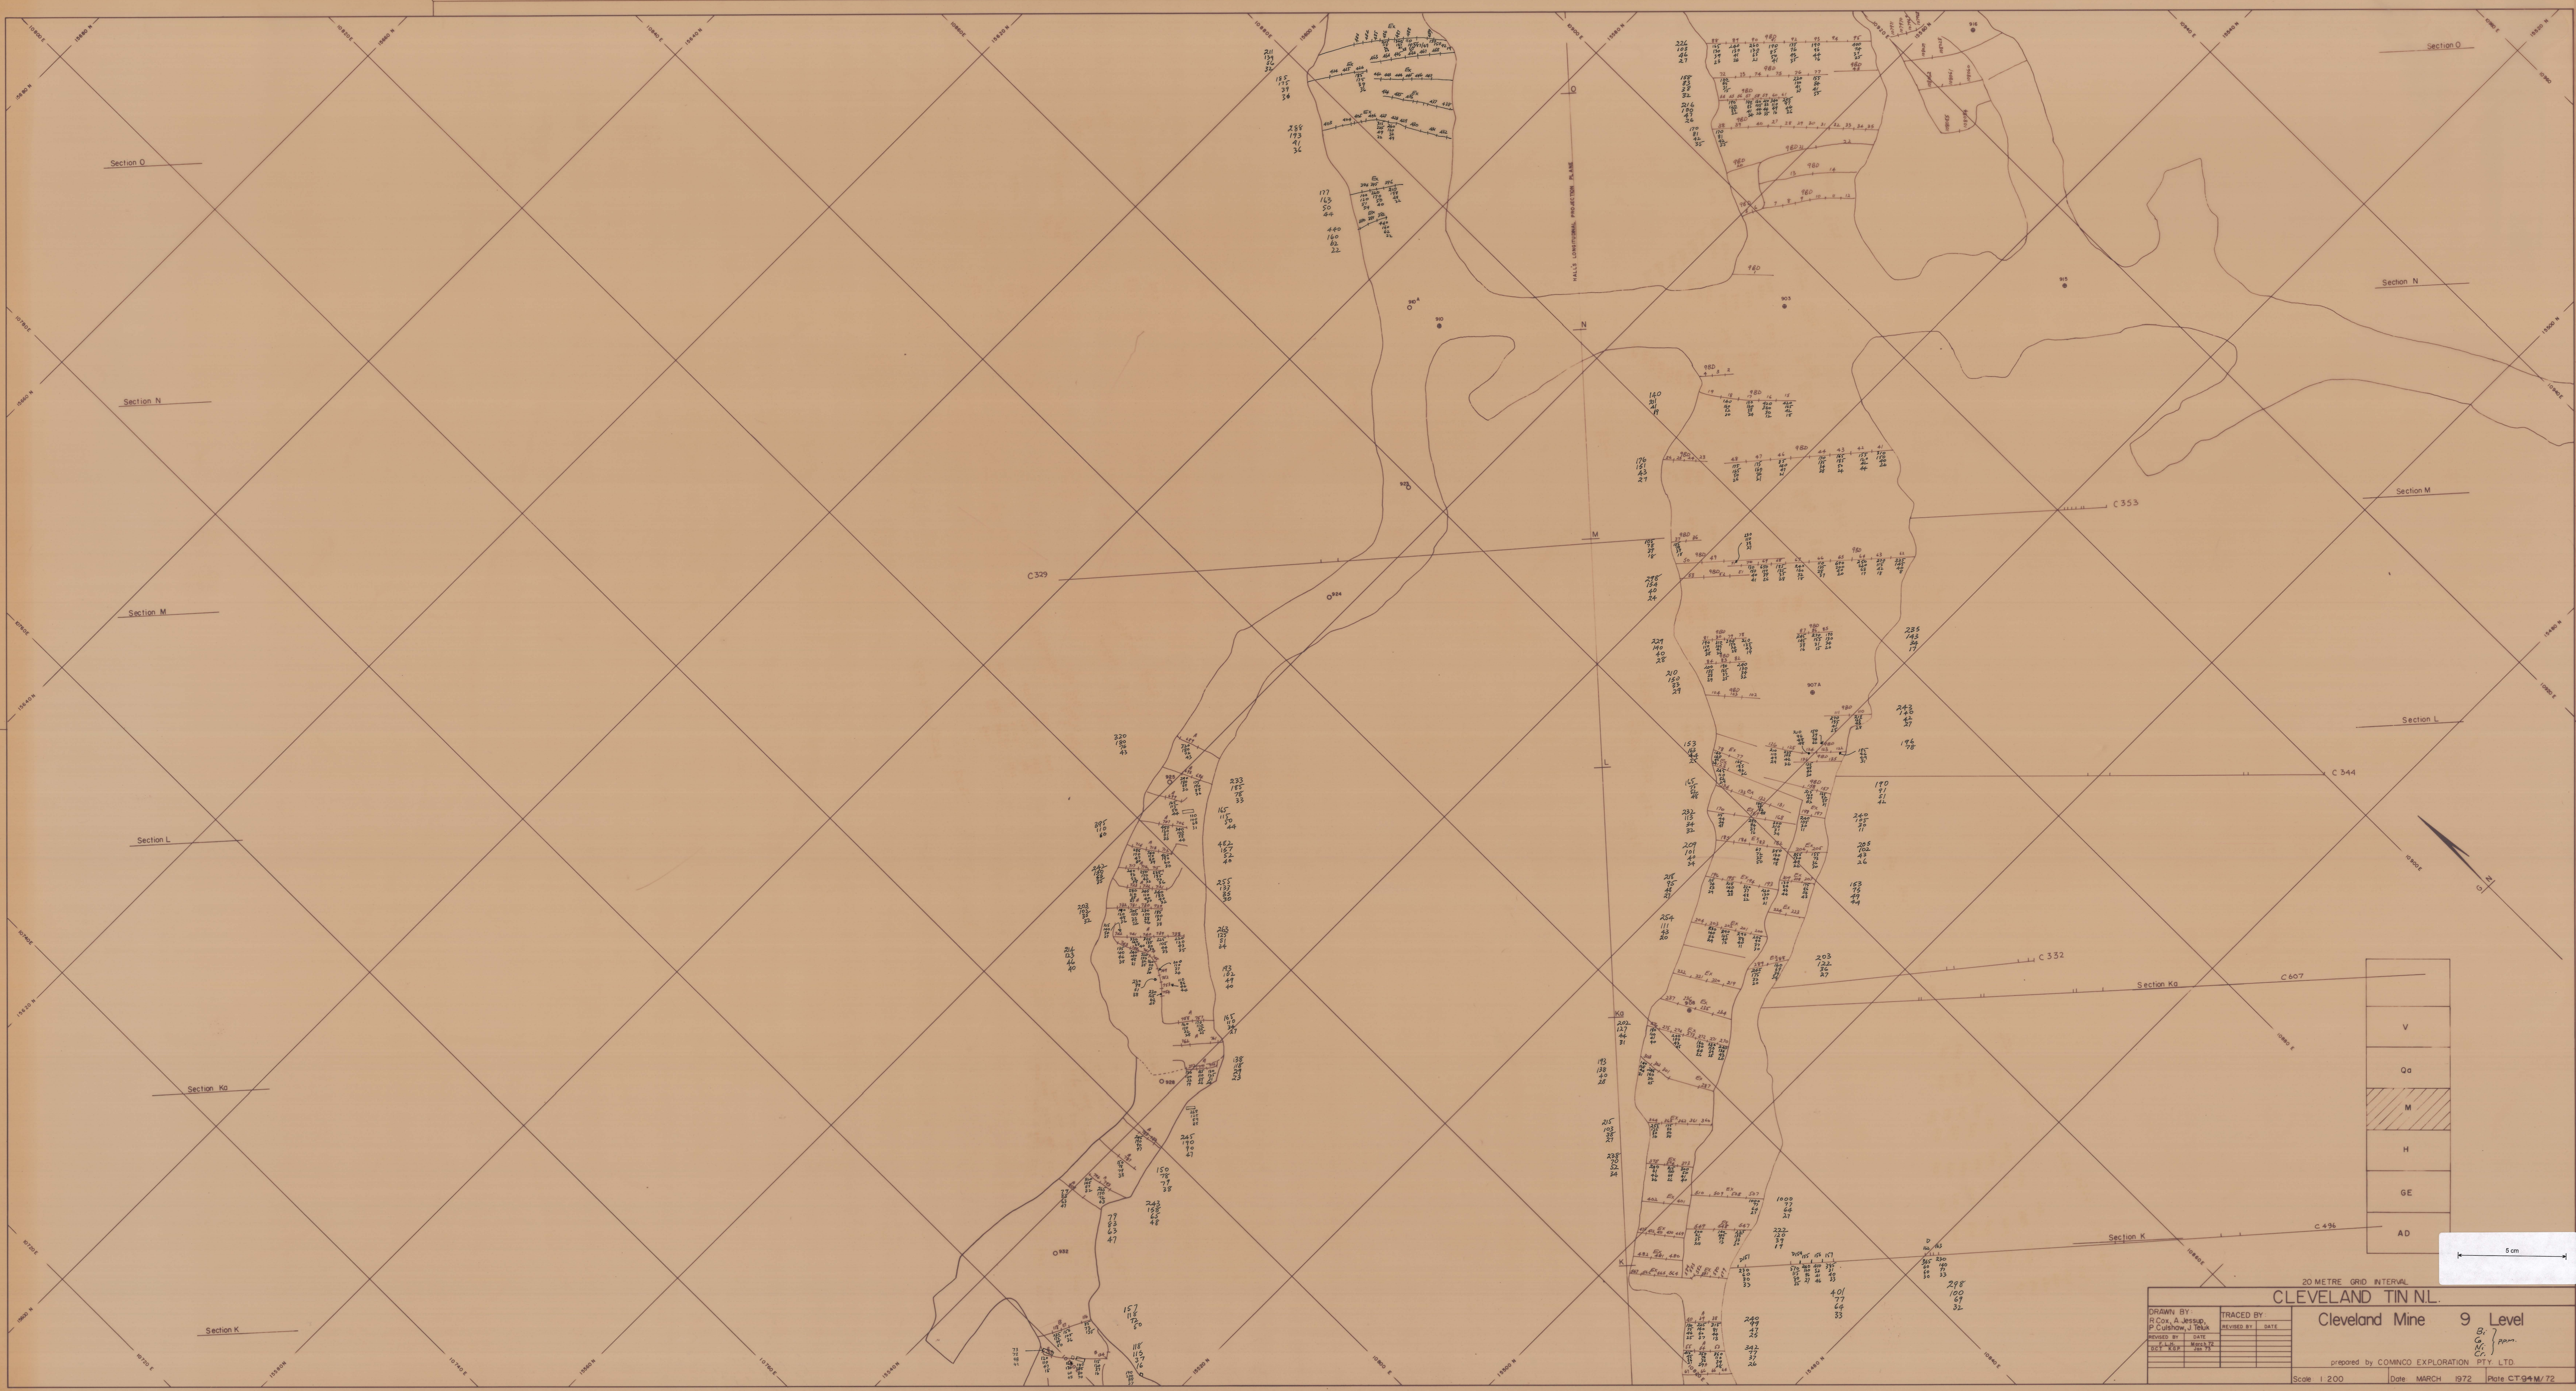

20 METRE GRID INTERVAL

**CLEVELAND TIN NL.**

Cleveland Mine 9 Level

prepared by COMINCO EXPLORATION PTY. LTD.

Scale 1:200 Date MARCH 1972 Plate CT-94M/72

| DRAWN BY:           |      | TRACED BY:  |      |
|---------------------|------|-------------|------|
| R. Cox, A. Jessup,  |      |             |      |
| P. Cushman, J. Teak |      |             |      |
| REVISED BY:         | DATE | REVISED BY: | DATE |
|                     |      |             |      |
|                     |      |             |      |
|                     |      |             |      |

0216.337