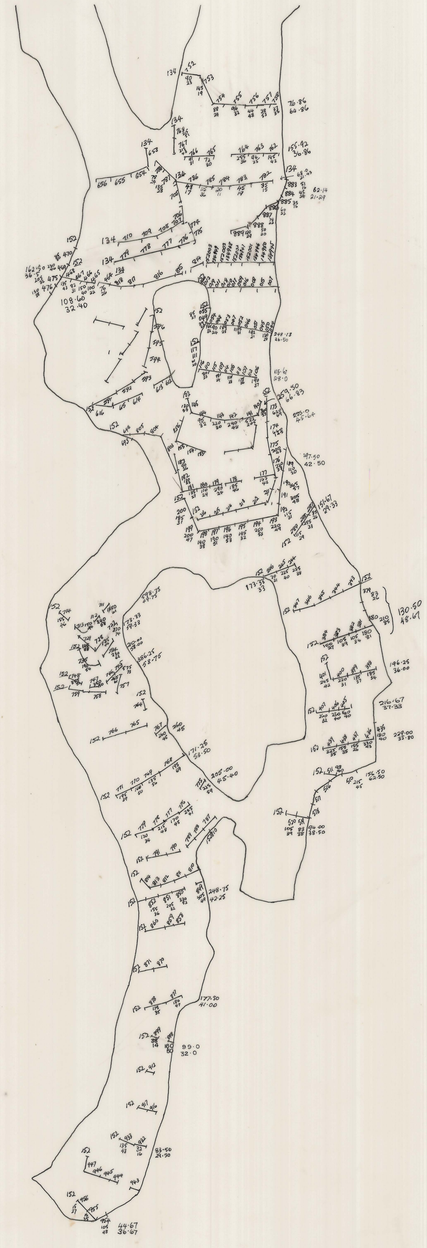

5 cm

Abminco Exploration

Geology:	**Cleveland Mine**	Location code:
Drawn:	**10 Level**	Date:
Traced:	Samples	Scale:
Checked:	Bi	Plate Nº
Revised by: Date:	Co	
	Sheet Ad	

0216_844