0216_854

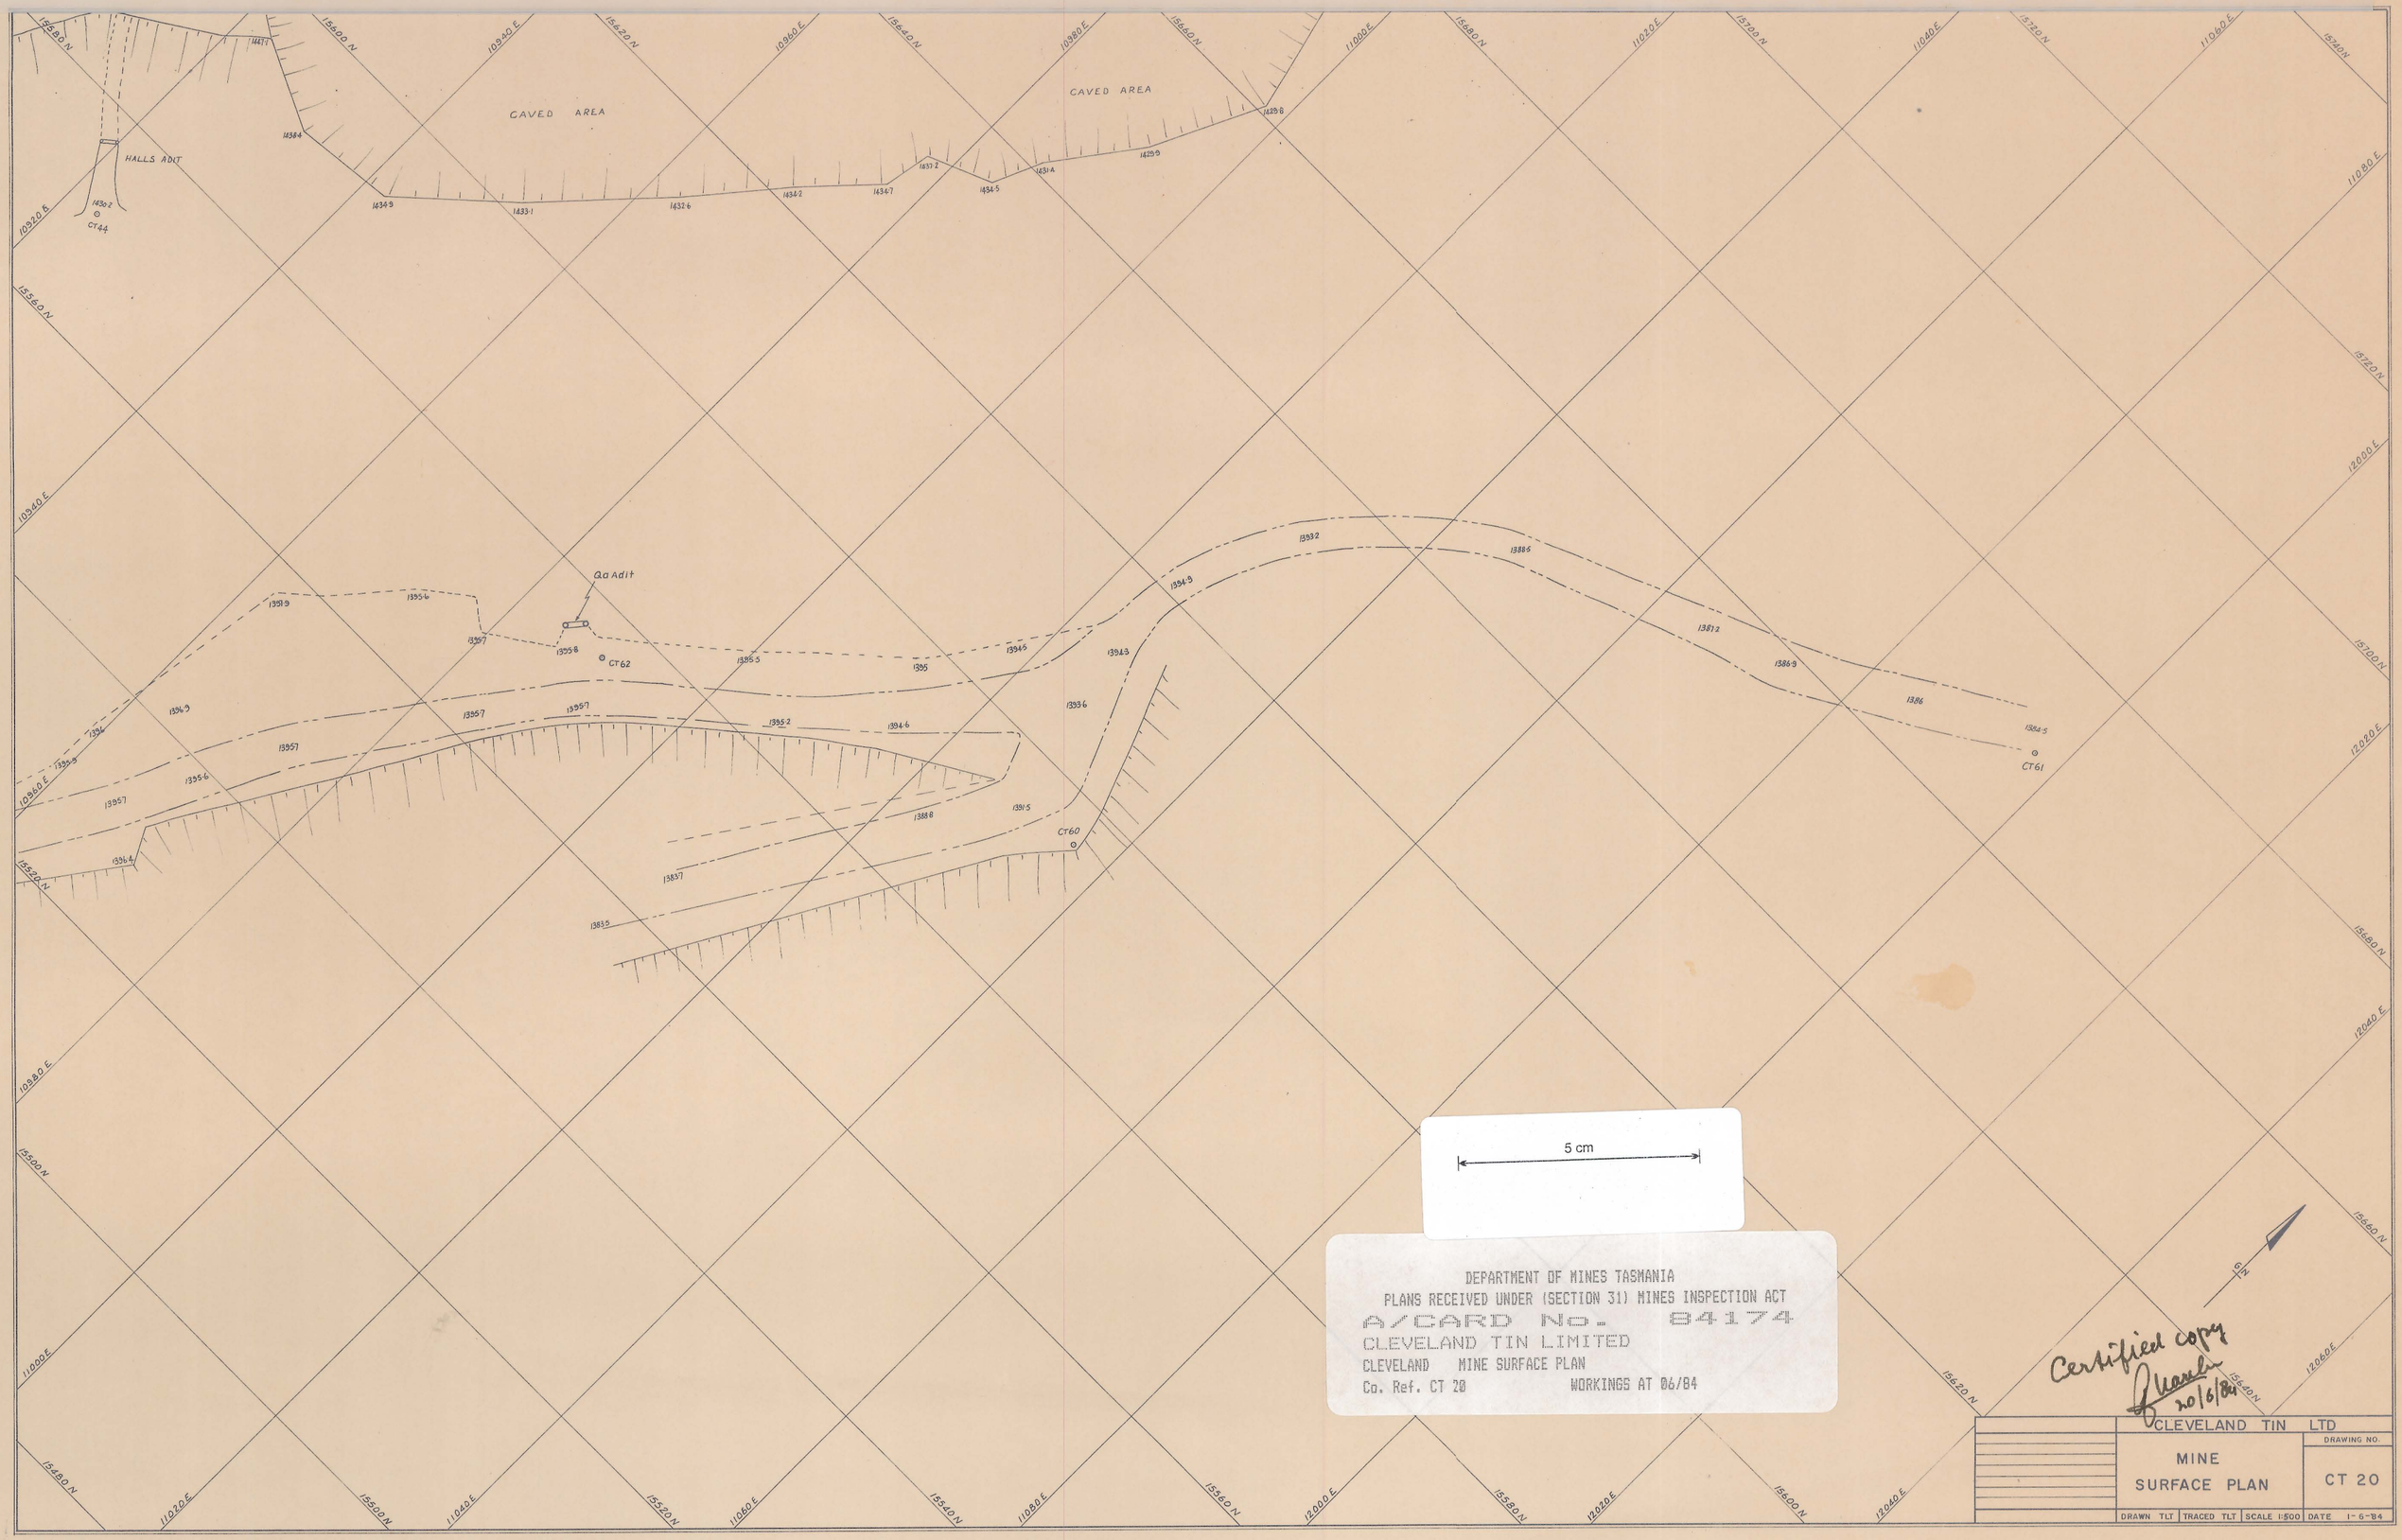
CAVED AREA
CAVED AREA
HALLS ADIT
CT44
Qa Adit
CT62
CT61
CT60
5 cm
DEPARTMENT OF MINES TASMANIA
PLANS RECEIVED UNDER (SECTION 31) MINES INSPECTION ACT
A/CARD No. 84174
CLEVELAND TIN LIMITED
CLEVELAND MINE SURFACE PLAN
Co. Ref. CT 20
WORKINGS AT 06/84
Certified copy
20/6/84
CLEVELAND TIN LTD
MINE
SURFACE PLAN
DRAWING NO.
CT 20
DRAWN TLT
TRACED TLT
SCALE 1:500
DATE 1-6-84