0216 - 855

5 cm

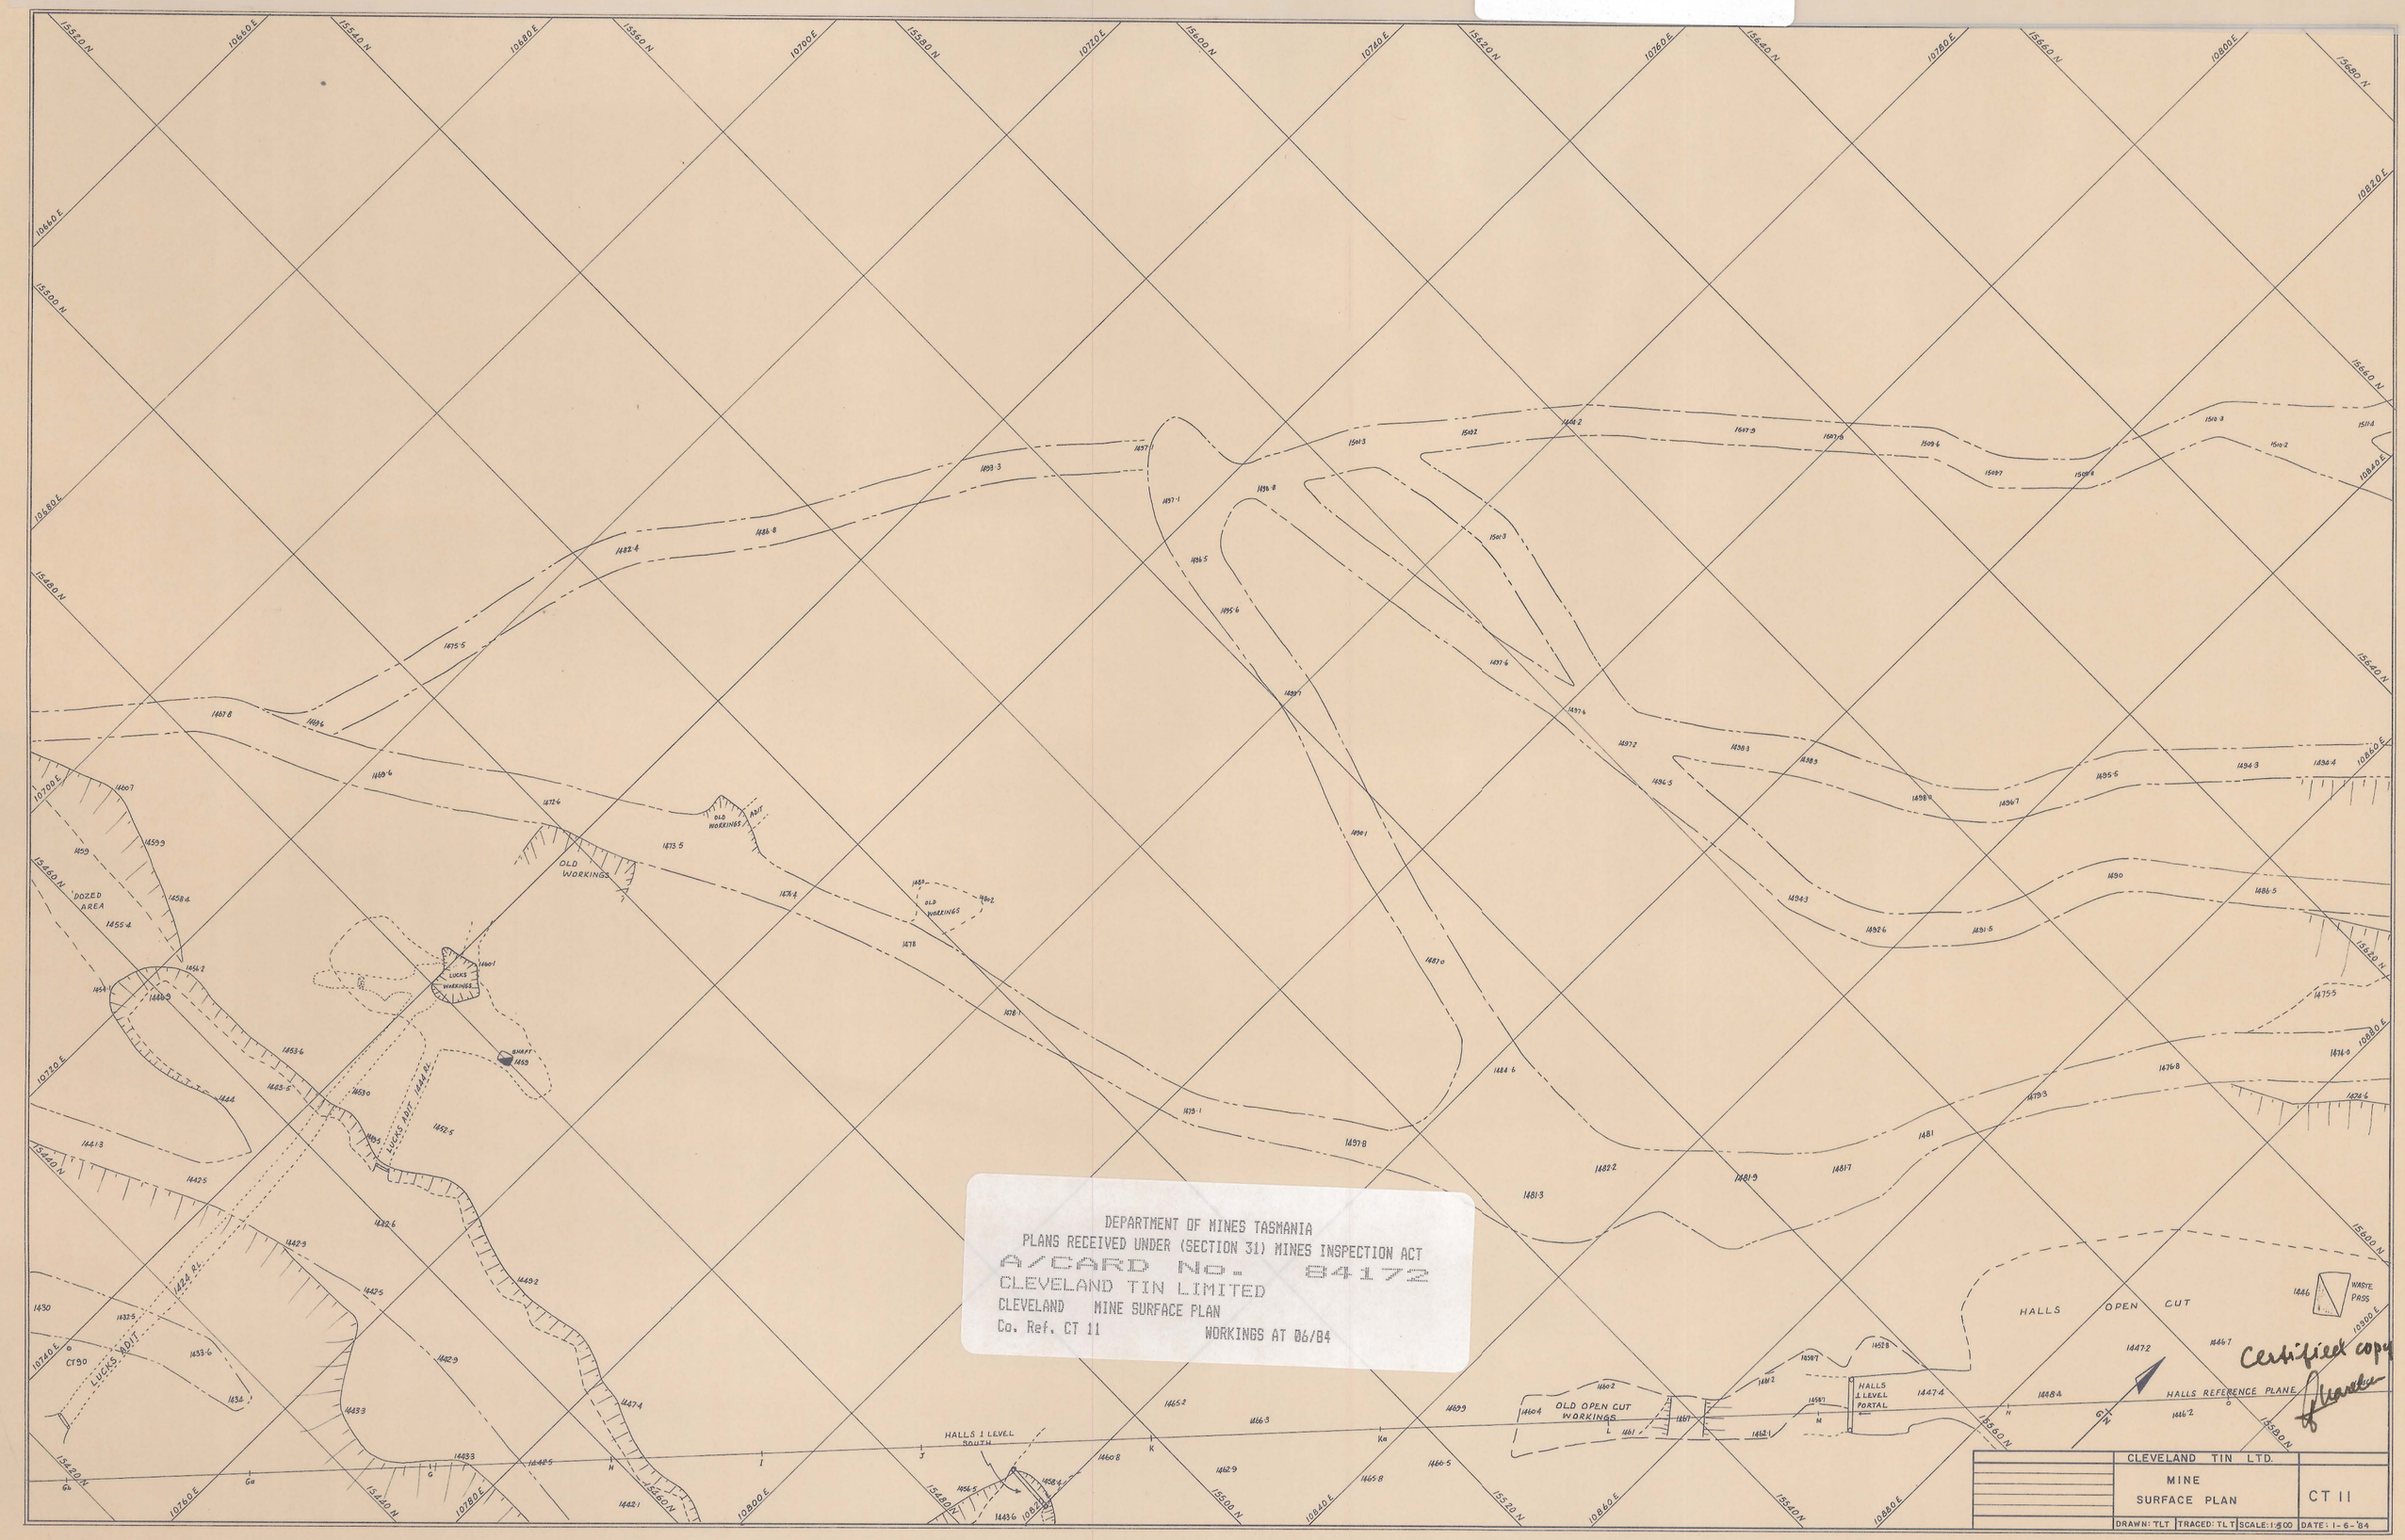

DEPARTMENT OF MINES TASMANIA
PLANS RECEIVED UNDER (SECTION 31) MINES INSPECTION ACT
A/CARD NO. 84172
CLEVELAND TIN LIMITED
CLEVELAND MINE SURFACE PLAN
Co. Ref. CT 11 WORKINGS AT 06/84

Certified copy