217-06

— Mt Bischoff T. M. Co Reg —

— No 1 NORTH EAST LODE —

— LONGITUDINAL SECTION —

— SCALE 25 FT TO 1 INCH —

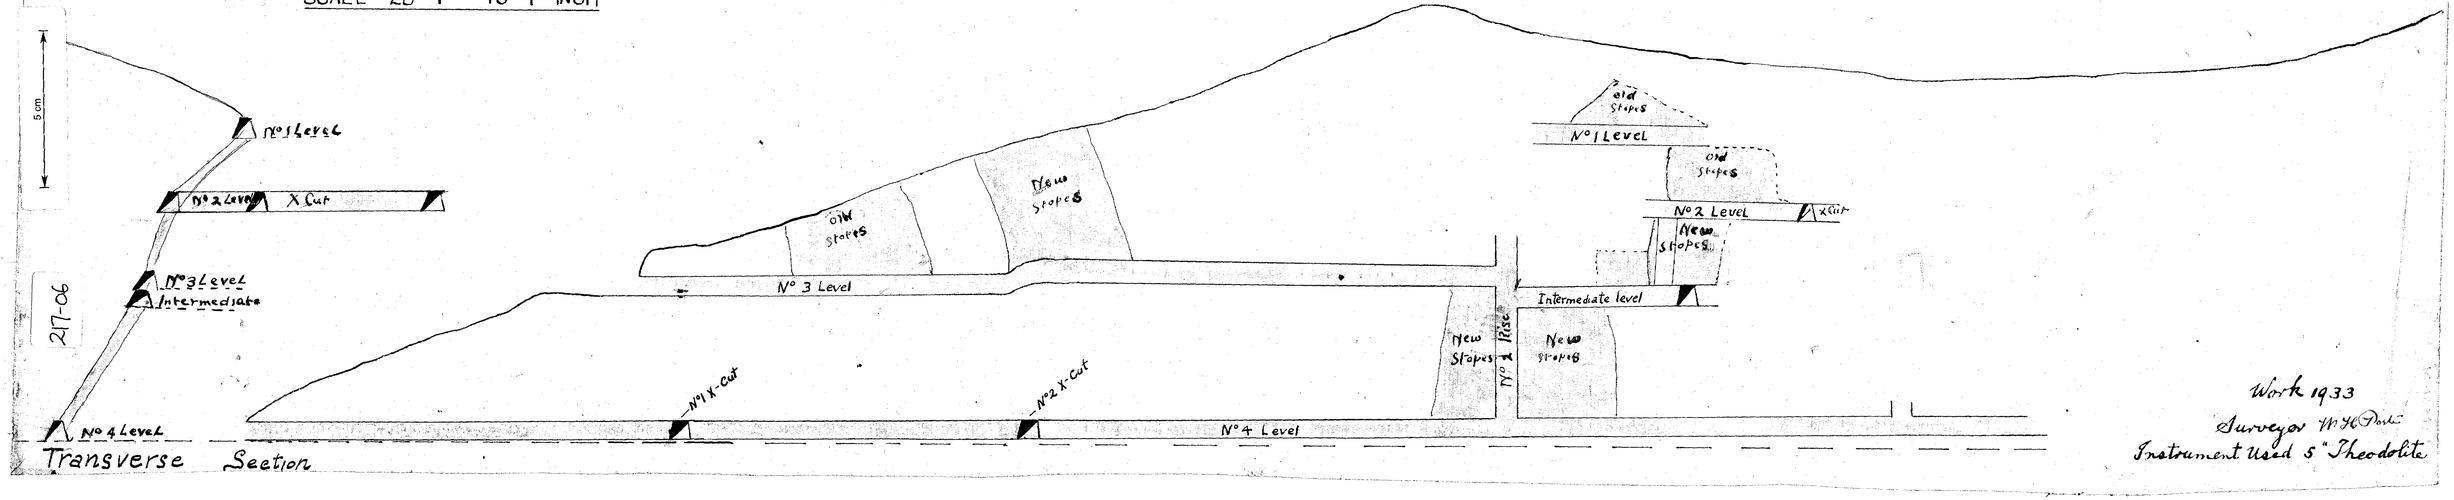

Transverse Section

Work 1933
Surveyor W H Park
Instrument Used 5" Theodolite

217-06