217-43

5 cm

217-43

# MT. BISCHOFF T.M CO REC.

## NORTH WEST LODE
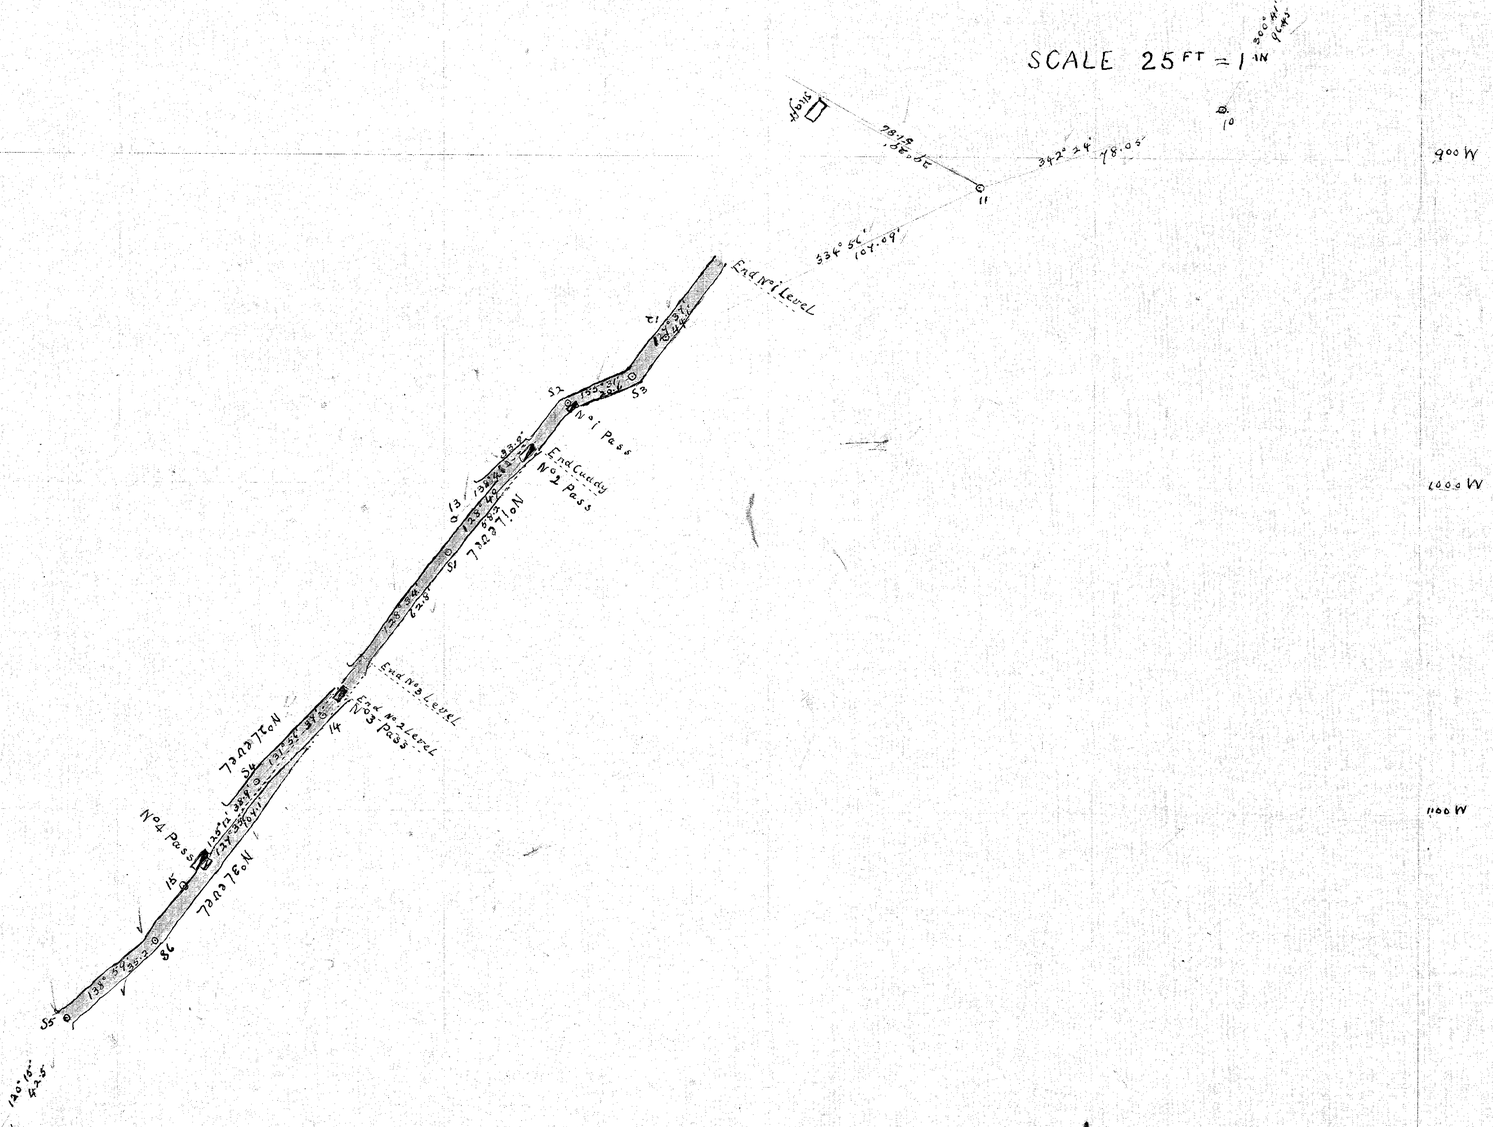
SCALE 25 FT = 1 IN