Mt Bischoff T. M. Co Reg.

HAPPY LODE

SCALE: 25 Ft TO 1 INCH

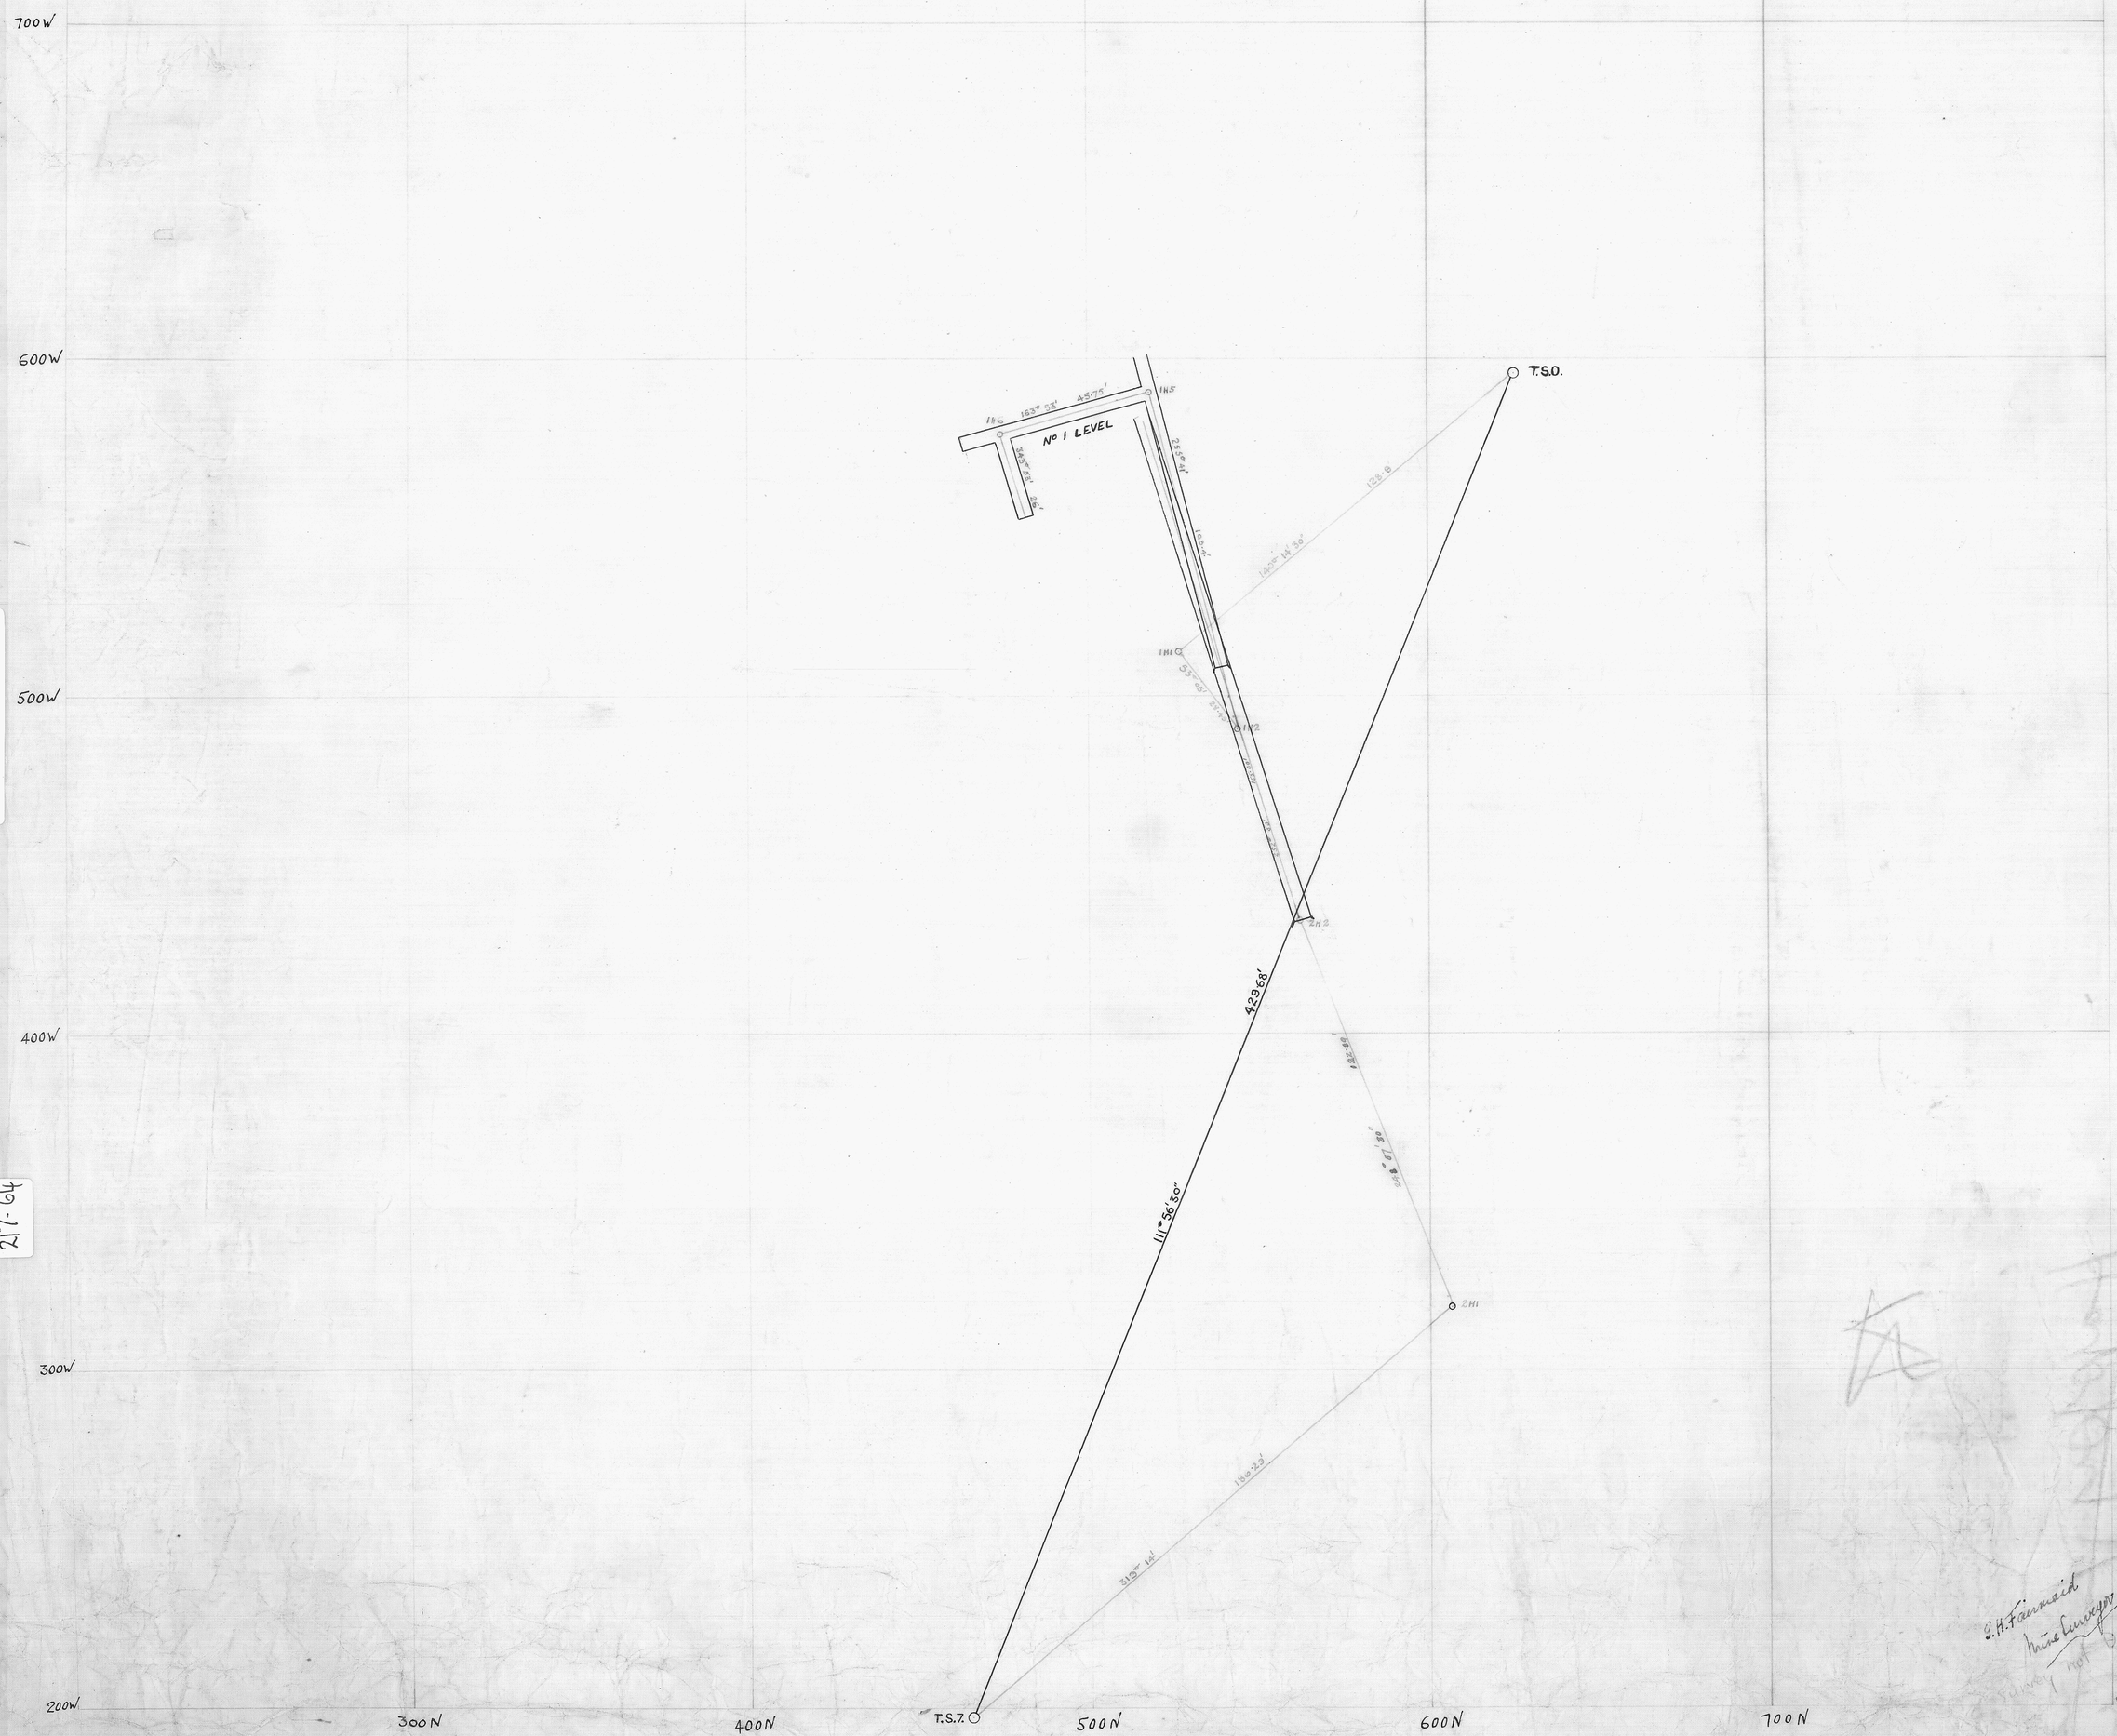

217-64

217-64

S.H. Fairnaid
Mine Surveyor
Plans not Belted
16-4-33

15-11-33