—MT BISCHOFF T. M. CO. REG.—

—HAPPY LODE—

SCALE 25 FT TO 1 INCH

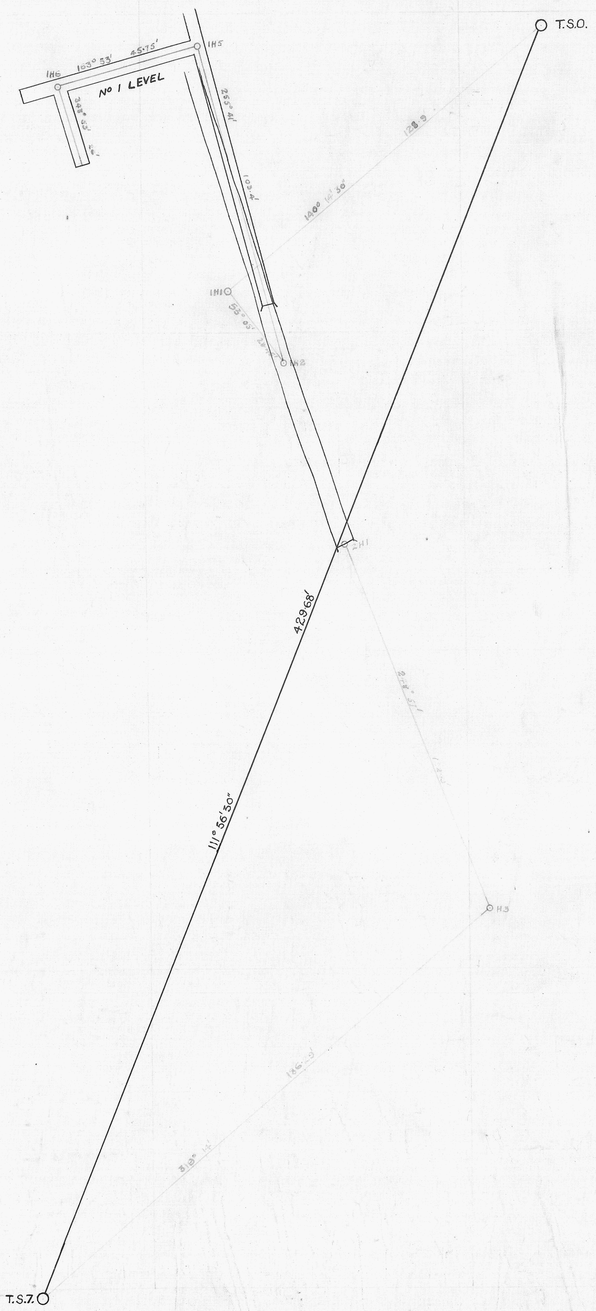

217-65

5 cm

217-65

W. Lawson
Gen Mining Mgr
16-4-23

Incorrect other plan received
15-11-23