


— SCALE: 25 FT TO 1 INCH —

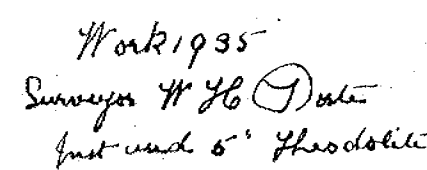

217-107