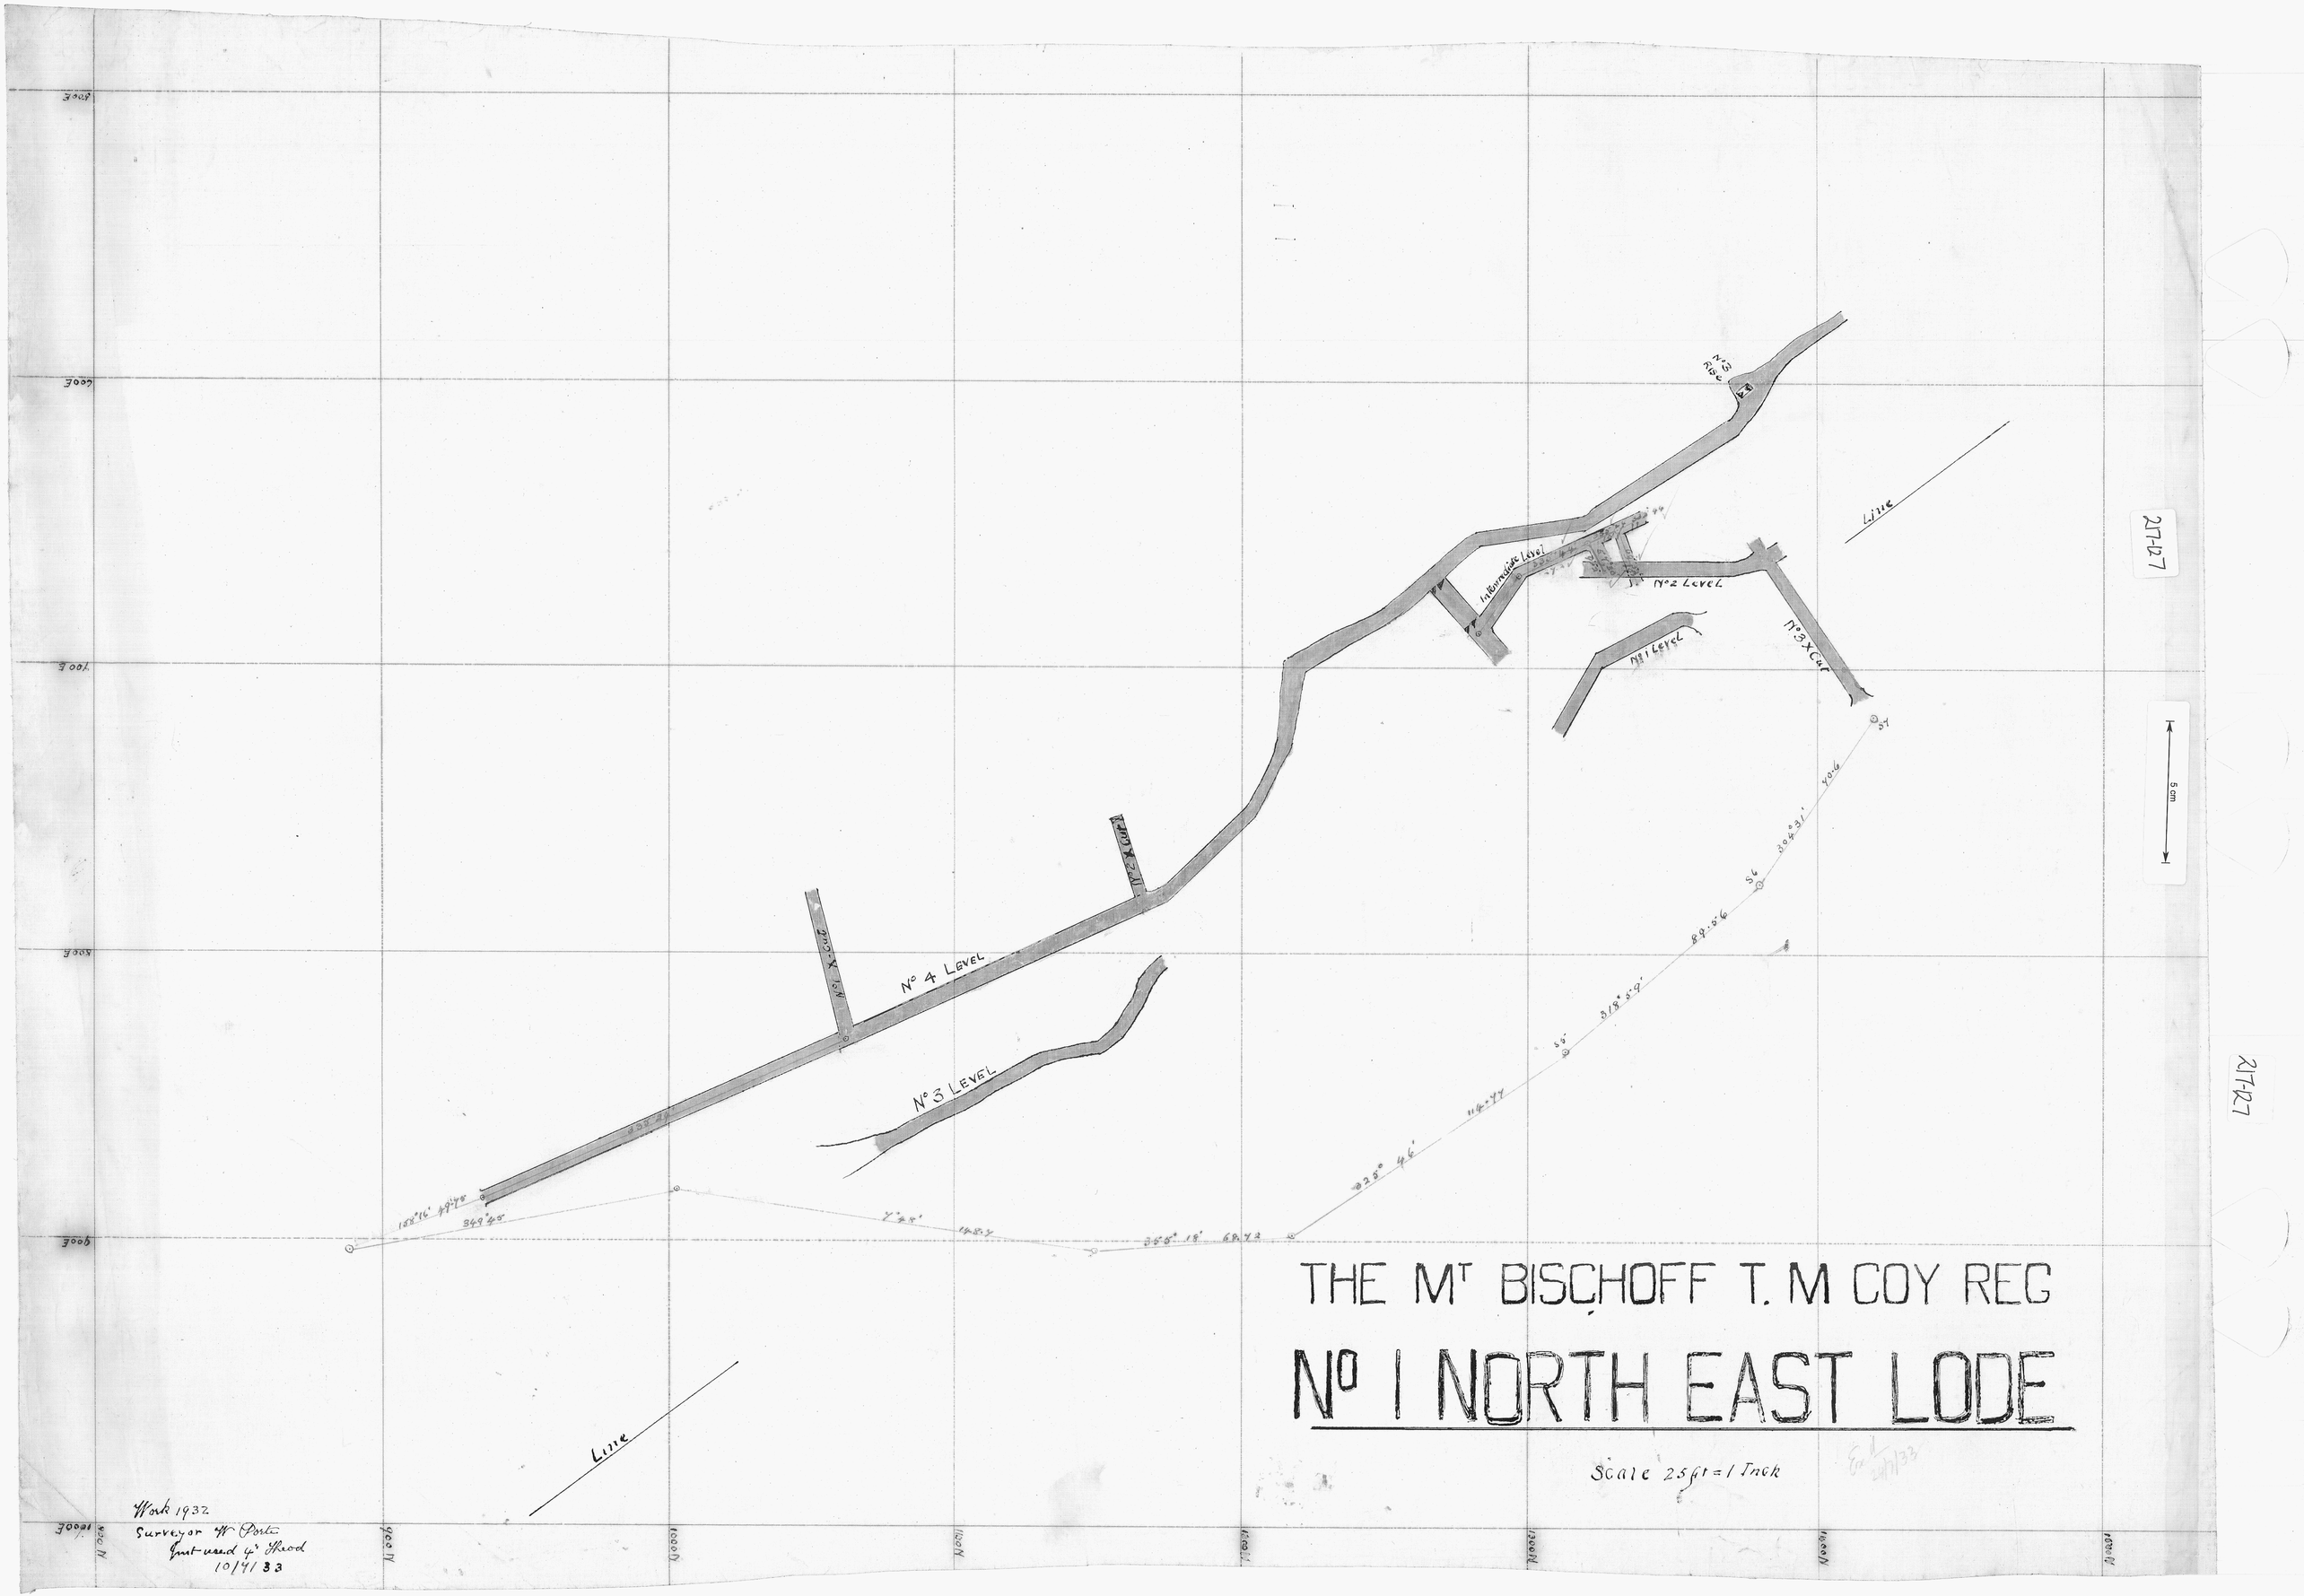
THE Mt BISCHOFF T. M COY REG
No 1 NORTH EAST LODE
Scale 25 ft = 1 Inch
No 4 Level
No 3 Level
No 2 Level
No 1 Level
No 3 X Cut
Intermediate Level
Line
Line
5 cm
217-127
217-127
Work 1932
Surveyor W Poste
Inst used 4" Theod
10/4/33