217-129

5 cm

217-129

THE Mt BISCHOFF T. M. COY. REG.

No 1 NORTH EAST LODE

SCALE: 25 Ft TO 1 INCH

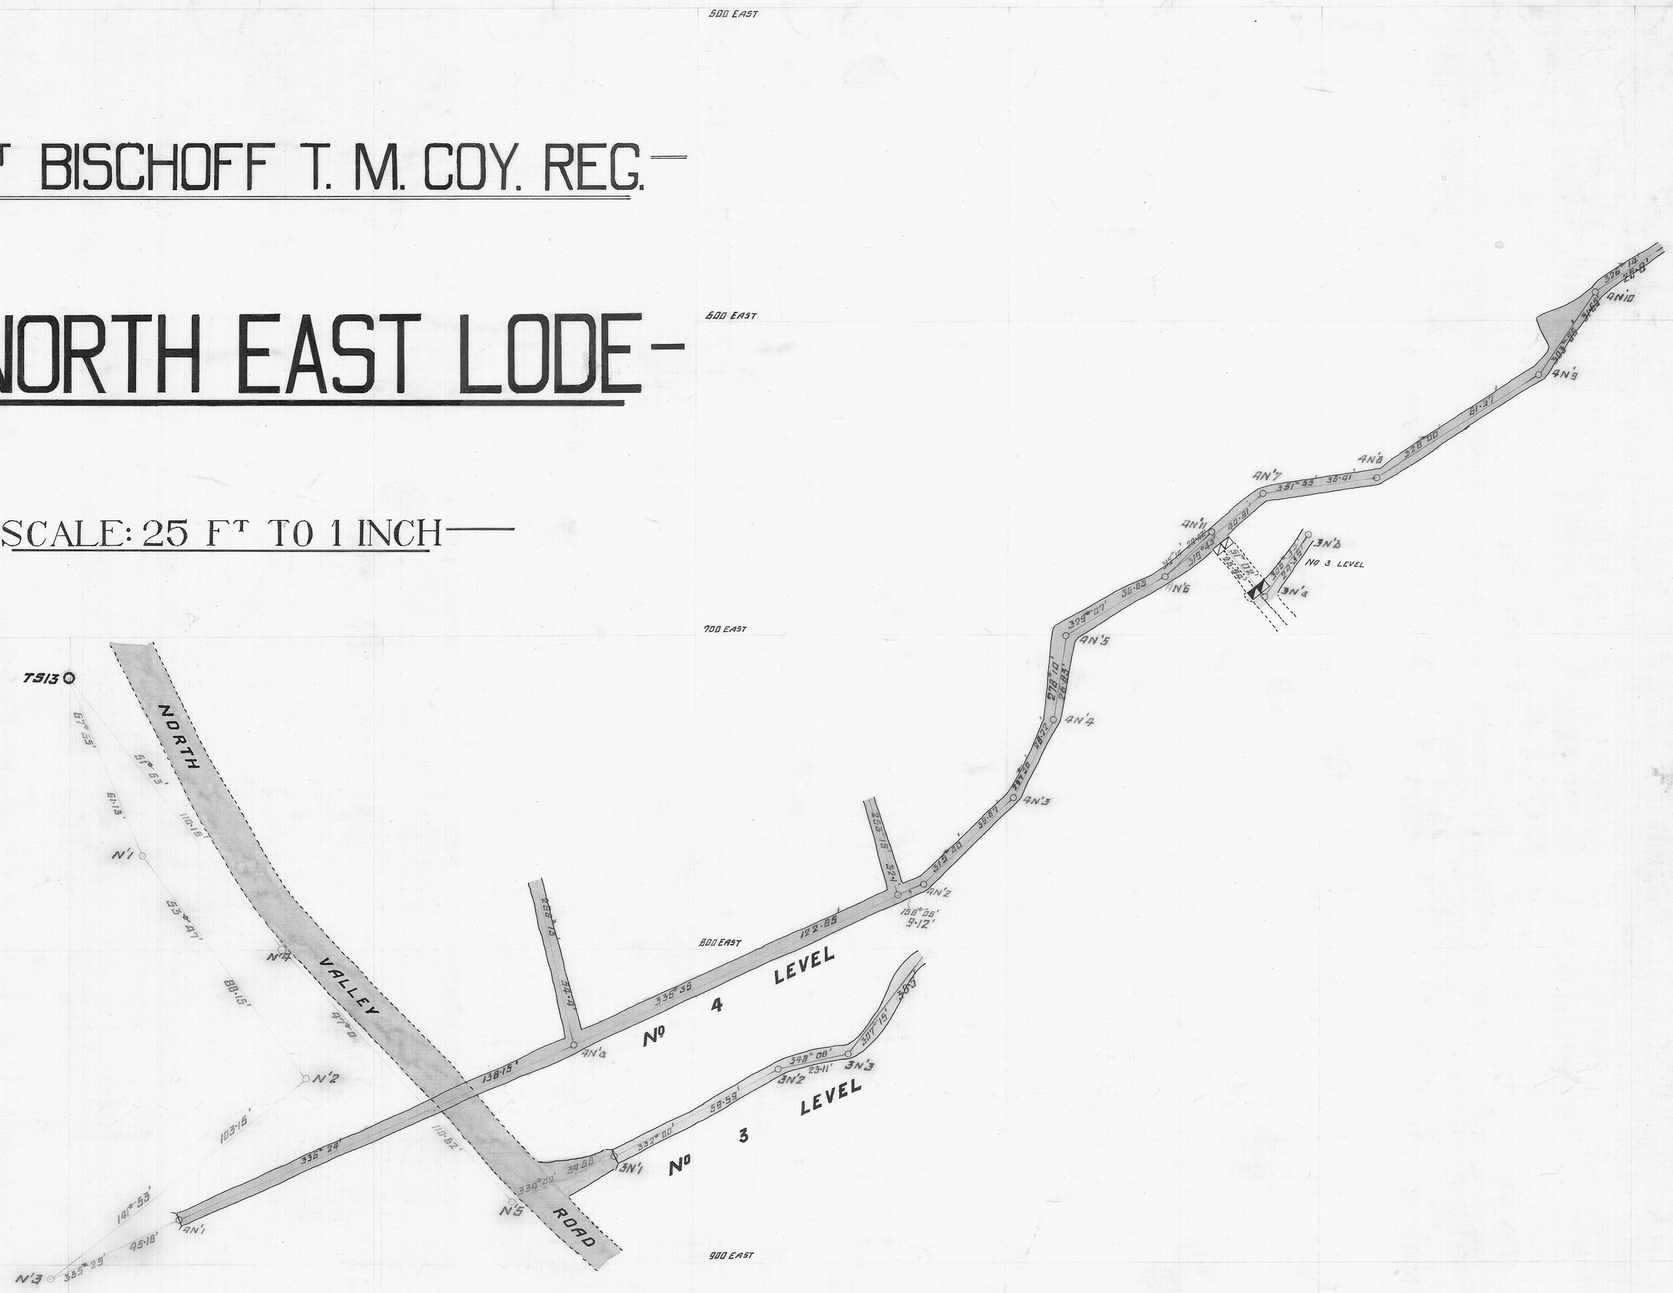

PLAN

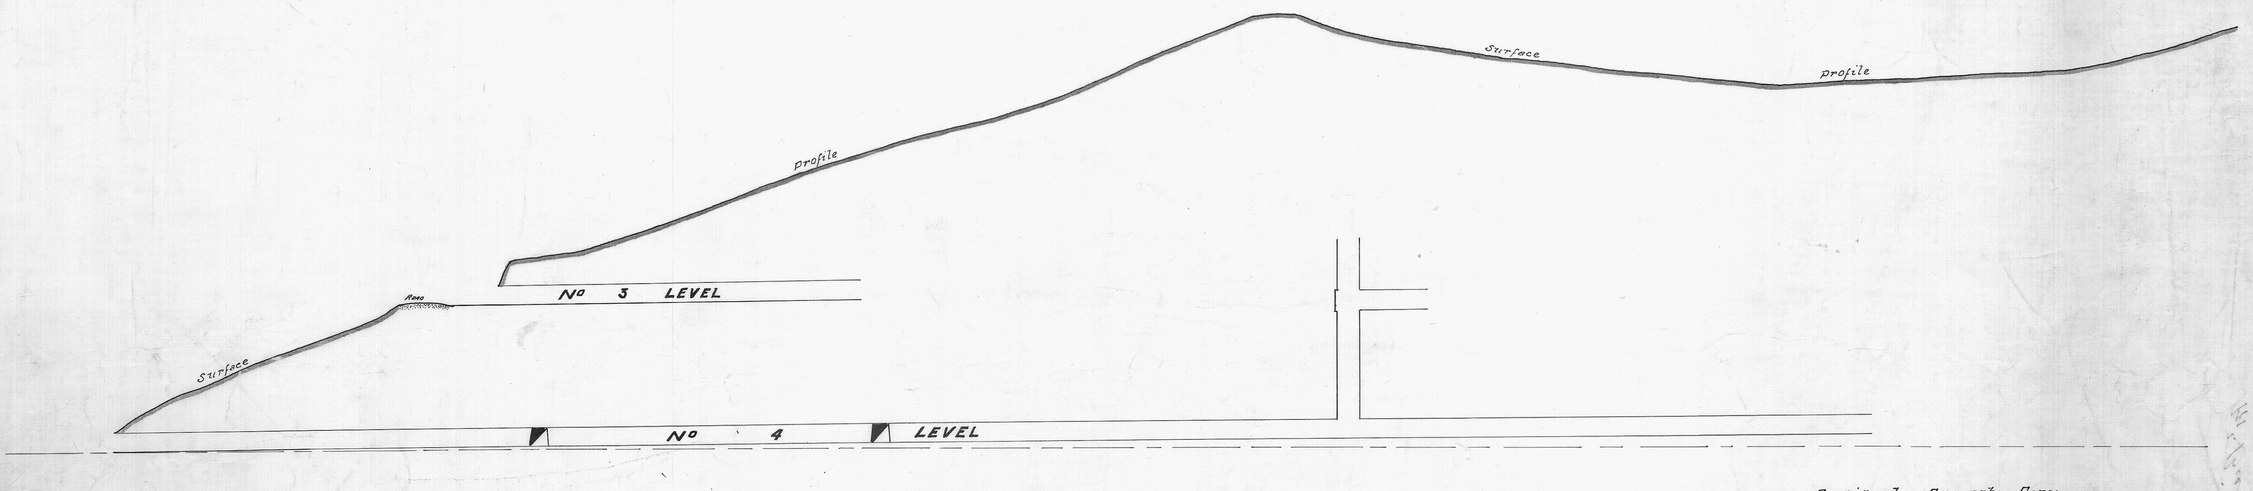

LONGITUDINAL SECTION

Certified Correct Copy
H Somerville Mine Surveyor
Lyal W Ludgrove General Mine Manager