


M^r BISCHOFF TIN MINING C^o REG.

PLAN OF UNDERGROUND WORKINGS FOR YEAR 1908

SCALE 50 FT = 1 INCH

R. A. Hall
Mining Engineer
2nd 2-09

Sheet 2

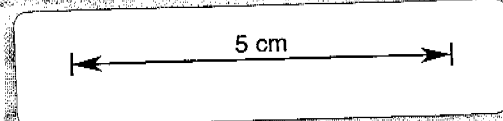

Ed. 3.3.C.

101